


PARENT PARCEL: 02-01-004-101-048, -049, -050, -051


21-04572-C

CHILD PARCEL:

STARTING POINT:

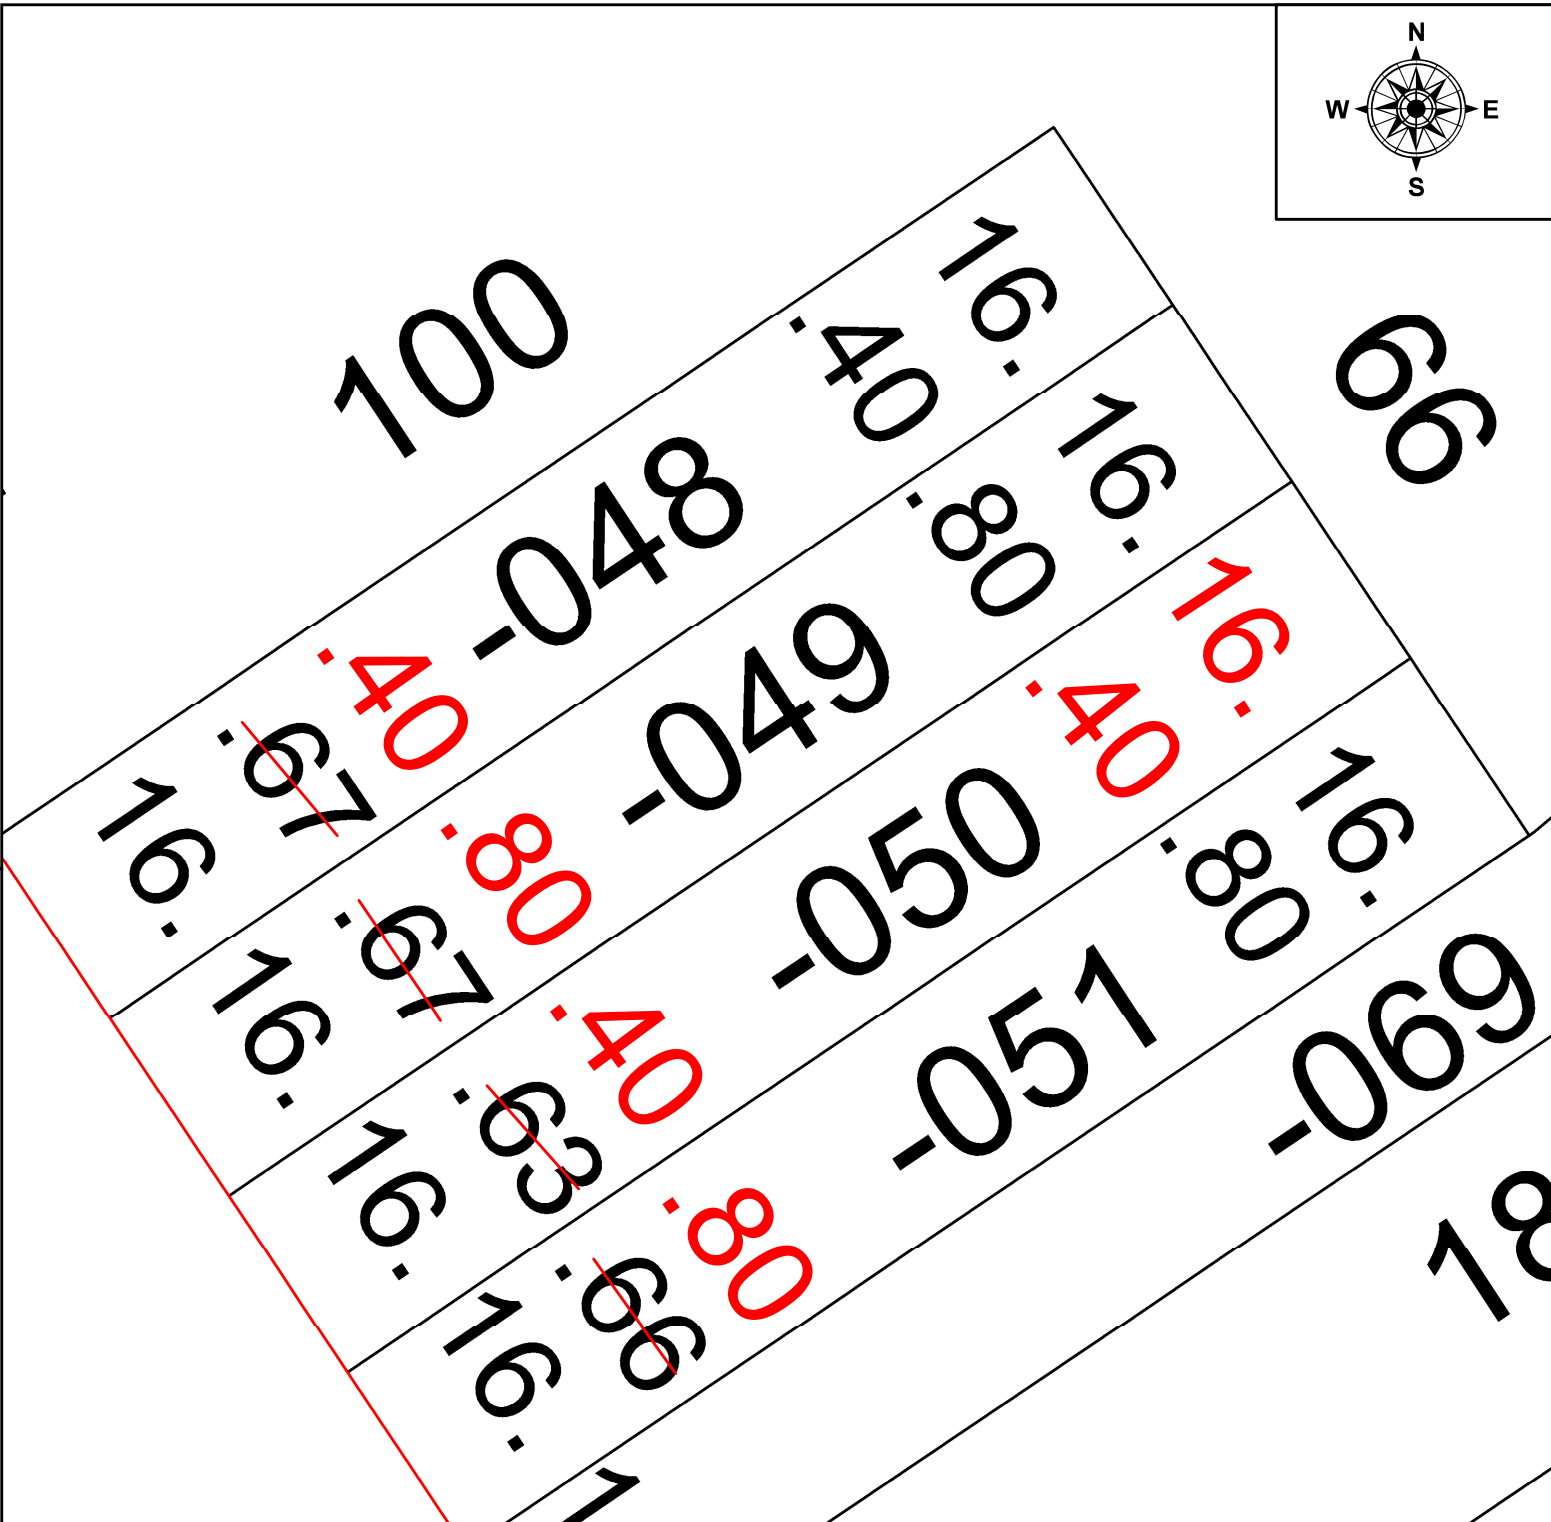

MAP CORRECTION ONLY

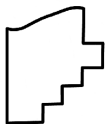

SPLITS/DEEDS PROCESSED
LORAIN COUNTY TAX MAP DEPARTMENT
226 MIDDLE AVE. ELYRIA, OH

SURVEYED BY: _____ N/A
CLOSURE: _____ N/A
MAP PAGE(S): 02-01-004
APPROVED BY: _____ WRZ DATE: 5-24-21
SCALE: 1" = 15' PRIOR INSTRUMENT: 1996-0440566