
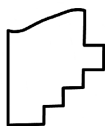


PARENT PARCEL: 01-00-034-000-026

CHILD PARCEL: XX-XX-XXX-XXX-XXX

STARTING POINT: CL OF VERMILION RD. & NORTH LINE OF GEORGE RUSSELL DV 328 PG 280

21-04574-A

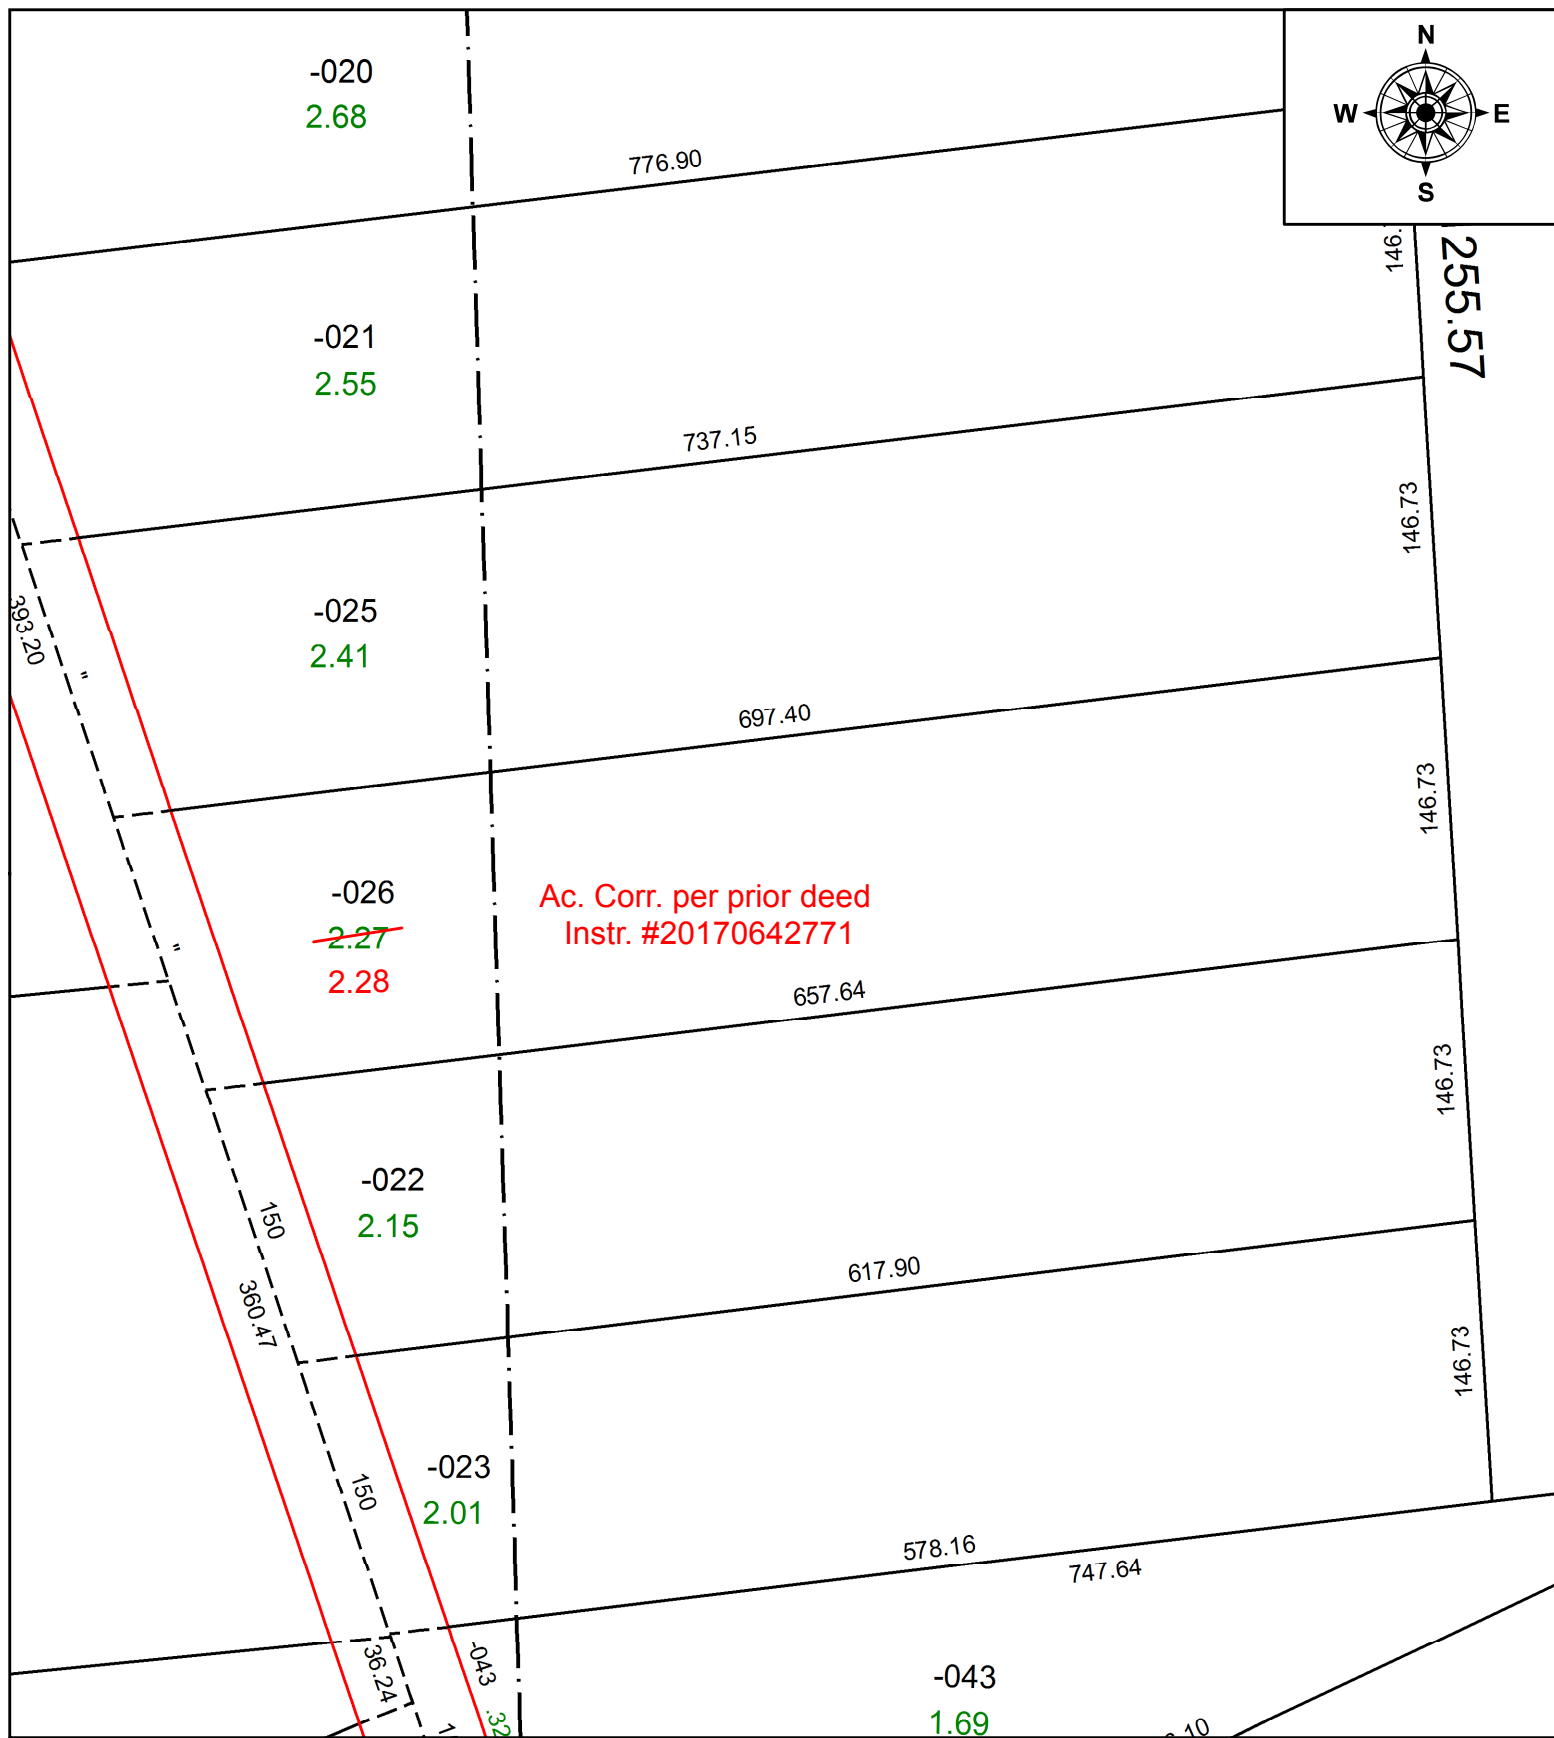

**SPLITS/DEEDS PROCESSED**  
 LORAIN COUNTY TAX MAP DEPARTMENT  
 226 MIDDLE AVE. ELYRIA, OH

SURVEYED BY: XXXXXXXX  
 CLOSURE: 1: 84064  
 MAP PAGE(S): 01-00-034  
 APPROVED BY: DMA DATE: 5/27/2021  
 SCALE: 1" = 100 PRIOR INSTRUMENT: INSTR. 2017-0642771