


PARENT PARCEL: 06-23-008-103-011


CHILD PARCEL: \_\_\_\_\_

STARTING POINT: SE CORNER OF FRANK YUHAS SUBDIVISION RECORDED IN VOLUME 22, PAGE 56

21-04576-A

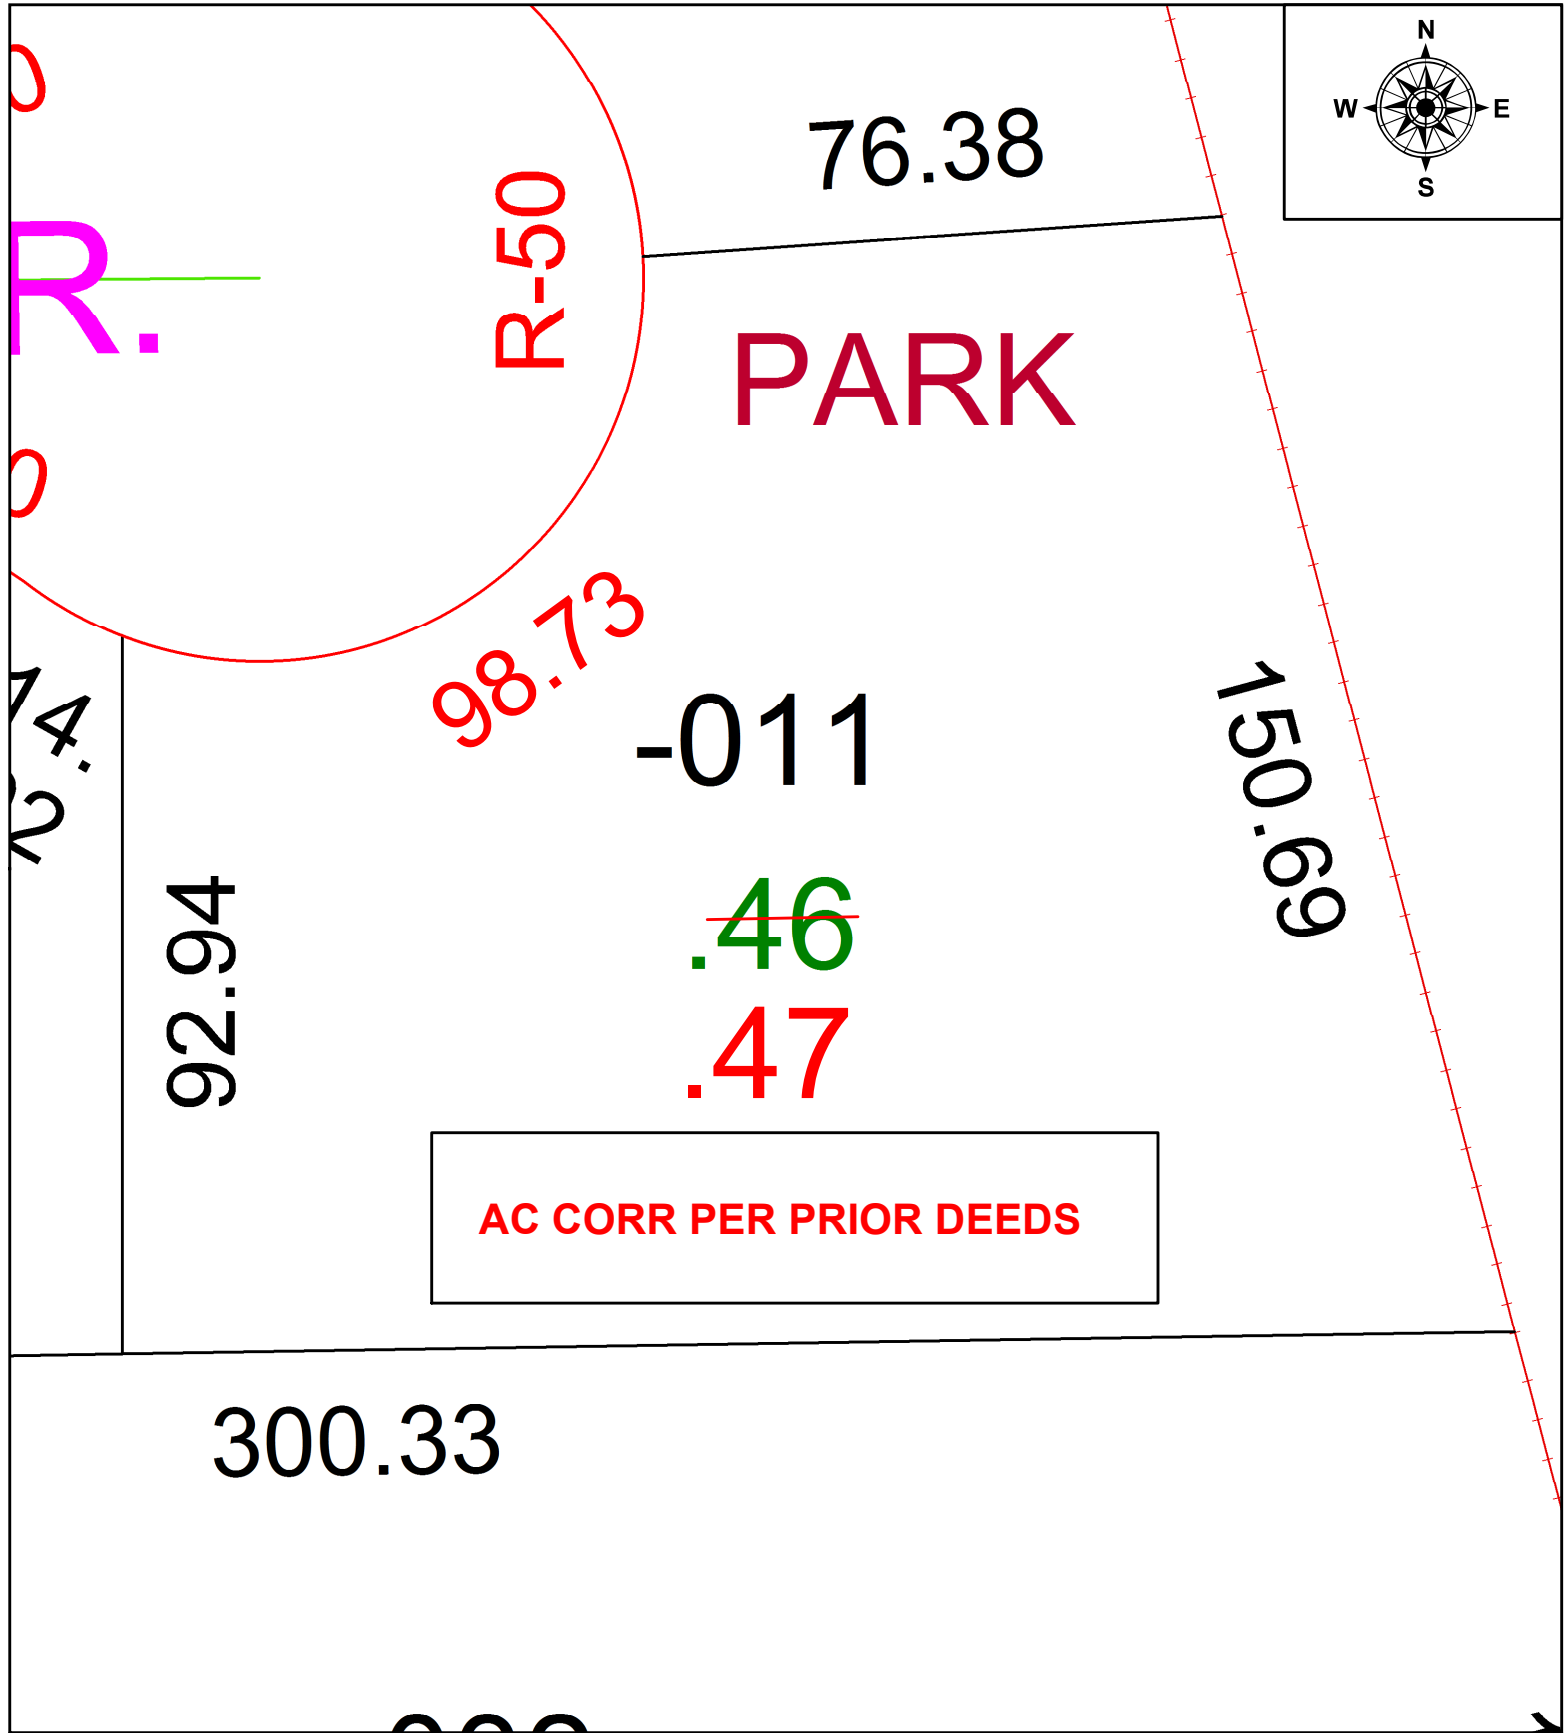

AC CORR PER PRIOR DEEDS

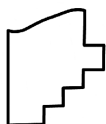

**SPLITS/DEEDS PROCESSED**  
LORAIN COUNTY TAX MAP DEPARTMENT  
226 MIDDLE AVE. ELYRIA, OH

SURVEYED BY: \_\_\_\_\_ N/A  
CLOSURE: \_\_\_\_\_ 1: 290363  
MAP PAGE(S): \_\_\_\_\_ 06-25  
APPROVED BY: \_\_\_\_\_ AC DATE: \_\_\_\_\_ 6/3/2021  
SCALE: \_\_\_\_\_ 1" = 25 \_\_\_\_\_ PRIOR INSTRUMENT: \_\_\_\_\_ 2019-0712815