


PARENT PARCEL: 04-00-023-113-012

CHILD PARCEL: _____

STARTING POINT: C/L OF RIEGELSBERGER RD AND KENSINGTON DR

21-04577-C

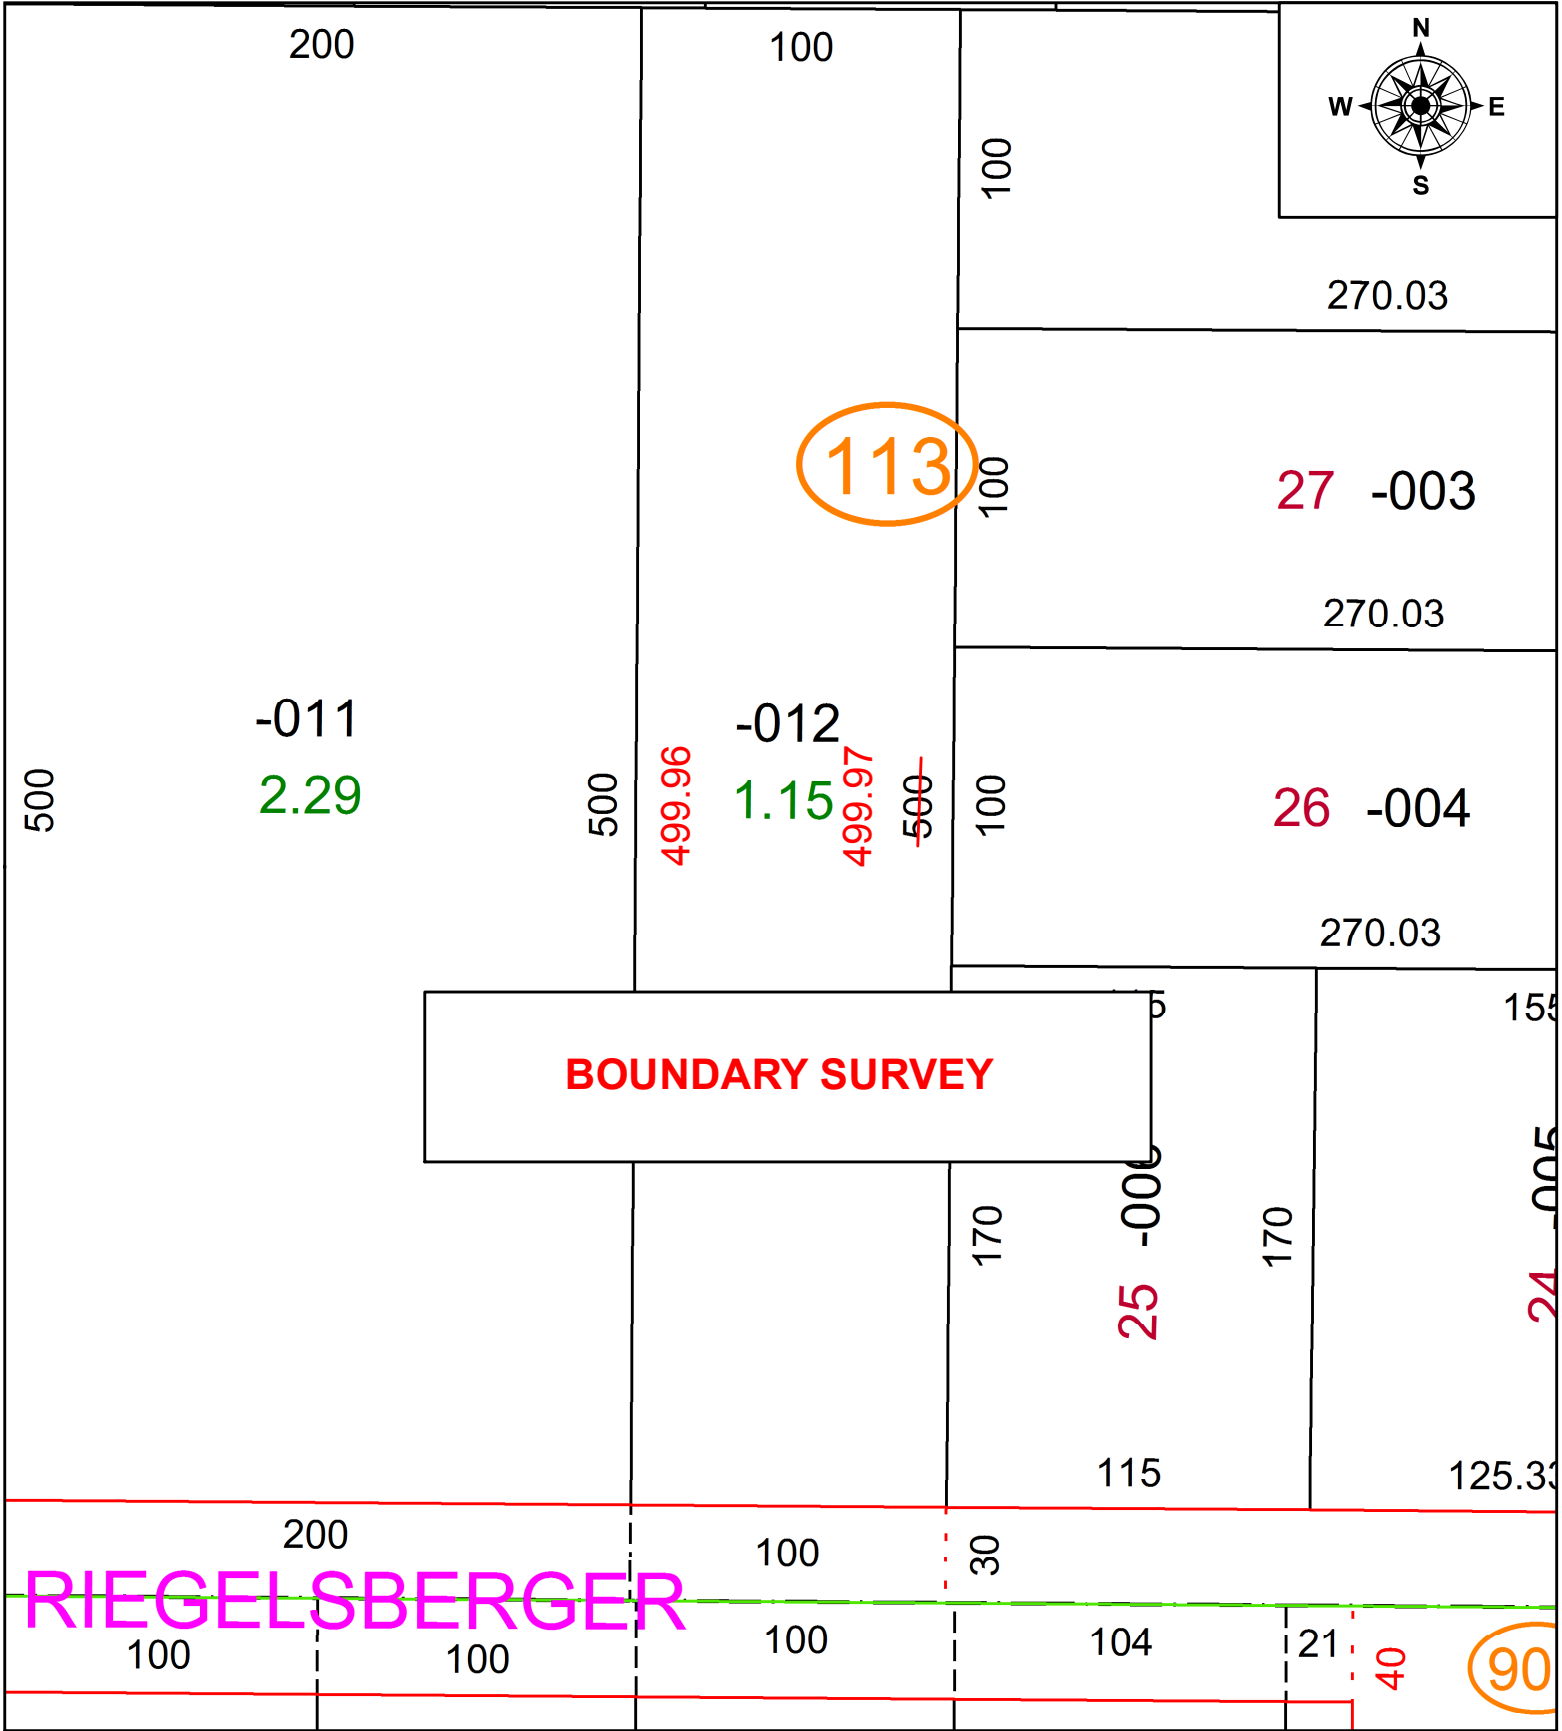

RIEGLSBERGER



SPLITS/DEEDS PROCESSED
LORAIN COUNTY TAX MAP DEPARTMENT
226 MIDDLE AVE. ELYRIA, OH

SURVEYED BY:	THOMAS A. SIMON
CLOSURE:	1: 3751785
MAP PAGE(S):	04-00-023-E
APPROVED BY:	AC DATE: 6/4/2021
SCALE:	1" = 60 PRIOR INSTRUMENT: 2020-0762272