

PARENT PARCEL:

01-00-003-121-011, -023, & -024

CHILD PARCEL:




01-00-003-121-027

N/A

STARTING POINT:

N/A

22-04577

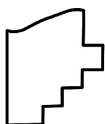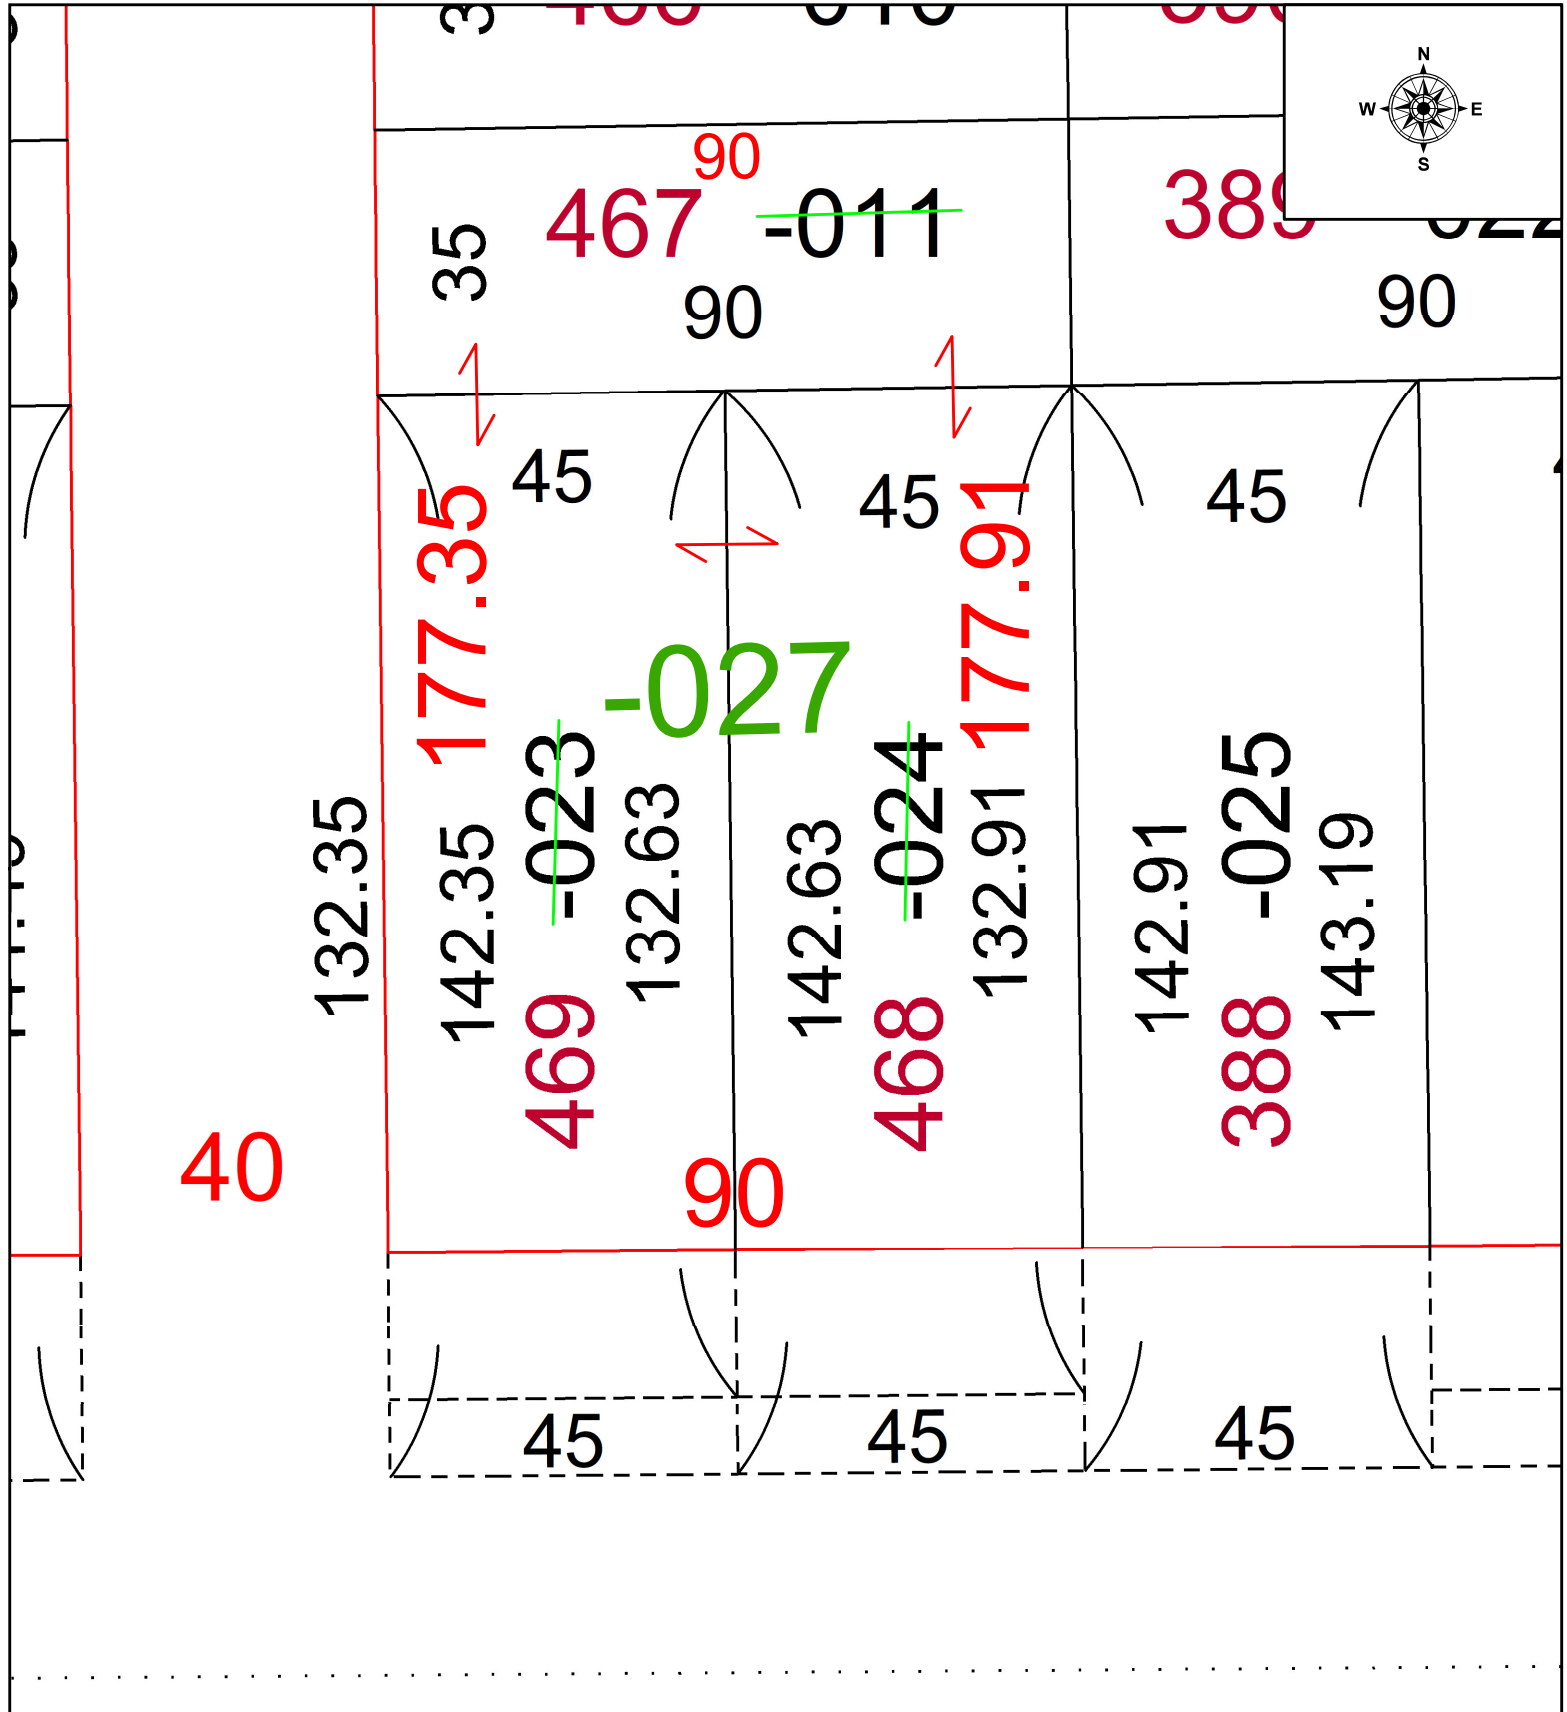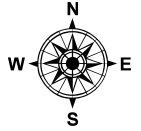

**SPLITS/DEEDS PROCESSED**  
 LORAIN COUNTY TAX MAP DEPARTMENT  
 226 MIDDLE AVE. ELYRIA, OH

SURVEYED BY:	THOMAS SNEZEK	SURVEY #	N/A
CLOSURE:	N/A		
MAP PAGE(S):	01-00-003		
APPROVED BY:	WRZ	DATE:	10/21/2022
SCALE:	1" = 25'	PRIOR INSTRUMENT:	#2021-0821768