


PARENT PARCEL: 10-00-003-124-029

CHILD PARCEL: _____

STARTING POINT: C/L OF RIEGELSBERGER RD AND KENSINGTON DR

21-04578-A

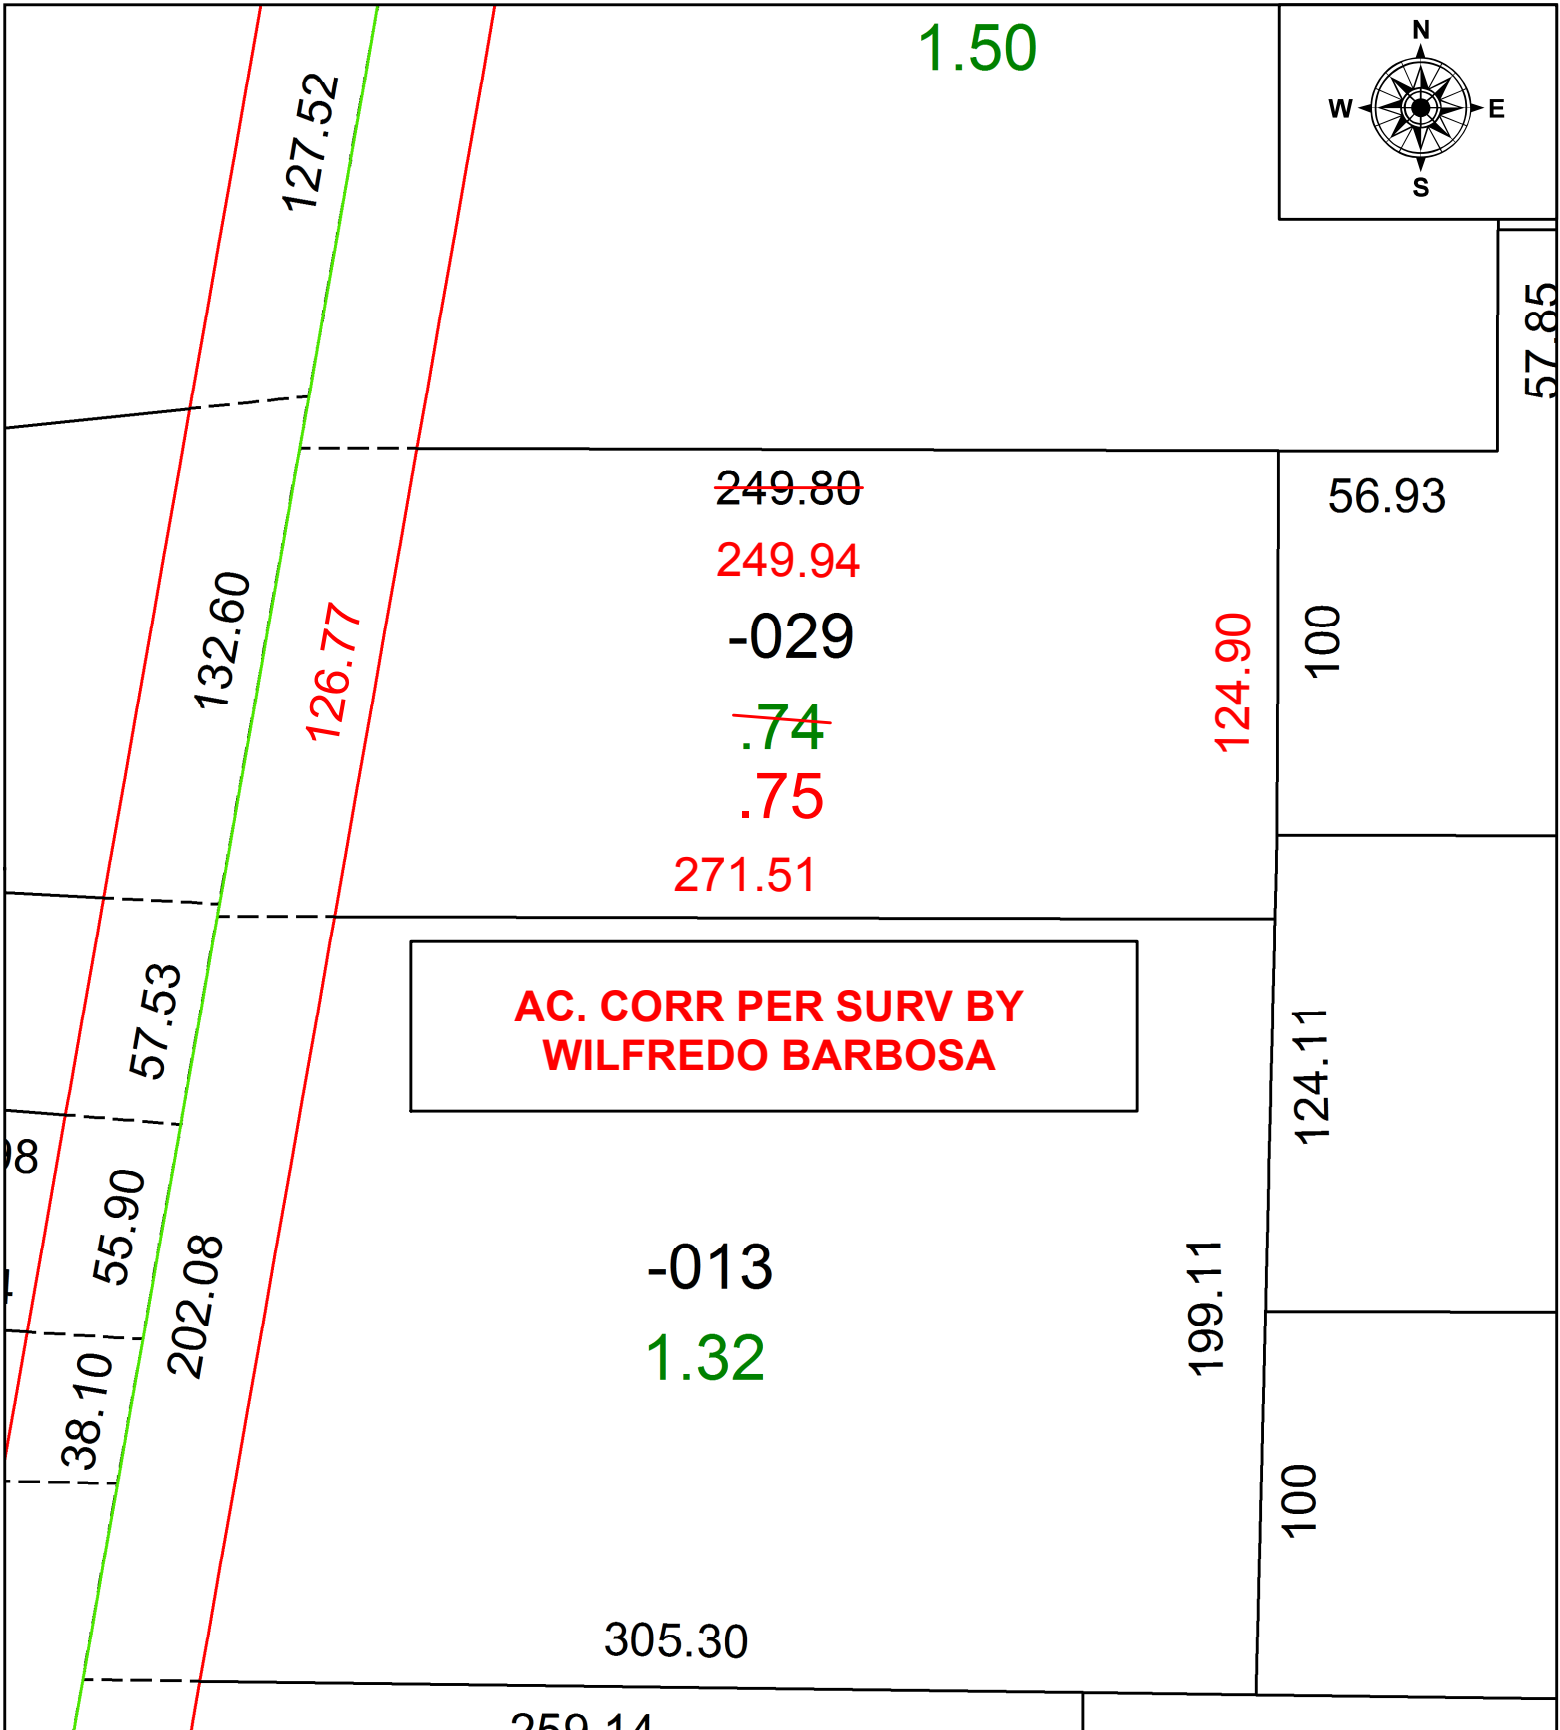

SPLITS/DEEDS PROCESSED
 LORAIN COUNTY TAX MAP DEPARTMENT
 226 MIDDLE AVE. ELYRIA, OH

SURVEYED BY: WILFREDO BARBOSA

CLOSURE: 1: 195448

MAP PAGE(S): 10-00-003-F

APPROVED BY: AC DATE: 6/4/2021

SCALE: 1" = 50 PRIOR INSTRUMENT: 1979-0047614