


PARENT PARCEL: 15-00-045-101-104 & -108

CHILD PARCEL: 15-00-045-101-118, -119, & -120

N/A

22-04579

STARTING POINT: MONUMENT BOX @ C/L OF ST RT 301 & NORTHEAST CORNER OF O.L. 45

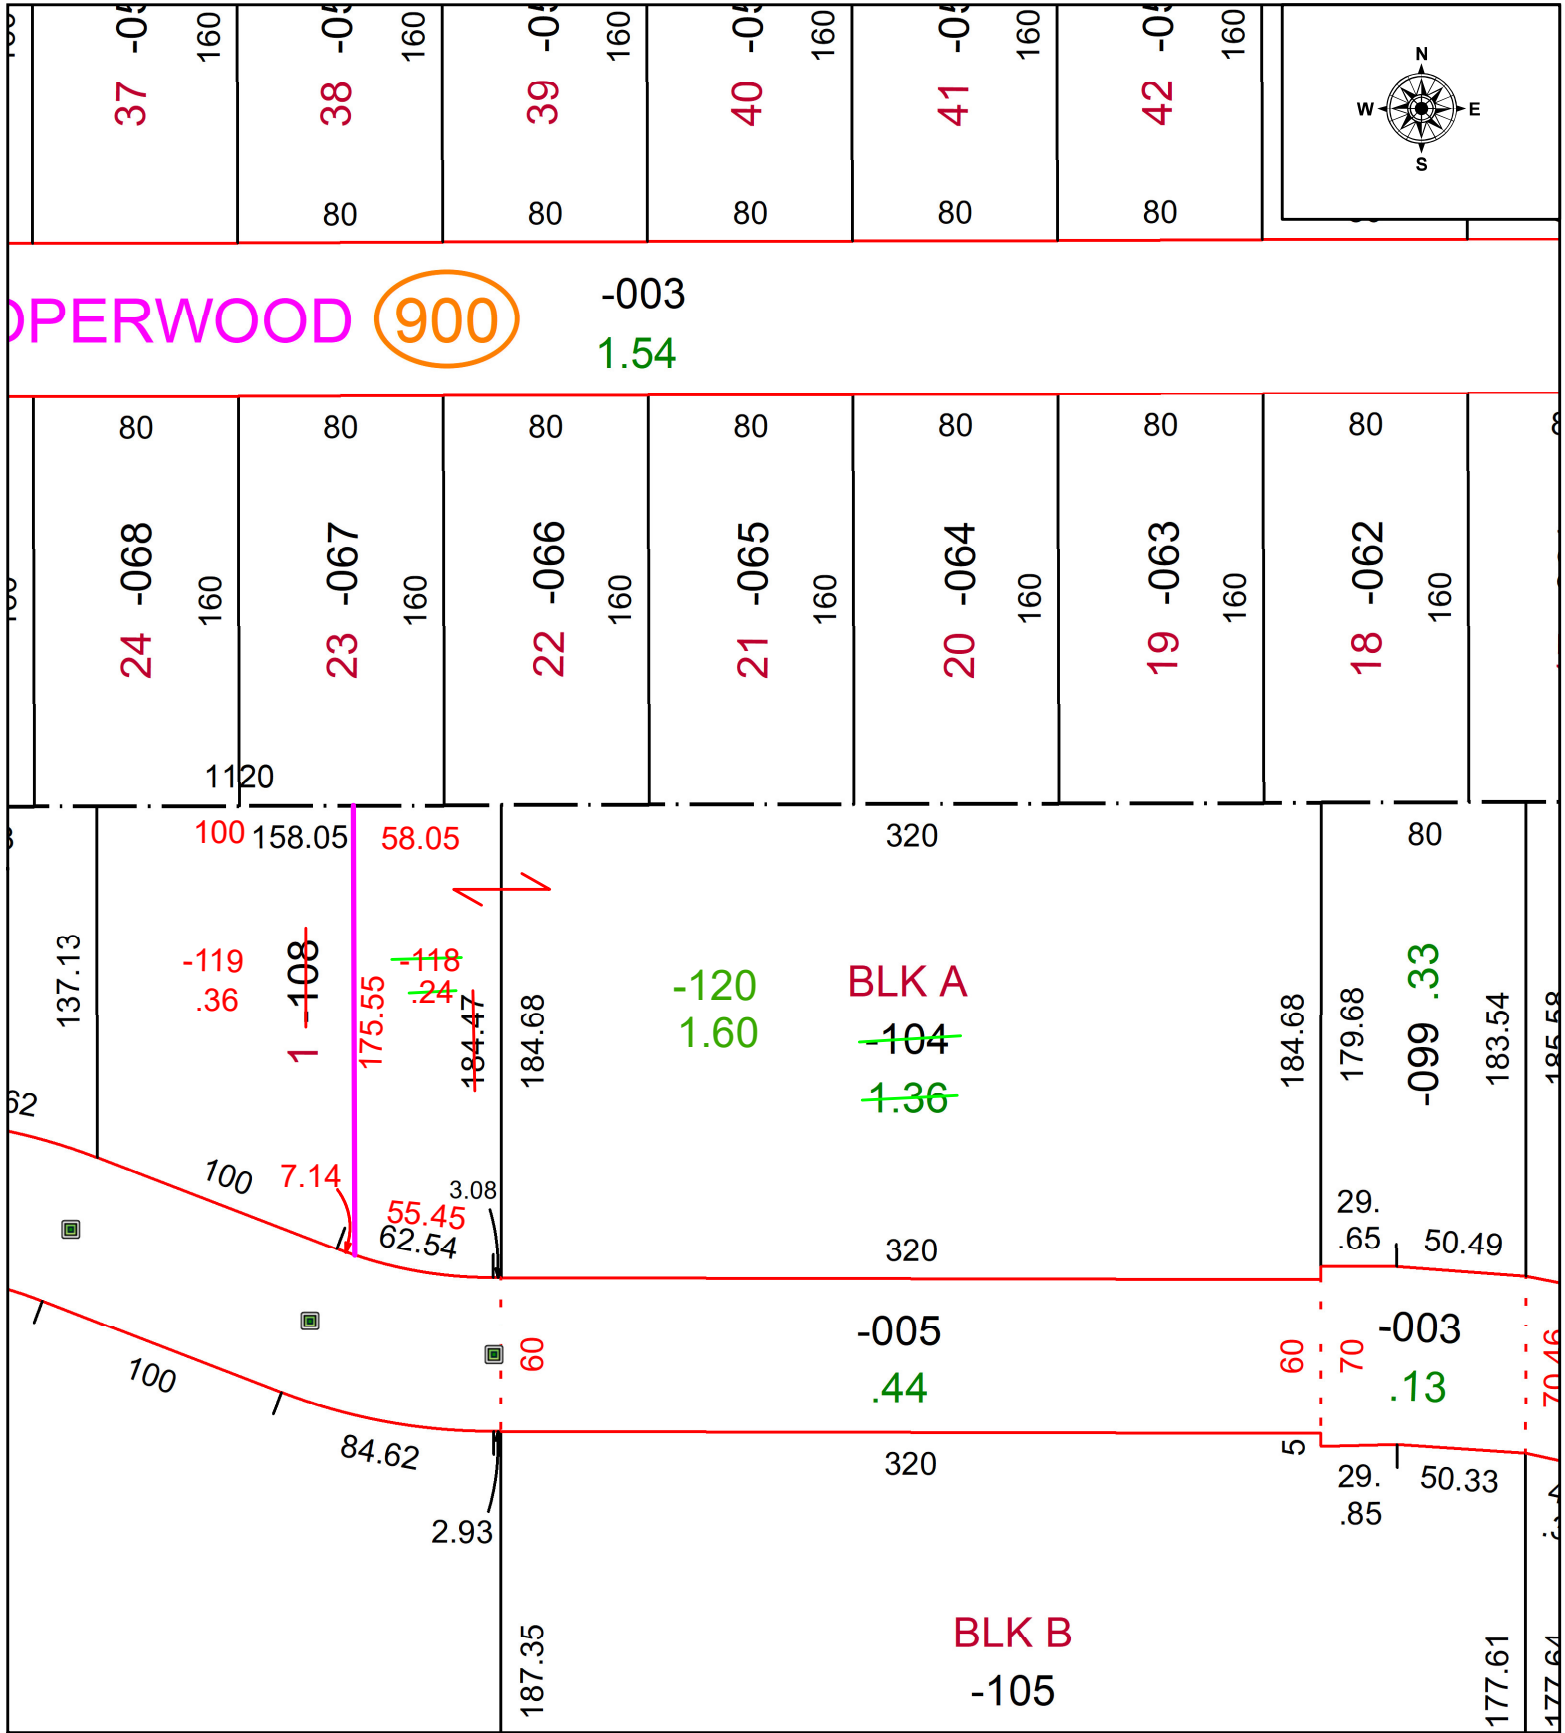

SPLITS/DEEDS PROCESSED
 LORAIN COUNTY TAX MAP DEPARTMENT
 226 MIDDLE AVE. ELYRIA, OH

SURVEYED BY: DALE HAYWOOD SURVEY # 50725
 CLOSURE: 1: 82157
 MAP PAGE(S): 15-00-045
 APPROVED BY: WRZ DATE: 10/25/2022
 SCALE: 1" = 75' PRIOR INSTRUMENT: #2020-0749929