
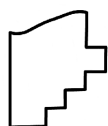


PARENT PARCEL: 06-26-026-000-029

CHILD PARCEL: CORR. PER DV. 864 PG. 630

STARTING POINT: S.E. CORNER OF S/L 5 IN HEMAN ELY'S ADDITION PV. 1 PG. 35

21-04580-C

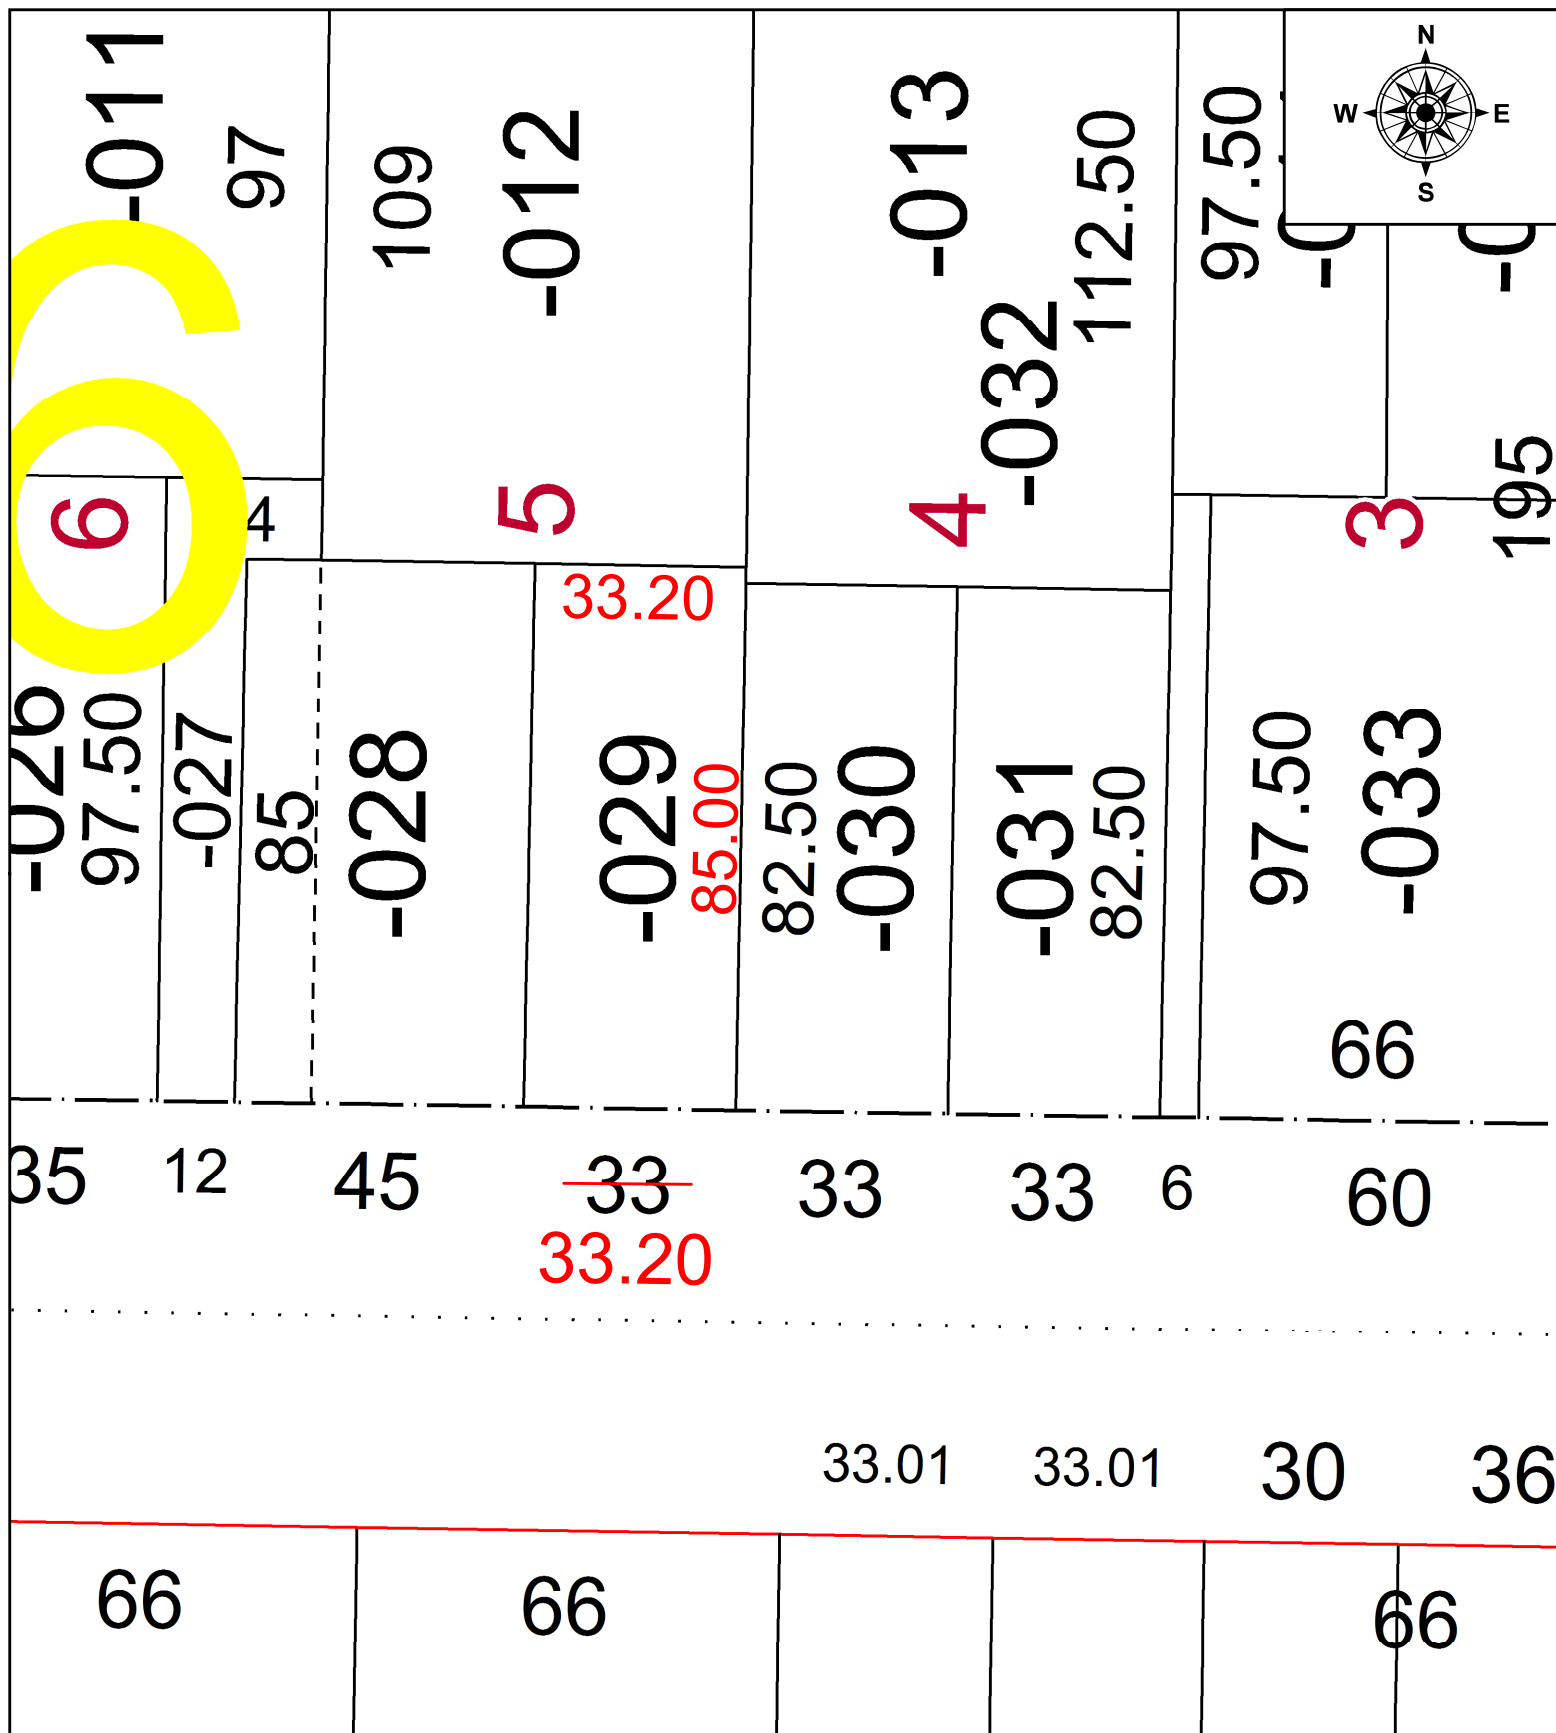

SPLITS/DEEDS PROCESSED
 LORAIN COUNTY TAX MAP DEPARTMENT
 226 MIDDLE AVE. ELYRIA, OH

SURVEYED BY: NA
 CLOSURE: NA
 MAP PAGE(S): 06-26-026
 APPROVED BY: TJS DATE: 6/9/2021
 SCALE: 1" = 30' PRIOR INSTRUMENT: DV 864/630