


PARENT PARCEL: 18-00-041-000-035

CHILD PARCEL: XX-XX-XXX-XXX-XXX

STARTING POINT: CL OF PITTS RD & PECK WADSWORTH RD.

21-04581-A

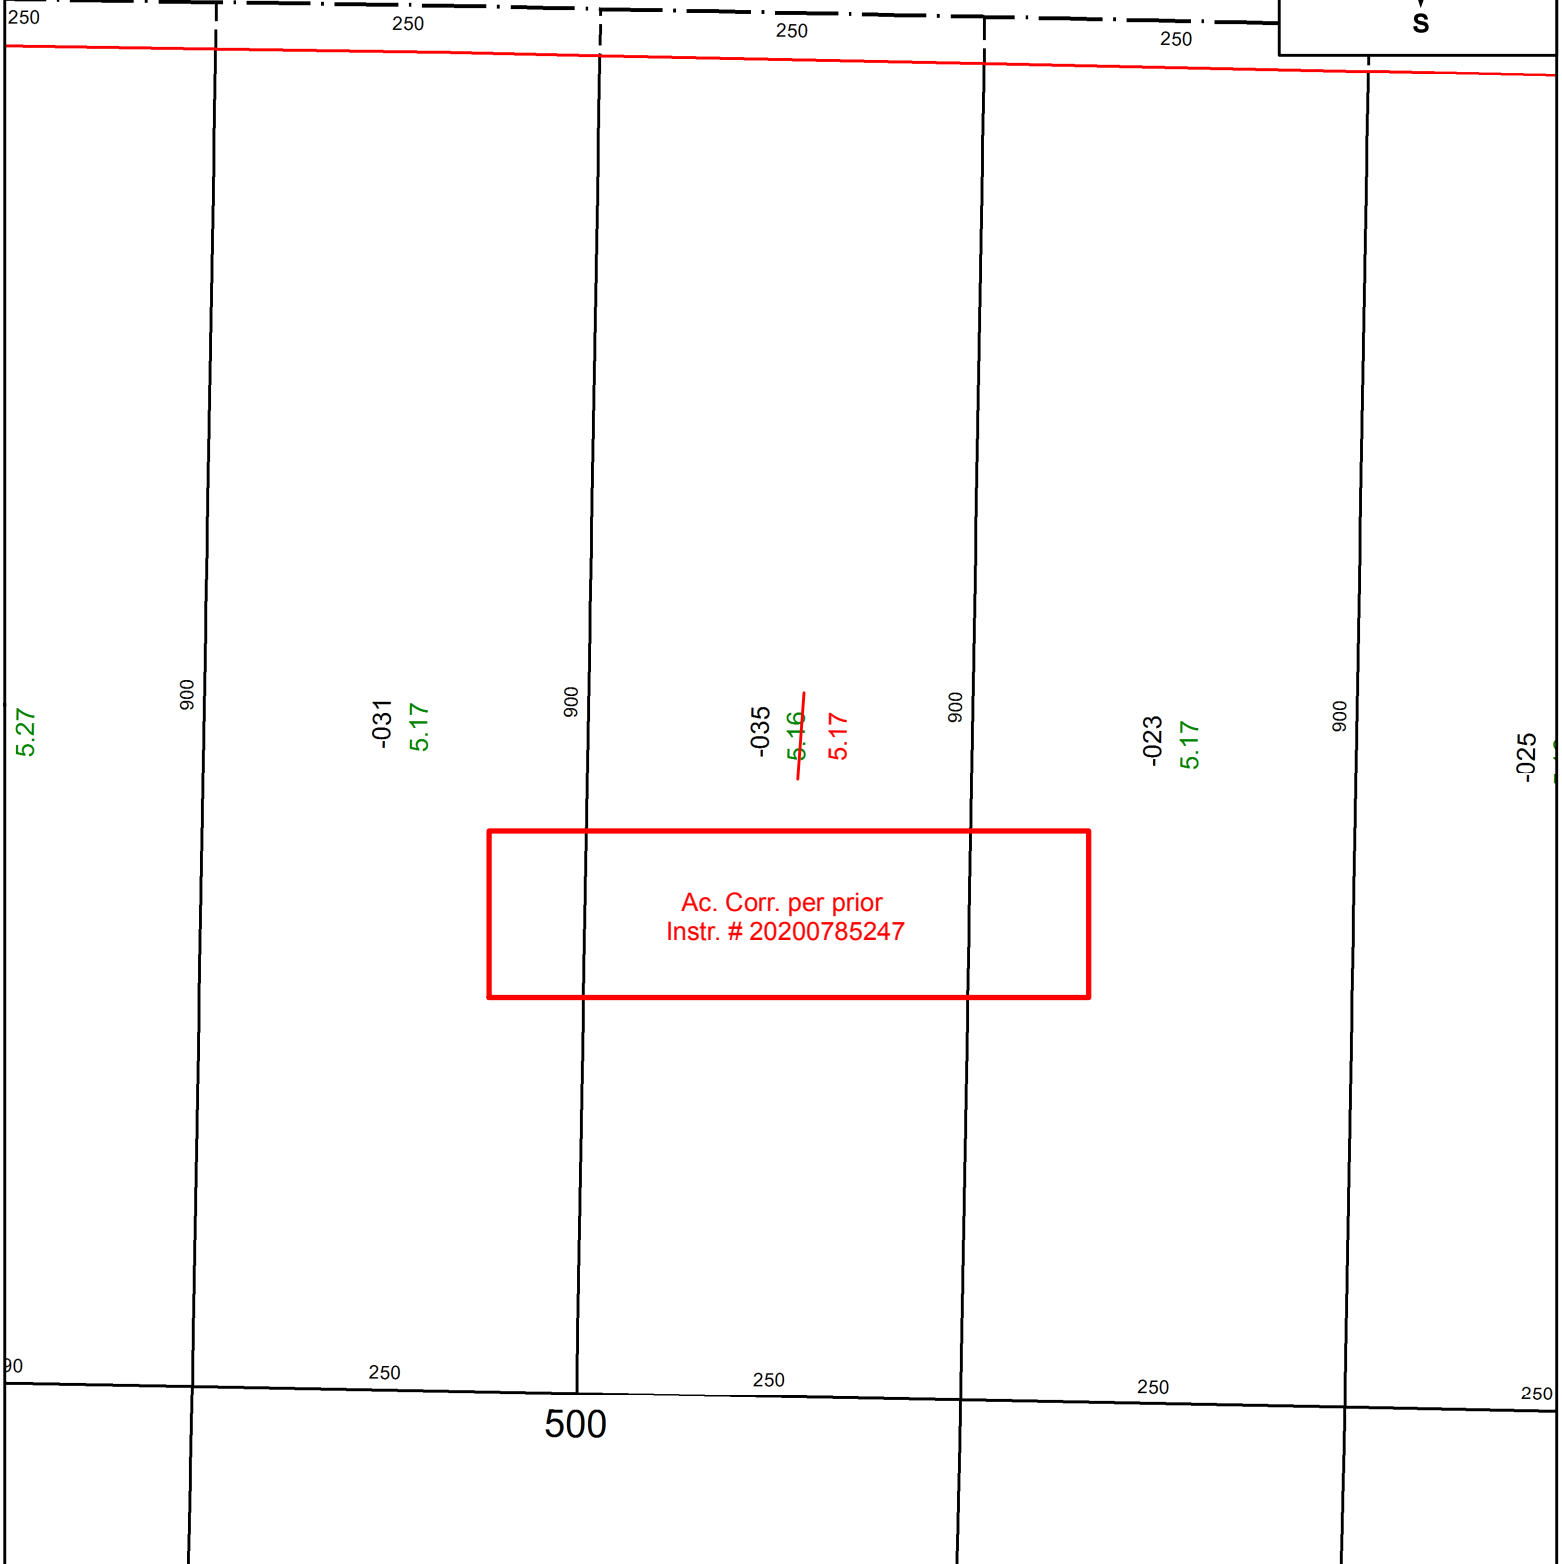

**SPLITS/DEEDS PROCESSED**  
 LORAIN COUNTY TAX MAP DEPARTMENT  
 226 MIDDLE AVE. ELYRIA, OH

SURVEYED BY: SANTEE ASSOCIATES

CLOSURE: 1: 2147483648

MAP PAGE(S): 18-00-041

APPROVED BY: DMA DATE: 1/20/16

SCALE: 1" = 125 PRIOR INSTRUMENT: INSTR. # 20200785247