


PARENT PARCEL: 03-00-046-102-019

CHILD PARCEL: 03-00-046-102-024, -025


STARTING POINT: NW CORNER OF SUBLot 81

21-04583-U

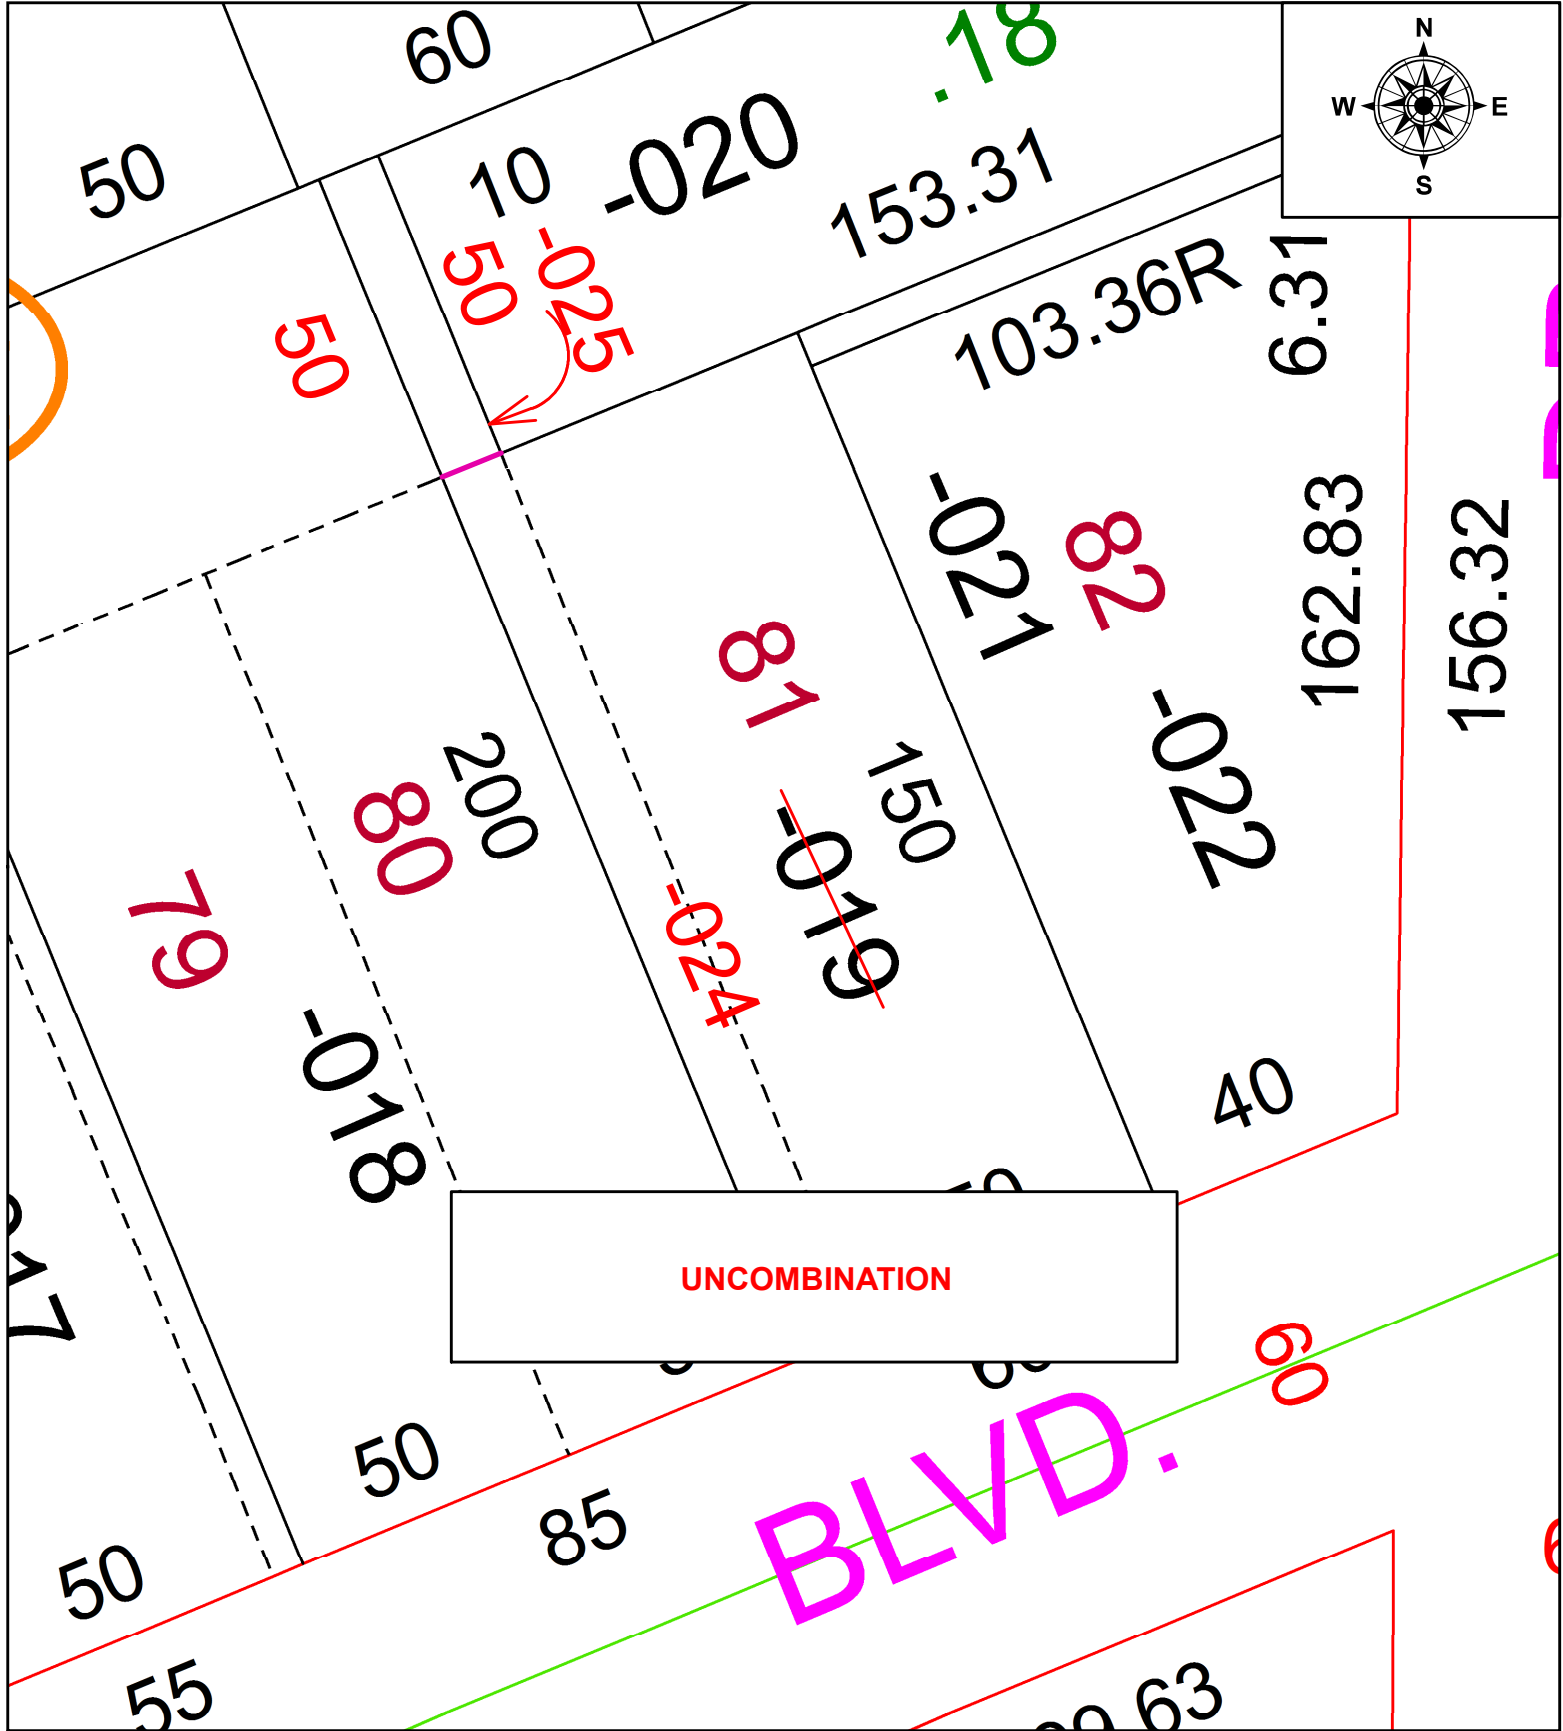

UNCOMBINATION

BLVD.

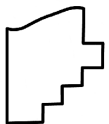

**SPLITS/DEEDS PROCESSED**  
LORAIN COUNTY TAX MAP DEPARTMENT  
226 MIDDLE AVE. ELYRIA, OH

SURVEYED BY: N/A  
CLOSURE: N/A  
MAP PAGE(S): 03-00-046-A  
APPROVED BY: AC DATE: 6/15/2021  
SCALE: 1" = 30' PRIOR INSTRUMENT: 2011-0379102