


PARENT PARCEL: 09-00-014-101-065

CHILD PARCEL: 09-00-014-101-066 & -067

N/A

22-04584

STARTING POINT: MONUMENT BOX @ C/LS OF ANNIS RD & RUSSIA RD

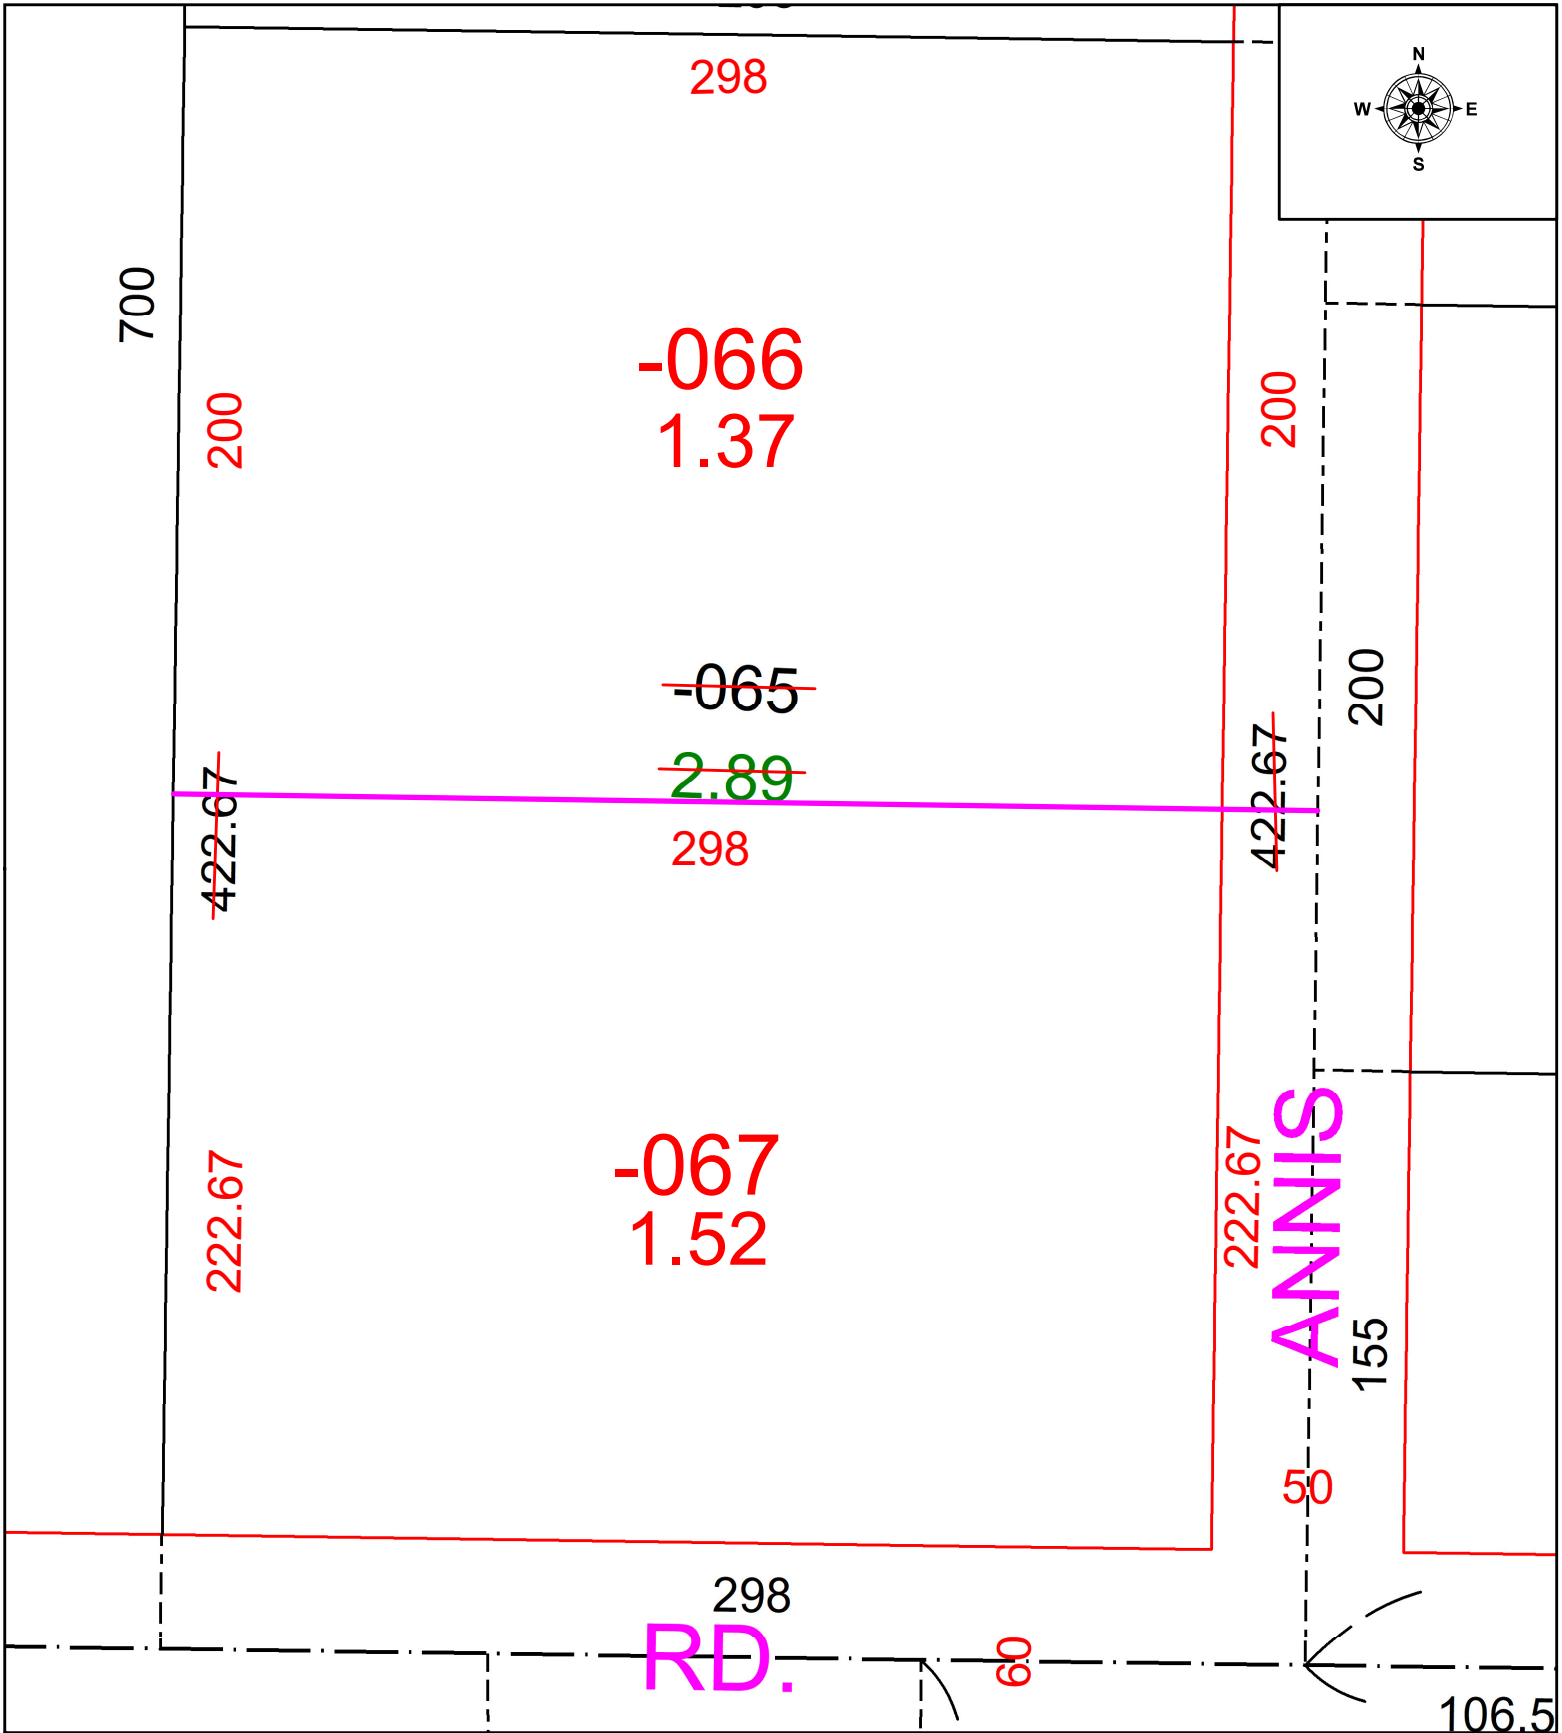

**SPLITS/DEEDS PROCESSED**  
 LORAIN COUNTY TAX MAP DEPARTMENT  
 226 MIDDLE AVE. ELYRIA, OH

SURVEYED BY: PATRICK MCGANNON

SURVEY # 50743

CLOSURE: 1: -2147483648

MAP PAGE(S): 09-00-014

APPROVED BY: WRZ DATE: 11/21/2022

SCALE: 1" = 50

PRIOR INSTRUMENT: #2021-0854547