


PARENT PARCEL: 10-00-016-000-188, 189 & -190

CHILD PARCEL: 10-00-016-000-193

STARTING POINT: CL OF INDIAN HOLLOW RD. & SLIFE RD.

22-04585

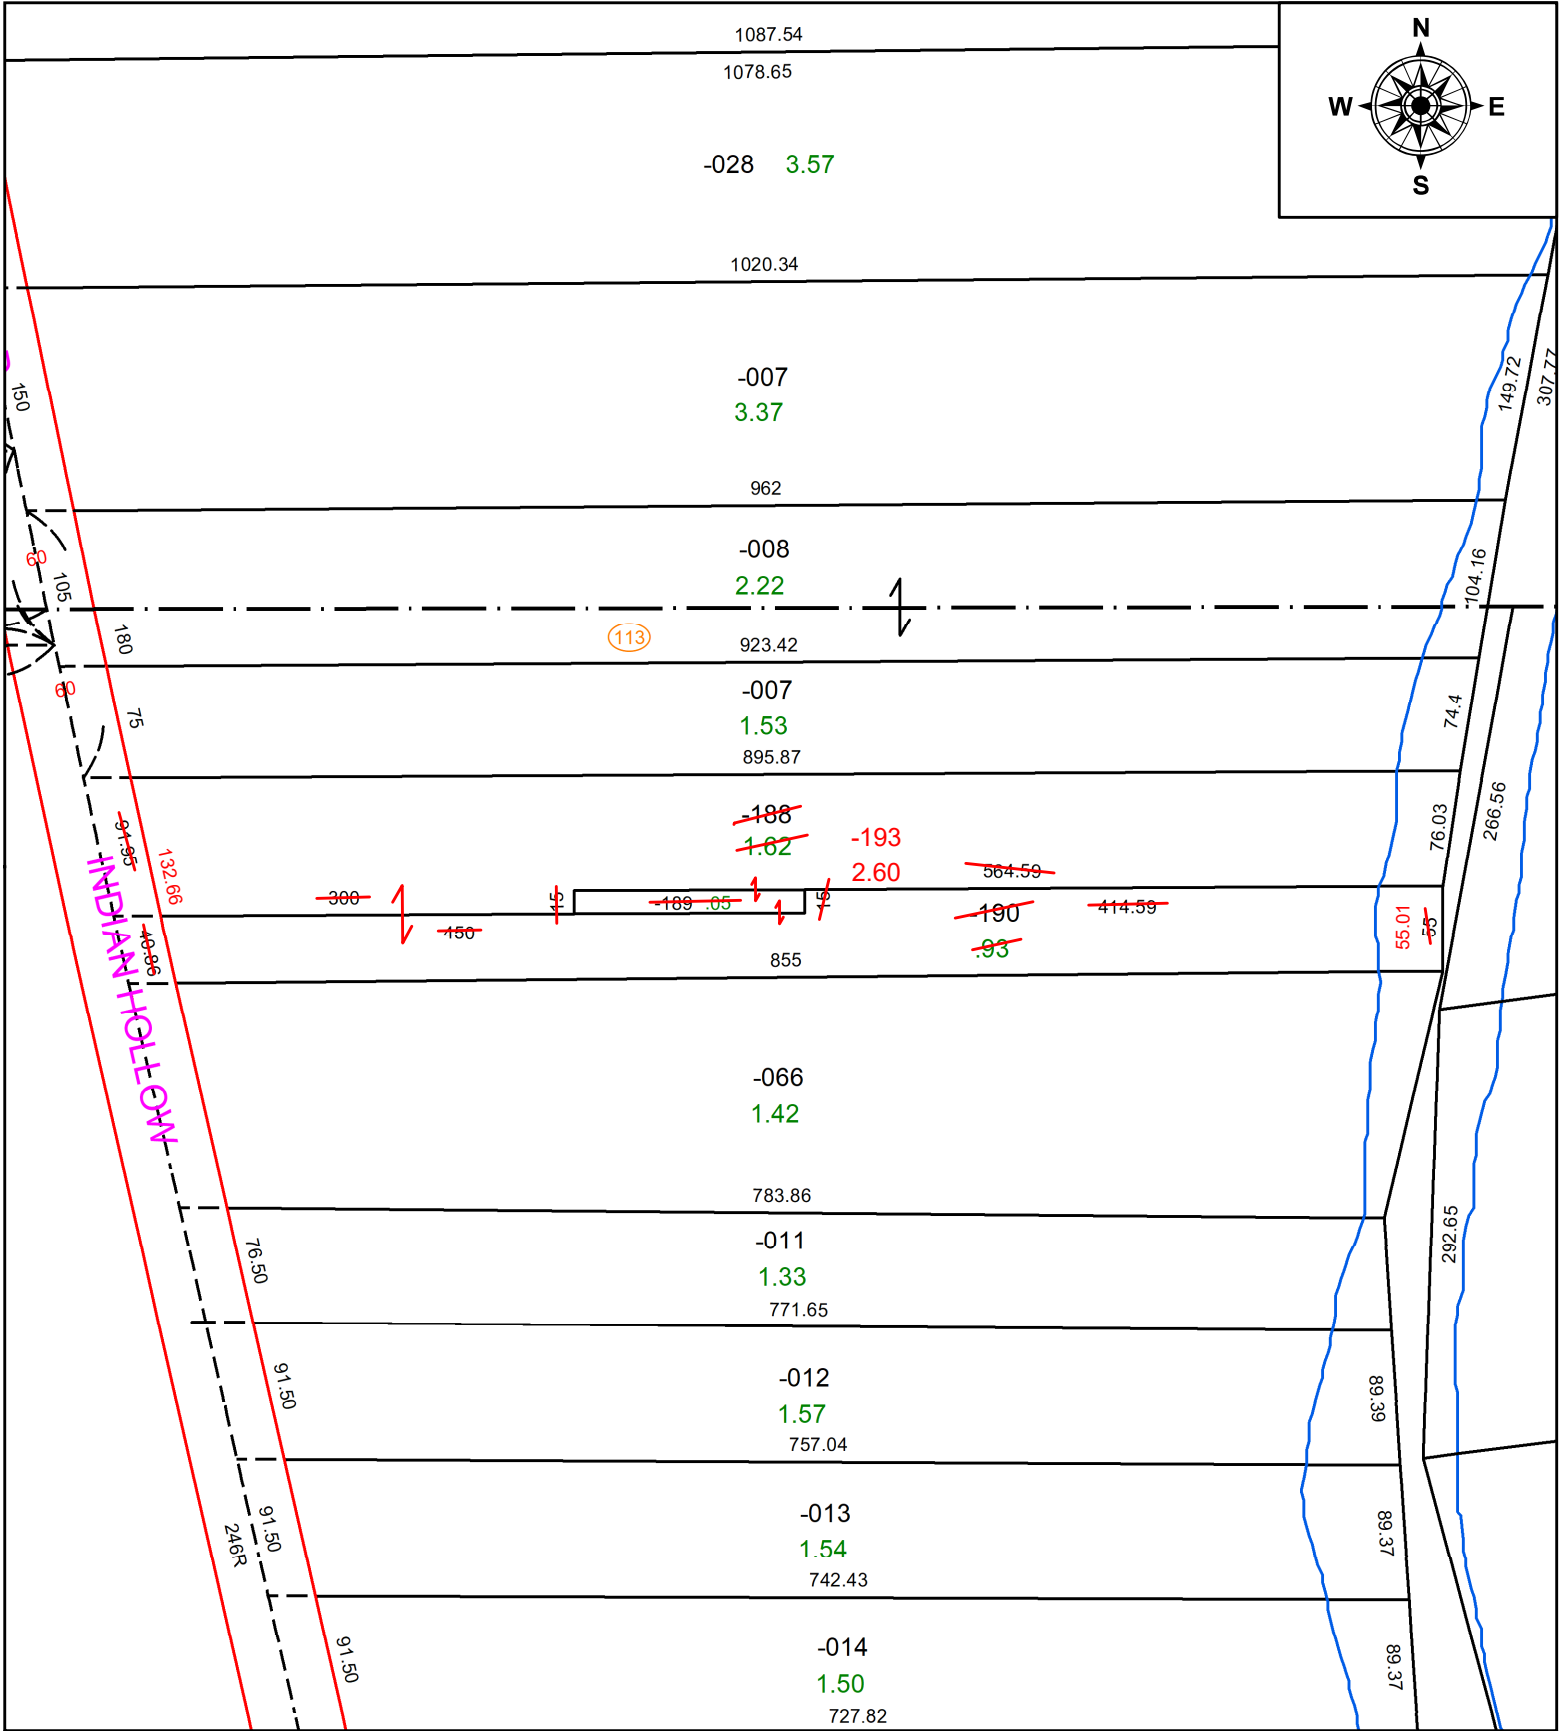

**SPLITS/DEEDS PROCESSED**  
 LORAIN COUNTY TAX MAP DEPARTMENT  
 226 MIDDLE AVE. ELYRIA, OH

**SURVEYED BY:** AMY KELLY **SURVEY #:** 50745  
**CLOSURE:** 1: 909024  
**MAP PAGE(S):** 10-00-016  
**APPROVED BY:** DMA **DATE:** 11/23/2022  
**SCALE:** 1" = 125' **PRIOR INSTRUMENT:** 2022-0894982