


PARENT PARCEL: 03-00-036-121-006, -025, -026, -027

CHILD PARCEL: 03-00-036-121-038

STARTING POINT: C/L OF MADISON AVE AND PARKVIEW DR

22-04586

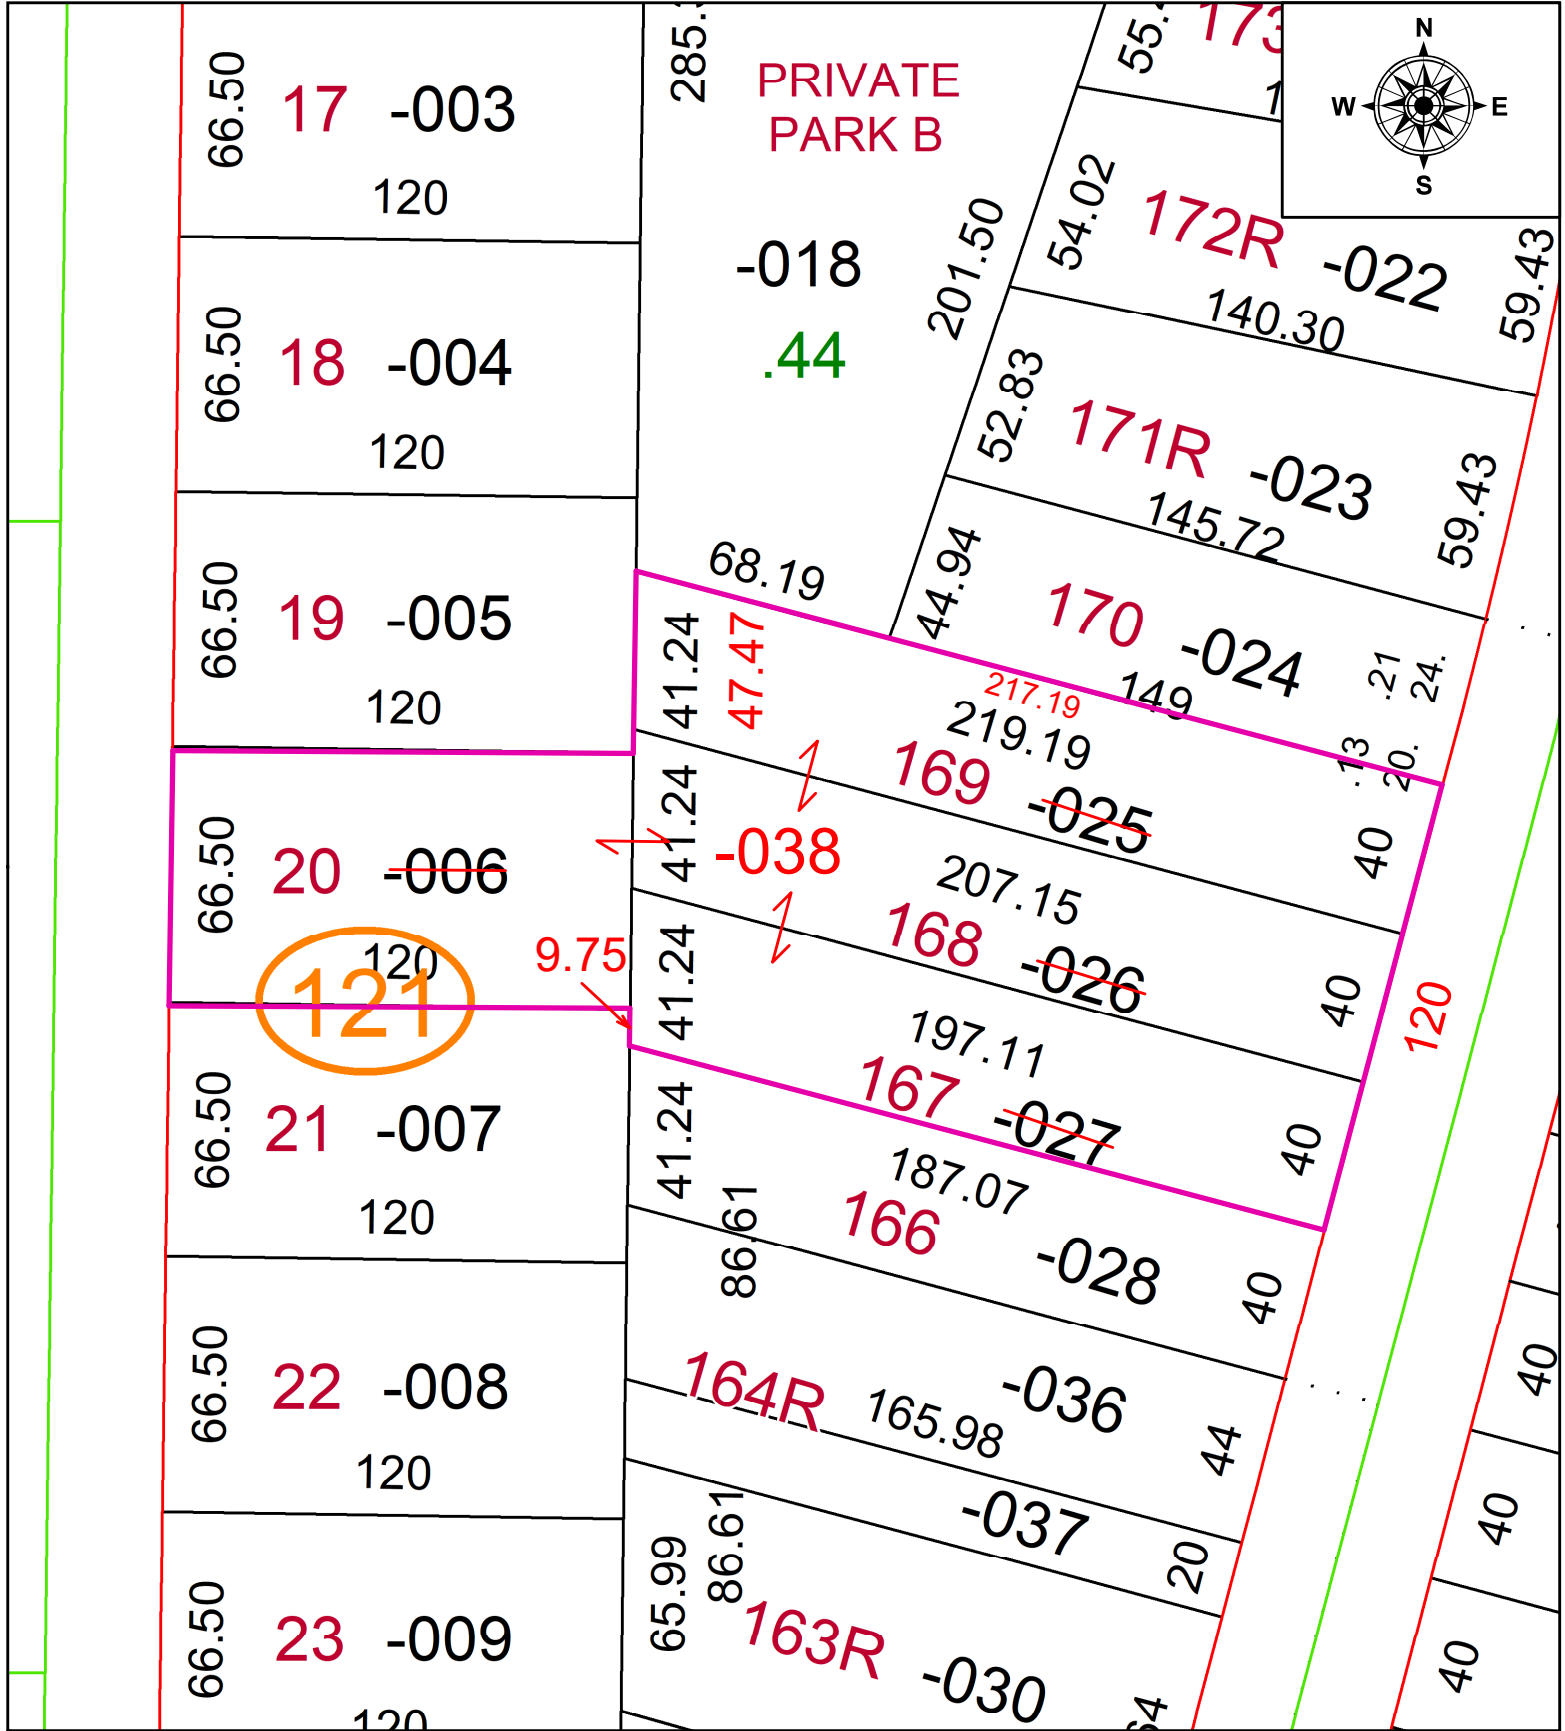

SPLITS/DEEDS PROCESSED
 LORAIN COUNTY TAX MAP DEPARTMENT
 226 MIDDLE AVE. ELYRIA, OH

SURVEYED BY: PATRICK A. MCGANNON SURV # 50746
 CLOSURE: 1: 617857
 MAP PAGE(S): 03-00-036-A
 APPROVED BY: AC DATE: November 30, 2022
 SCALE: 1 in = 50 ft PRIOR INSTRUMENT: 2022- 0881996