
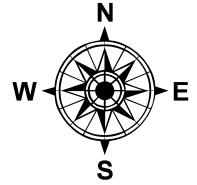


PARENT PARCEL: 06-25-007-000-176

CHILD PARCEL: XX-XX-XXX-XXX-XXX

STARTING POINT: WESTERLY ROW OF S. ABBE RD & N.E. CORNER S/L 286 OVERLAND GARDENS ALLOT

21-04588-A

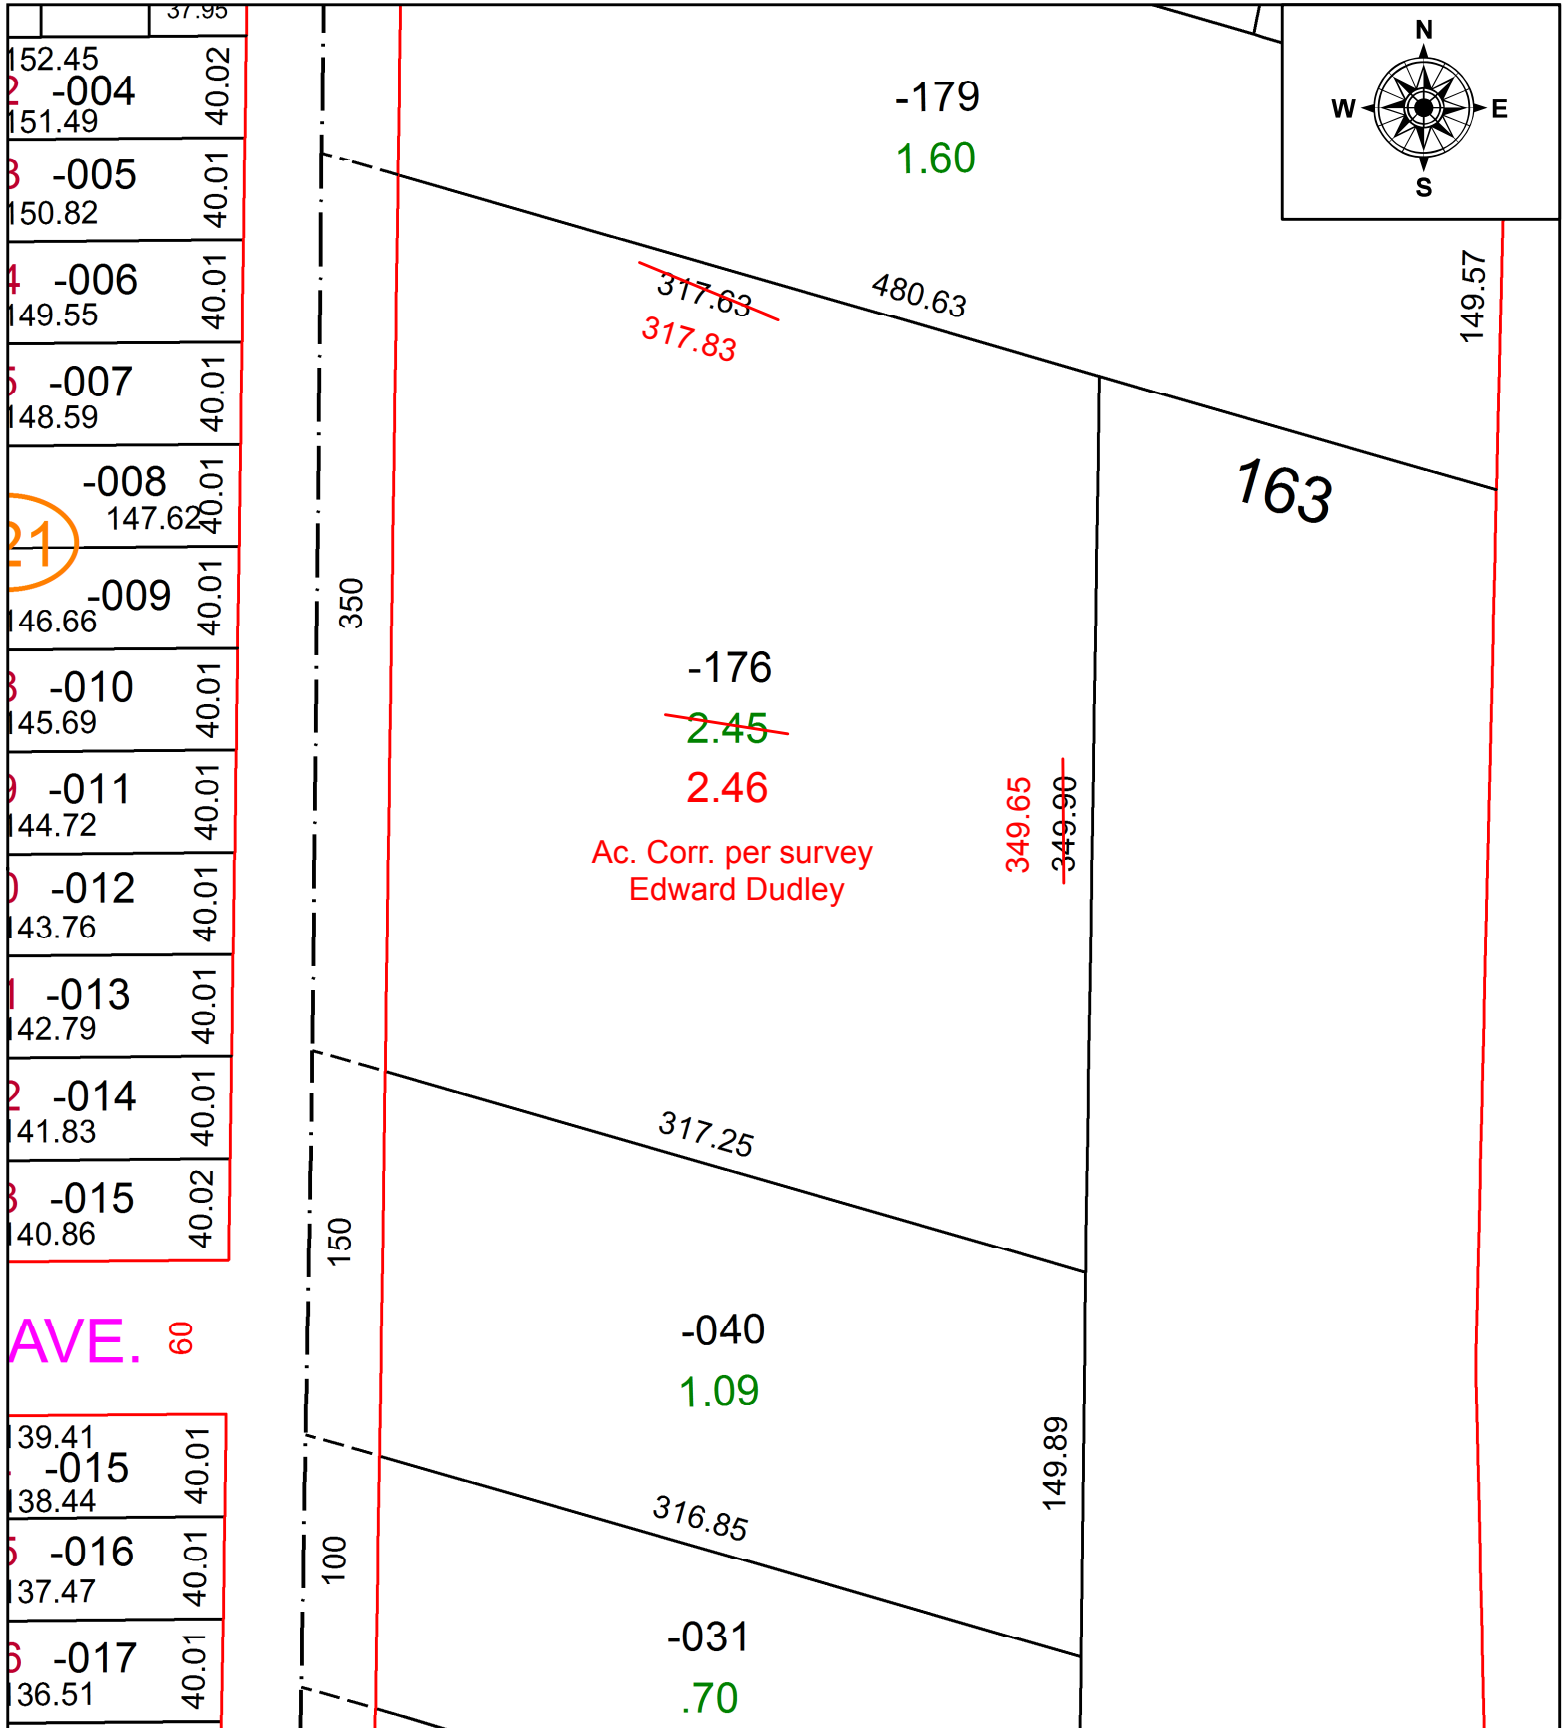

**SPLITS/DEEDS PROCESSED**  
 LORAIN COUNTY TAX MAP DEPARTMENT  
 226 MIDDLE AVE. ELYRIA, OH

SURVEYED BY: EDWARD B. DUDLEY III  
 CLOSURE: 1: 347406  
 MAP PAGE(S): 06-25-007  
 APPROVED BY: DMA DATE: 6/22/21  
 SCALE: 1" = 75' PRIOR INSTRUMENT: 20150554373