
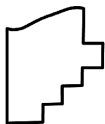
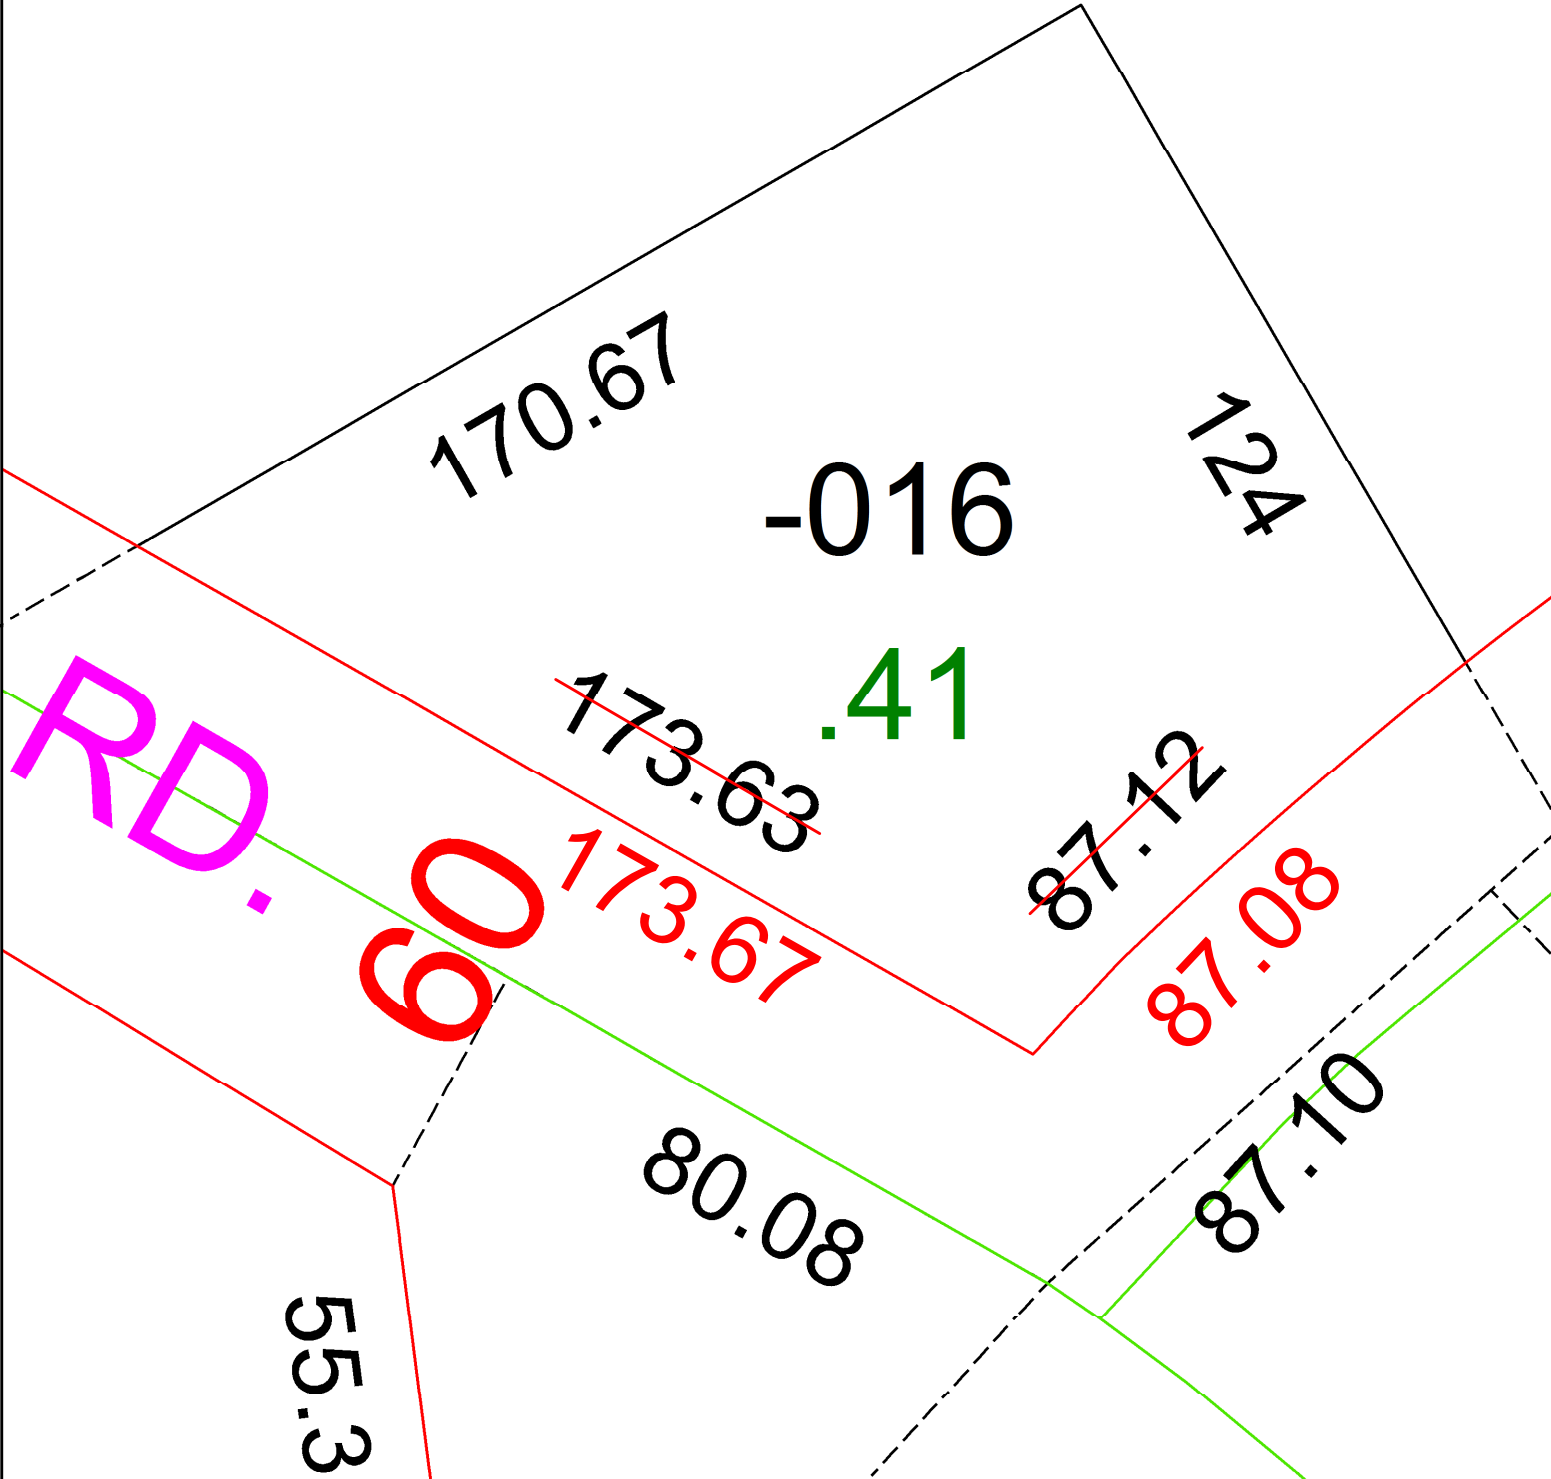


PARENT PARCEL: 05-00-045-000-016

CHILD PARCEL: _____

STARTING POINT: C/L OF S DEWEY AND OLD MIDDLE RIDGE ROAD

21-04590-C

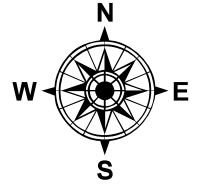

SPLITS/DEEDS PROCESSED
 LORAIN COUNTY TAX MAP DEPARTMENT
 226 MIDDLE AVE. ELYRIA, OH

SURVEYED BY: PATRICK A. MCGANNON

CLOSURE: 1: 149923

MAP PAGE(S): 05-00-045-B

APPROVED BY: AC DATE: 6/23/2021

SCALE: 1" = 25 PRIOR INSTRUMENT: 2020-0768471