
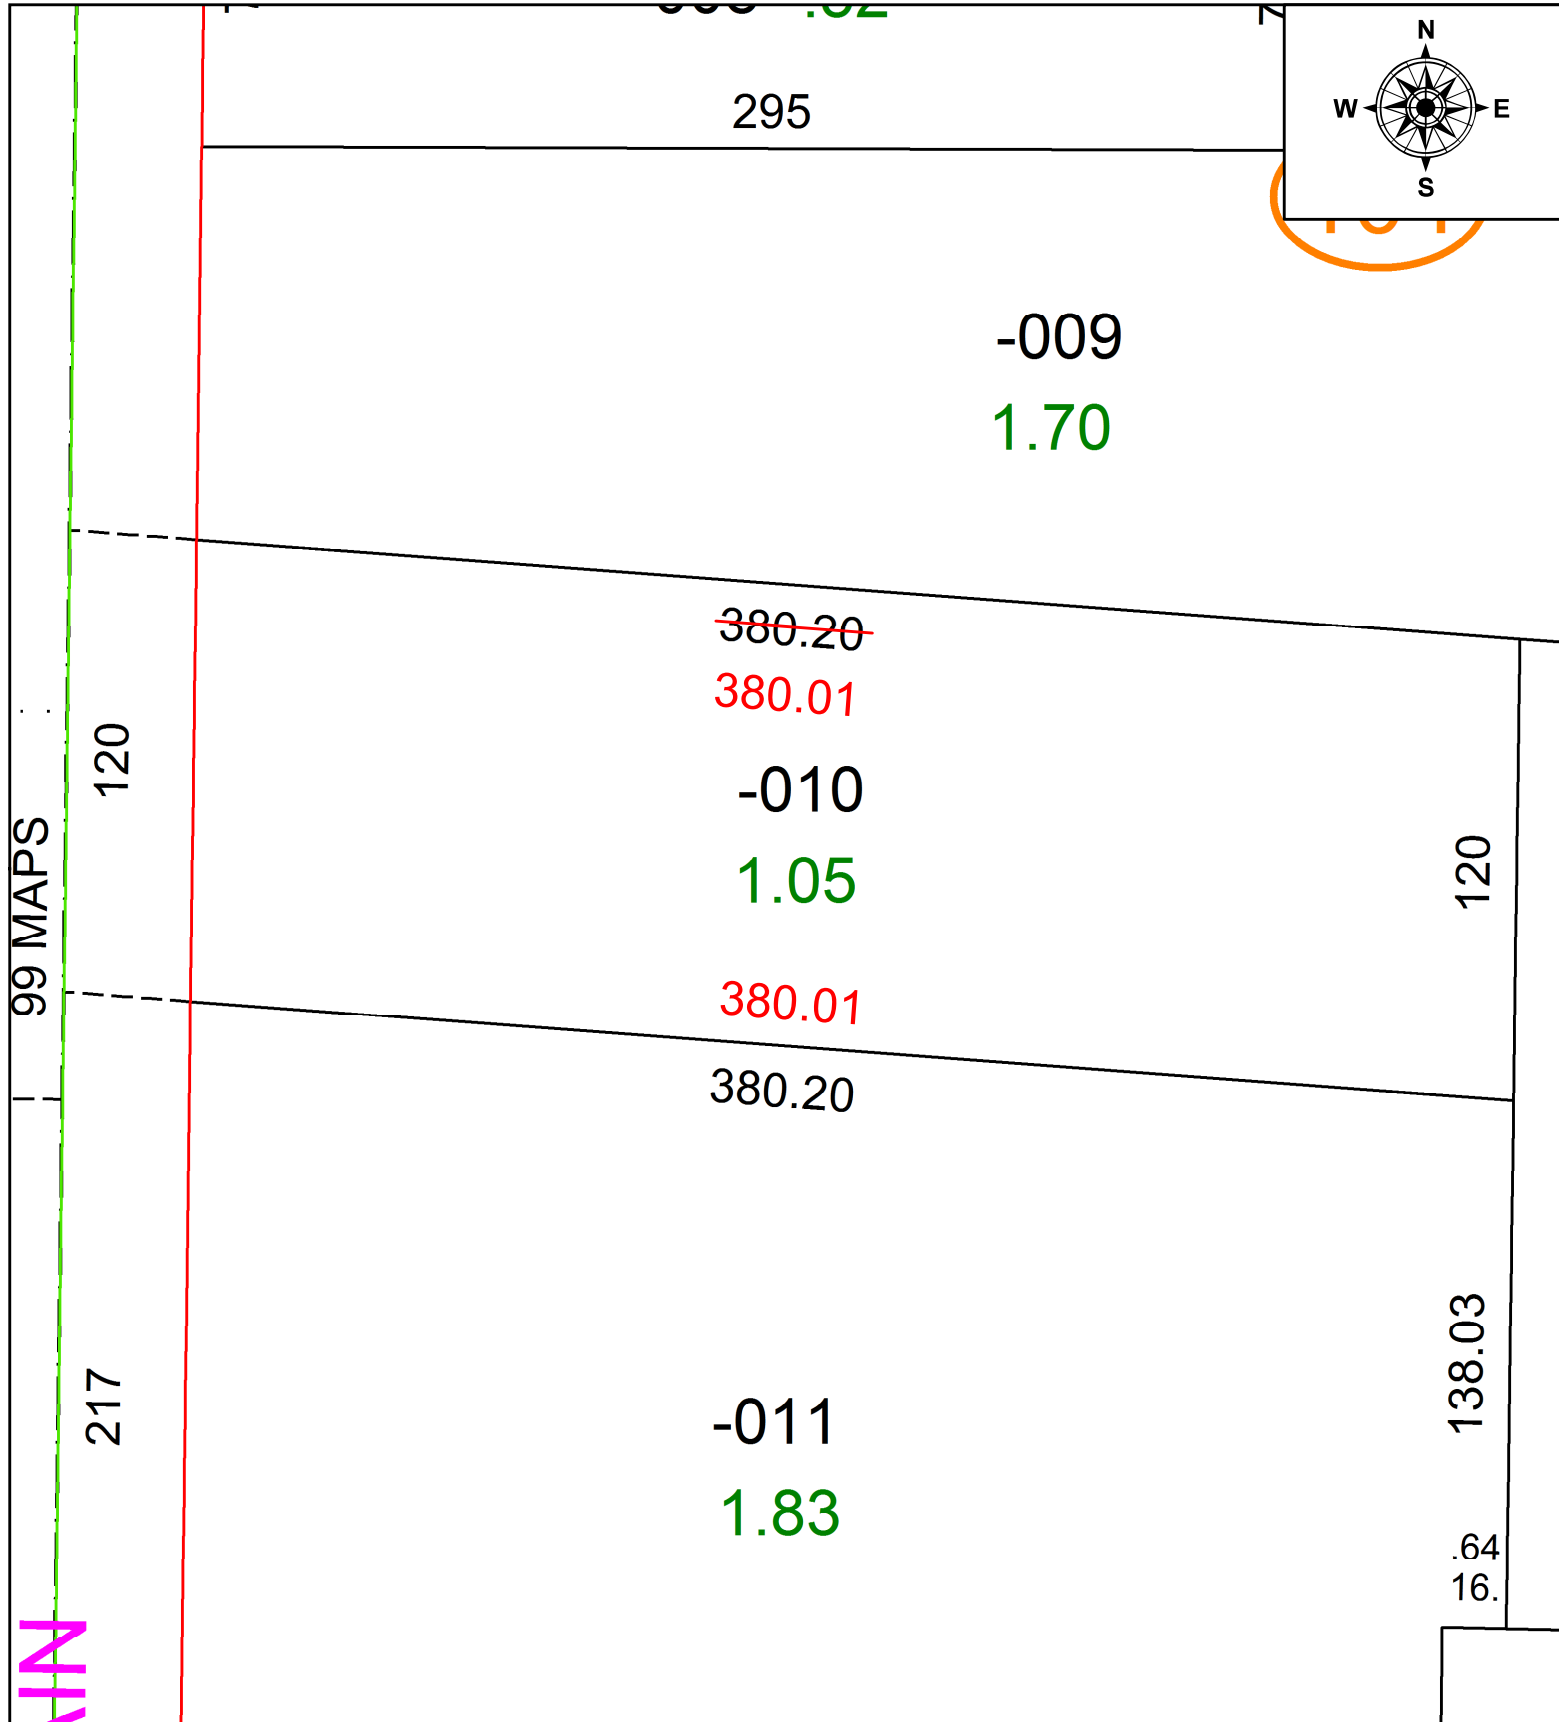


PARENT PARCEL: 09-00-096-104-010

CHILD PARCEL: MAP CORR ONLY

STARTING POINT: C/L OF S. MAIN AND E. HAMILTON STREET

21-04591-D

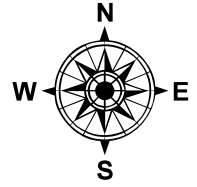

SPLITS/DEEDS PROCESSED
 LORAIN COUNTY TAX MAP DEPARTMENT
 226 MIDDLE AVE. ELYRIA, OH

SURVEYED BY: BRENT D. ANDERSON
 CLOSURE: 1: 2147483648
 MAP PAGE(S): 09-00-096-A
 APPROVED BY: AC DATE: 6/25/2021
 SCALE: 1" = 50 PRIOR INSTRUMENT: 2019-0735862