
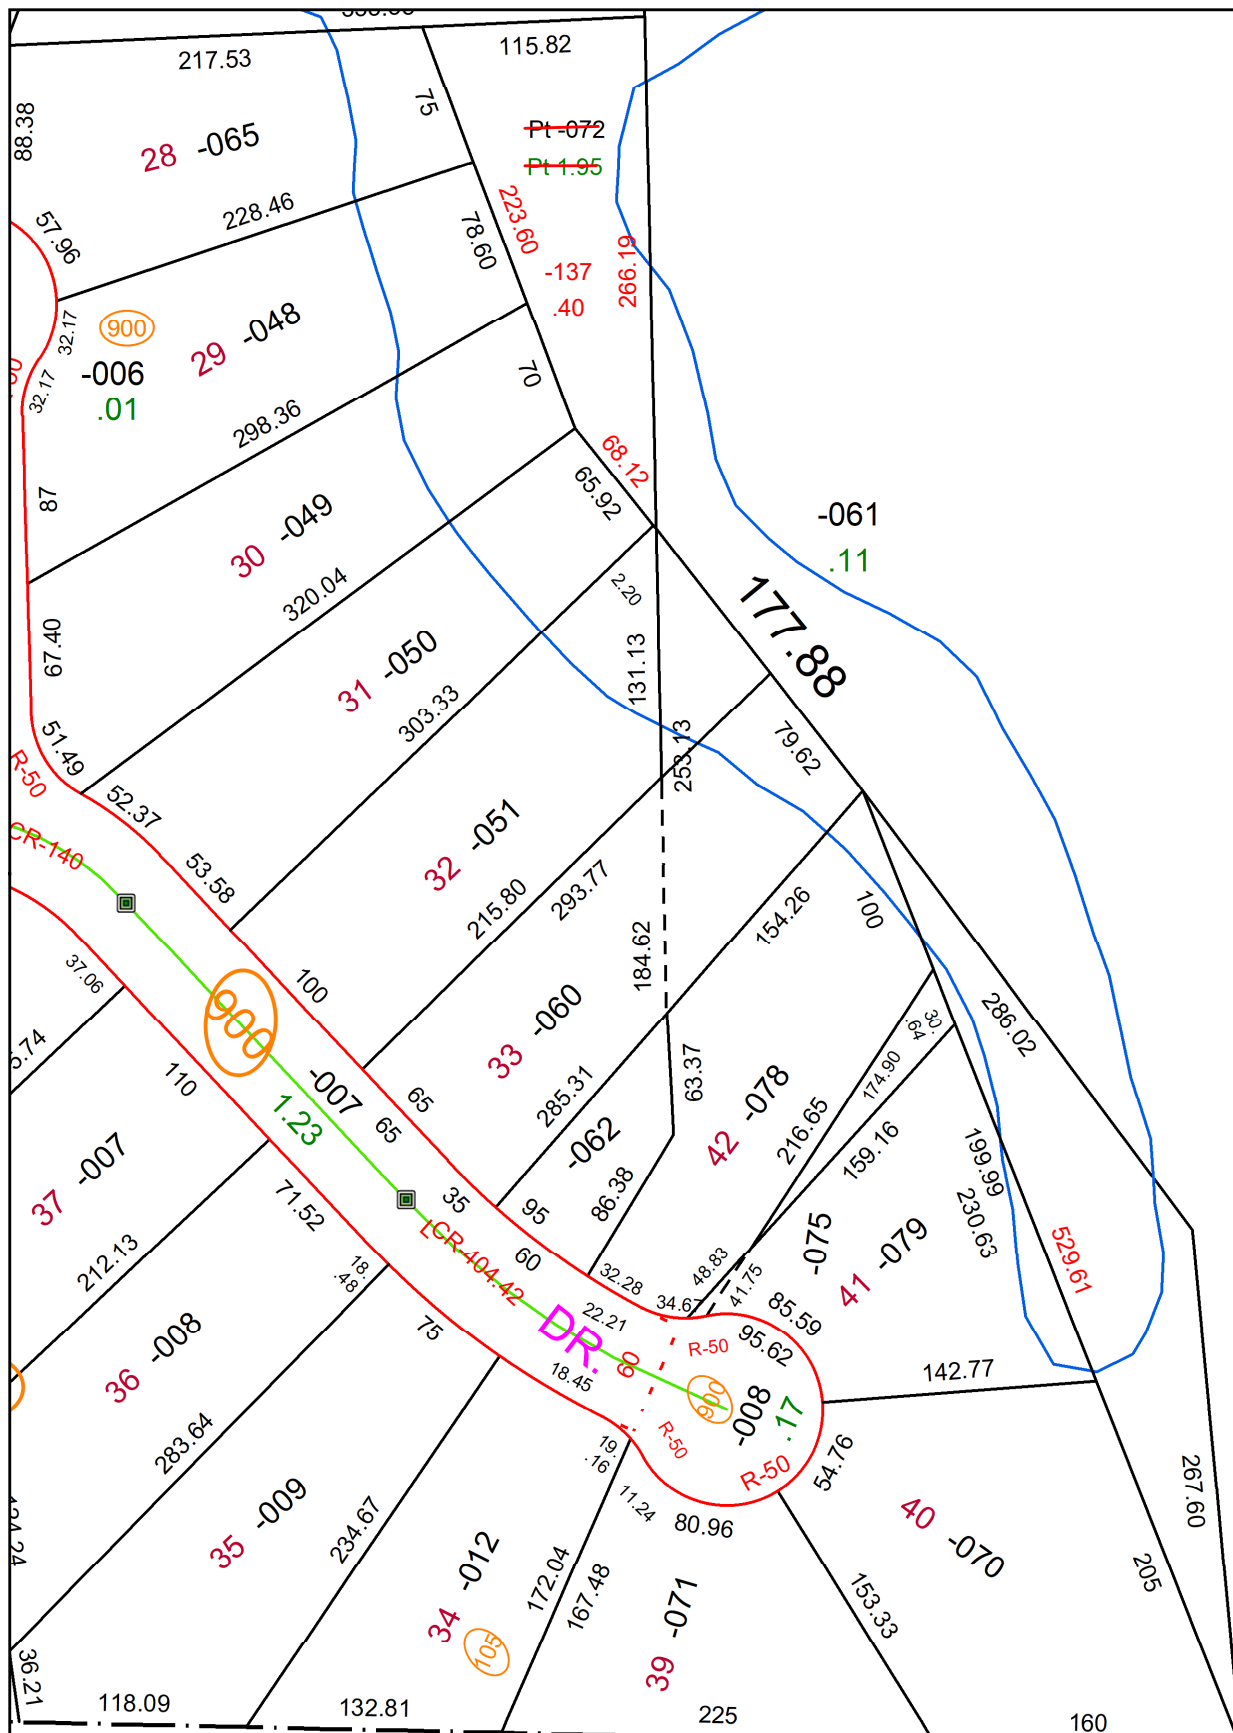


PARENT PARCEL: 01-00-005-104-072


CHILD PARCEL: 01-00-005-104-137, -138

STARTING POINT: **AC CORR PER SURV BY WILFREDO BARBOSA**

22-04592

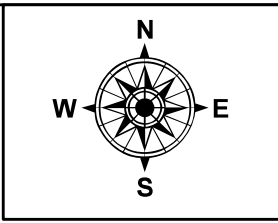

~~Pt-072~~  
~~Pt 1.95~~  
-138  
1.55  
.49

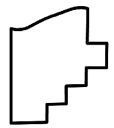

**SPLITS/DEEDS PROCESSED**  
LORAIN COUNTY TAX MAP DEPARTMENT  
226 MIDDLE AVE. ELYRIA, OH

SURVEYED BY: WILFREDO BARBOSA SURV # 50753  
CLOSURE: 1: 1303162  
MAP PAGE(S): 01-00-005-C  
APPROVED BY: AC DATE: December 12, 2022  
SCALE: 1 in = 100 ft PRIOR INSTRUMENT: 2022- 0884056