

PARENT PARCEL: 03-00-067-000-012 & -019

CHILD PARCEL: 03-00-067-000-045



STARTING POINT: CL OF FRENCH CREEK RD. & EAST RIVER RD.

22-04593



116.57	116.91	116.67	116.72	116
--------	--------	--------	--------	-----

240.52	80	240	160
--------	---------------	-----	----------------

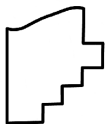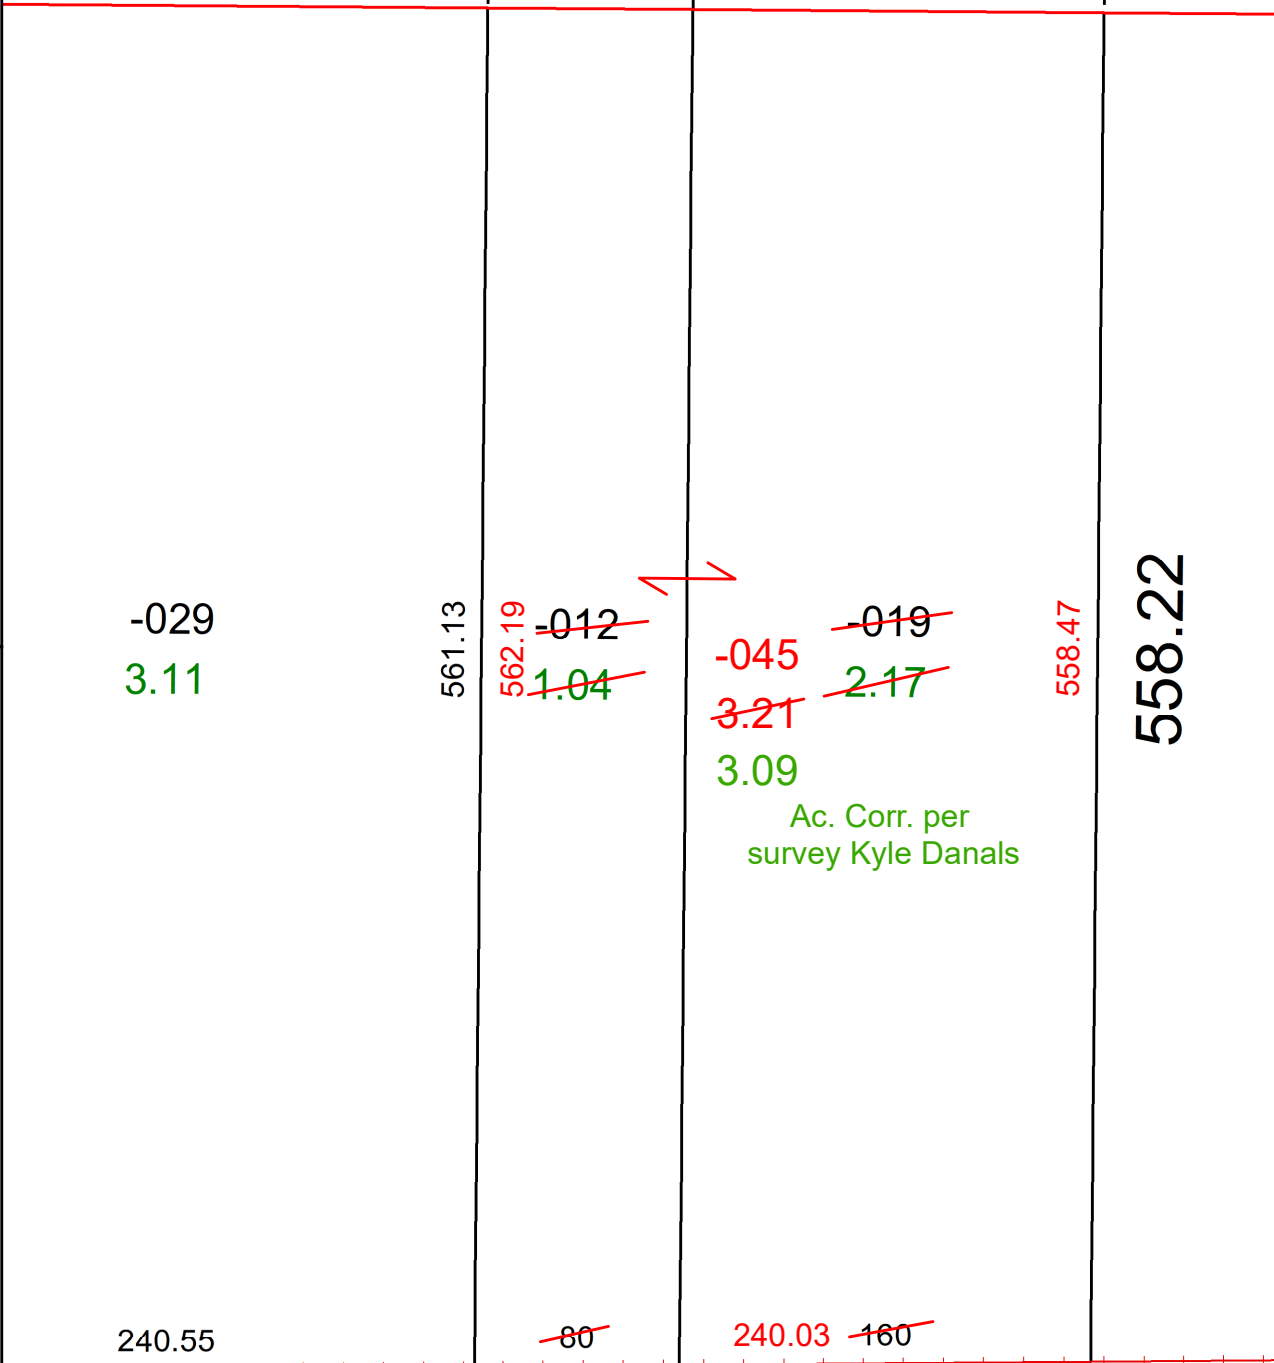

SPLITS/DEEDS PROCESSED
 LORAIN COUNTY TAX MAP DEPARTMENT
 226 MIDDLE AVE. ELYRIA, OH

SURVEYED BY: KYLE DANALS **SURVEY #:** 50754
CLOSURE: 1:1350884
MAP PAGE(S): 03-00-067
APPROVED BY: DMA **DATE:** 12/13/2022
SCALE: 1" = 75' **PRIOR INSTRUMENT:** 2022-0897268