PARENT PARCEL: <u>07-00-031-000-209 & -309</u>

CHILD PARCEL: CERTIFICAT OF CORRECTION

STARTING POINT: S/L 131 MILLRIDGE SUB. NO. 4

21-04595-C

CERTIFICATE OF CORRECTION

THIS IS TO CERTIFY that certain corrections need to be made to the plat of Millridge Subdivision Number 4 as recorded in Volume 109, Pages 21 through 24, inclusive of the Lorain County Plat Records.

The corrections required are as follows:

 Sublot 131 a 15-foot storm sewer easement should be added along the east property line.



Registered Surveyor Number 8469

Sworn to before me and subscribed in my presence this _____ day

of May, 2021.

Dan Stoc bliesen

This instrument prepared by Amy M. Kelly.



1 OF 2

SPLITS/DEEDS PROCESSED

LORAIN COUNTY TAX MAP DEPARTMENT 226 MIDDLE AVE. ELYRIA, OHIO

SURVEYED BY: <u>AMY KELLY</u> CLOSURE: <u>NA</u>

MAP PAGE(S): 07-00-031


APPROVED BY: <u>TJS</u> DATE: <u>6/7/2021</u> SCALE: <u>NA</u> PRIOR INST.: <u>PV. 109 PG. 21</u>

21-04595-C

PARENT PARCEL: <u>07-00-</u>031-000-209 & -309

CHILD PARCEL: CERTIFICAT OF CORRECTION

STARTING POINT: S/L 131 MILLRIDGE SUB. NO. 4

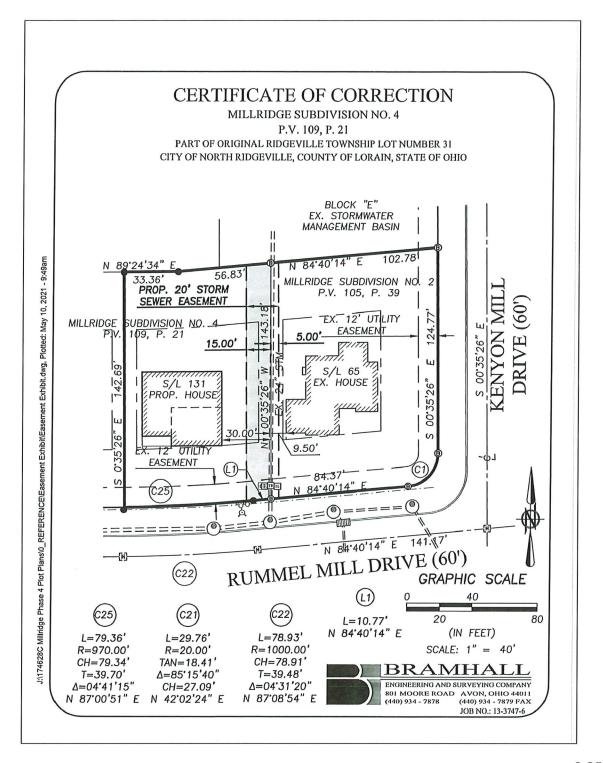

2 OF 2

SPLITS/DEEDS PROCESSED

LORAIN COUNTY TAX MAP DEPARTMENT 226 MIDDLE AVE. ELYRIA, OHIO

SURVEYED BY:_	AMY	KELLY
CLOSLIRE: NA		

MAP PAGE(S): 07-00-031

TJS 6/7/2021 APPROVED BY:___ DATE:_ PRIOR INST.: PV. 109 PG. 21 SCALE: NA