
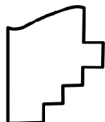


PARENT PARCEL: 05-00-020-000-259

CHILD PARCEL: 05-00-020-000-260 & -261 STRAIGHT TRANS. OF 05-00-021-102-043

STARTING POINT: I.P. MON. BOX, CL OF HOLLSTEIN DR. & CL OF COOPER-FOSTER PARK RD.

22-04595

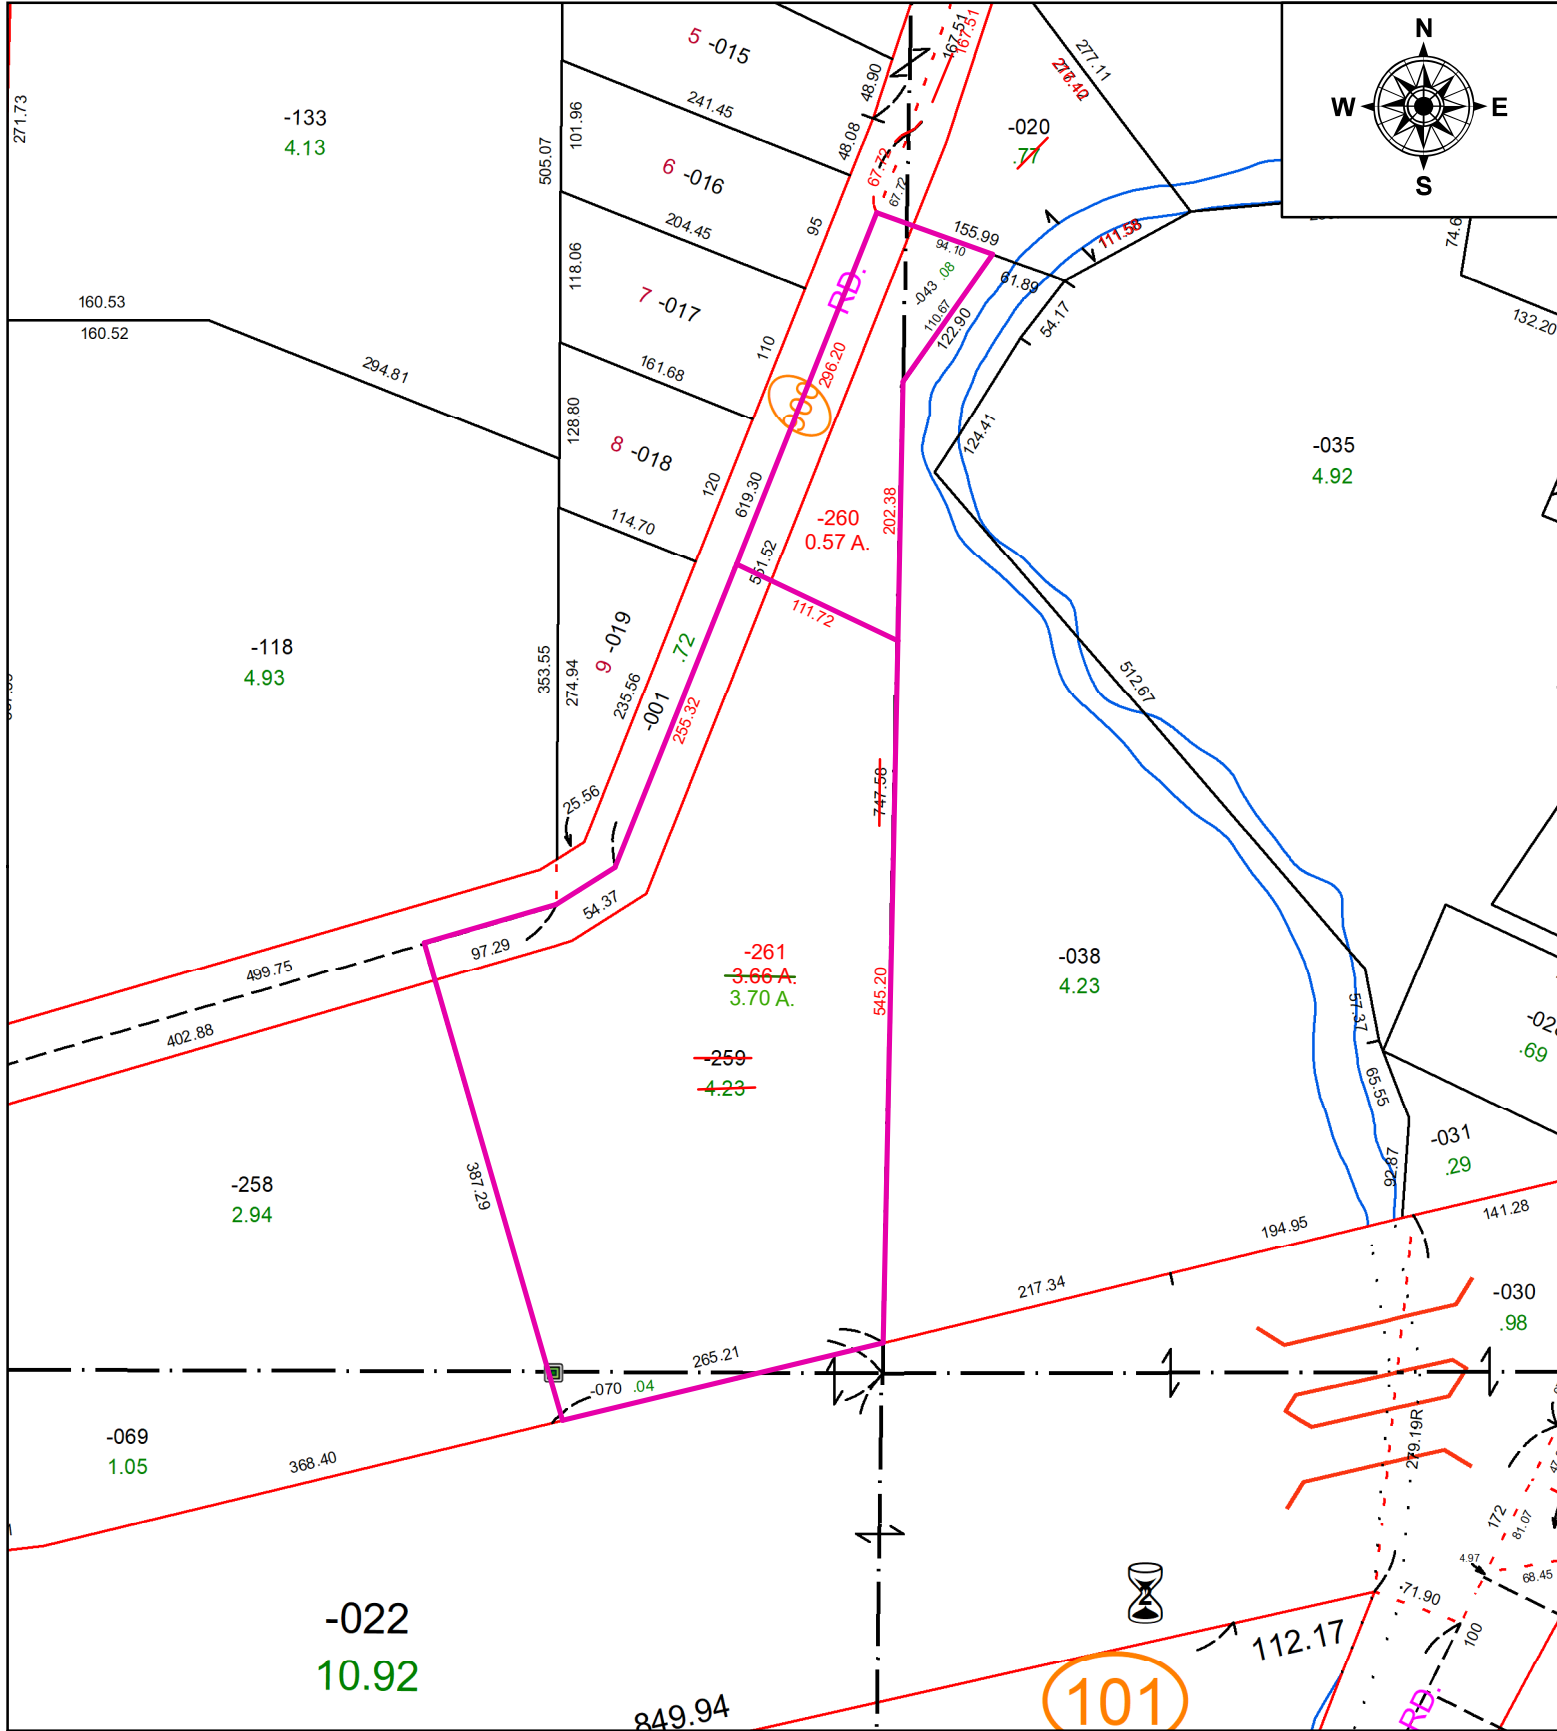

SPLITS/DEEDS PROCESSED
 LORAIN COUNTY TAX MAP DEPARTMENT
 226 MIDDLE AVE. ELYRIA, OH

SURVEYED BY: MIKE SPELLACY
 CLOSURE: 1: INF
 MAP PAGE(S): 05-00-019, -020, -021
 APPROVED BY: TJS DATE: 12/13/2022
 SCALE: 1" = 150' PRIOR INSTRUMENT: 20200786373