


PARENT PARCEL: 06-22-010-000-011

CHILD PARCEL: **MAP CORRECTION ONLY**

STARTING POINT: C/L OF W RIVER AND S LINE OF OL 10 IN BURRELL-DAY TRACT

21-04596-C

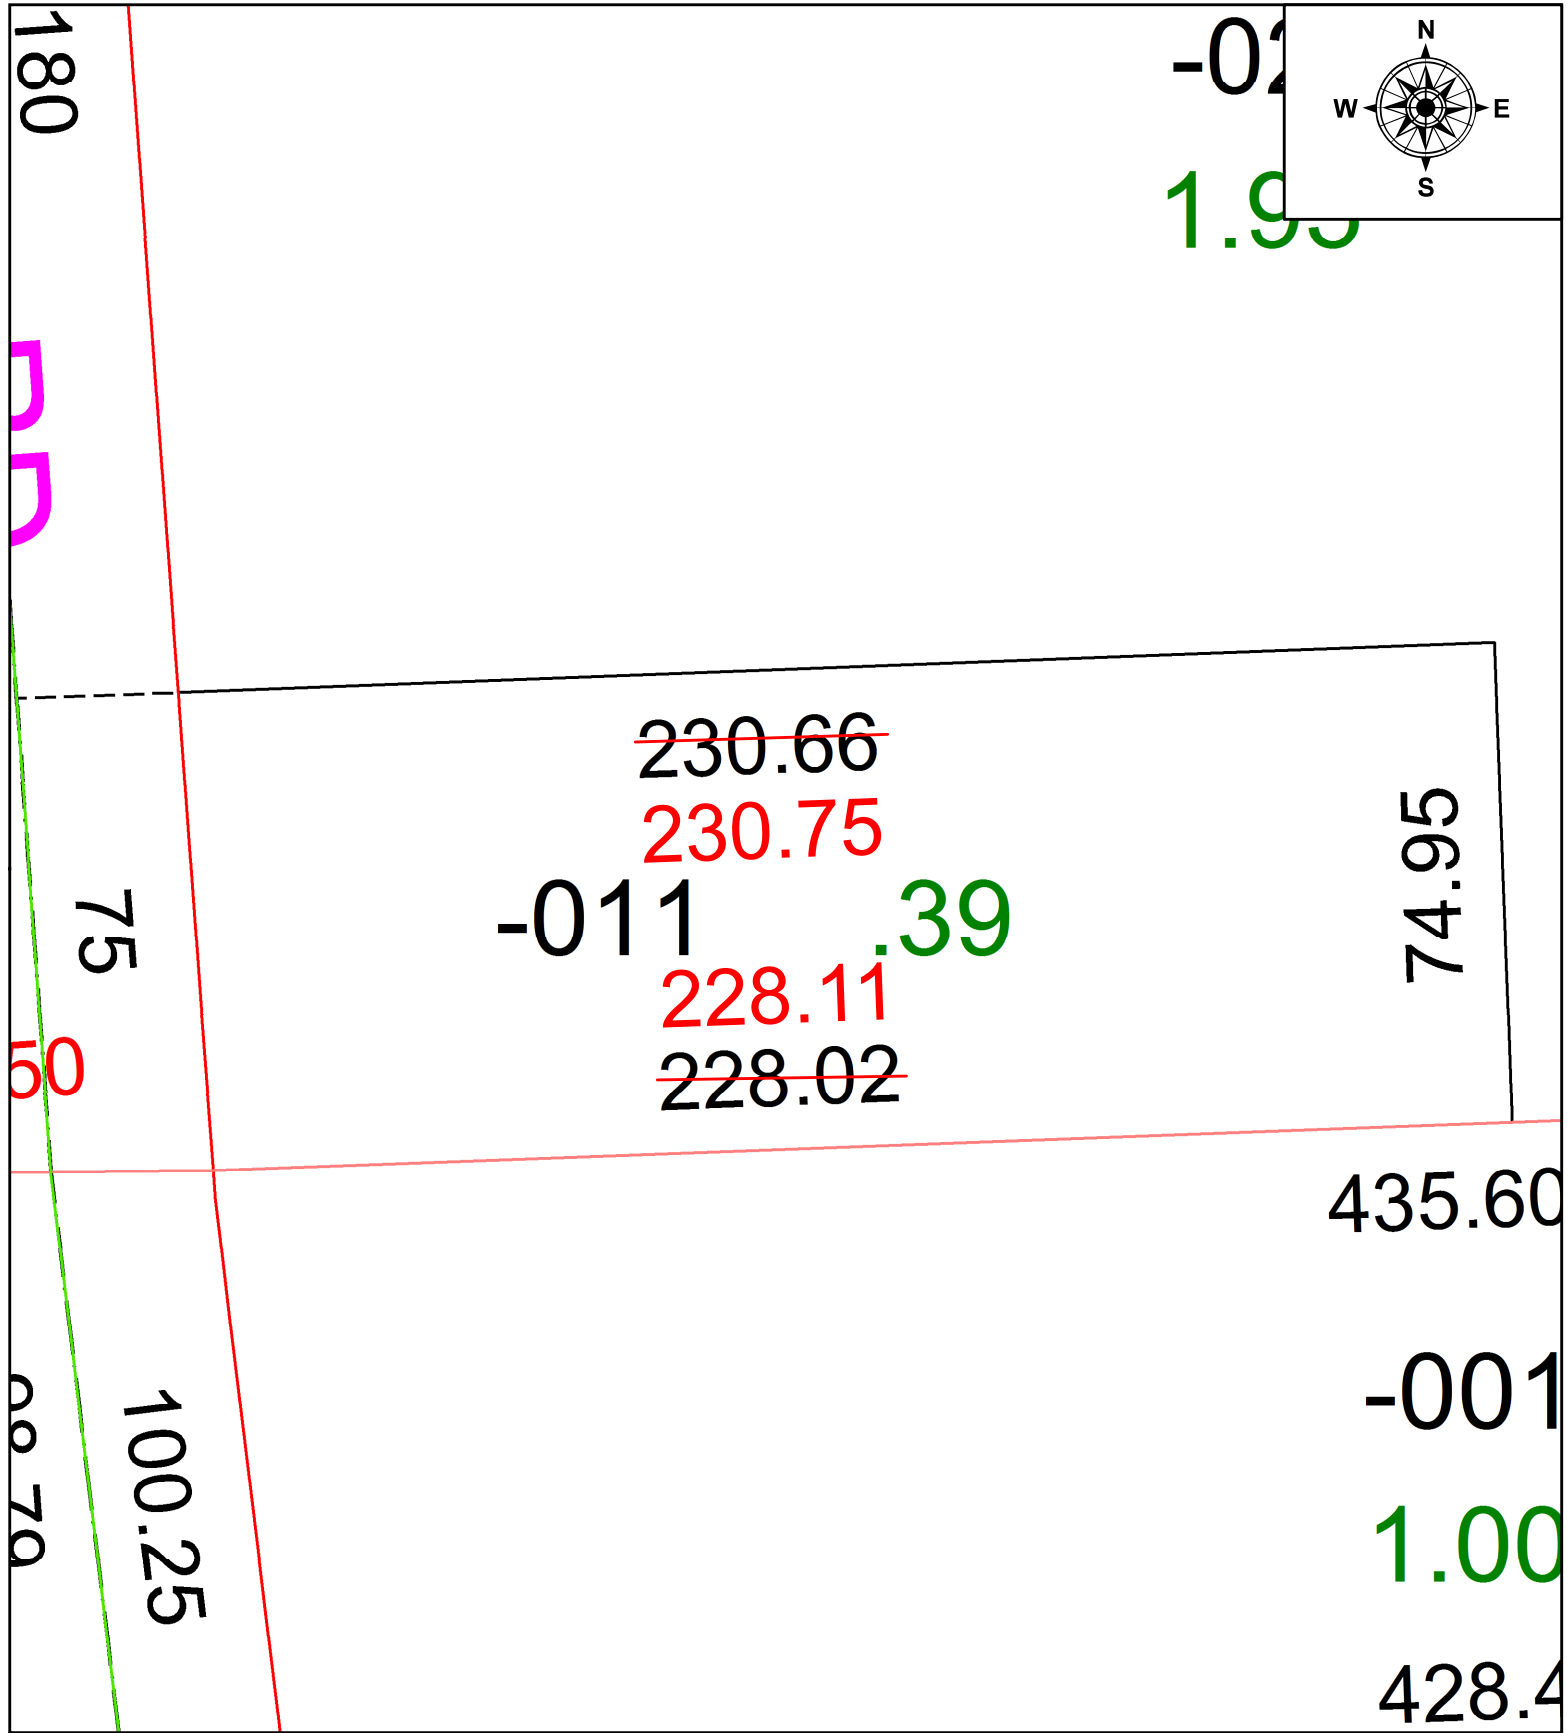

SPLITS/DEEDS PROCESSED
 LORAIN COUNTY TAX MAP DEPARTMENT
 226 MIDDLE AVE. ELYRIA, OH

SURVEYED BY: THEODORE J. SPILLMAN

CLOSURE: 1: 153499

MAP PAGE(S): 06-11

APPROVED BY: AC **DATE:** 6/25/2021

SCALE: 1" = 30' **PRIOR INSTRUMENT:** 2017-0615338