
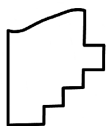


PARENT PARCEL: 04-00-030-133-044

CHILD PARCEL: 04-00-030-133-049 & -050

STARTING POINT: UNCOMBINATION PER INSTRUMENT # 2021-0799602

21-04597-U

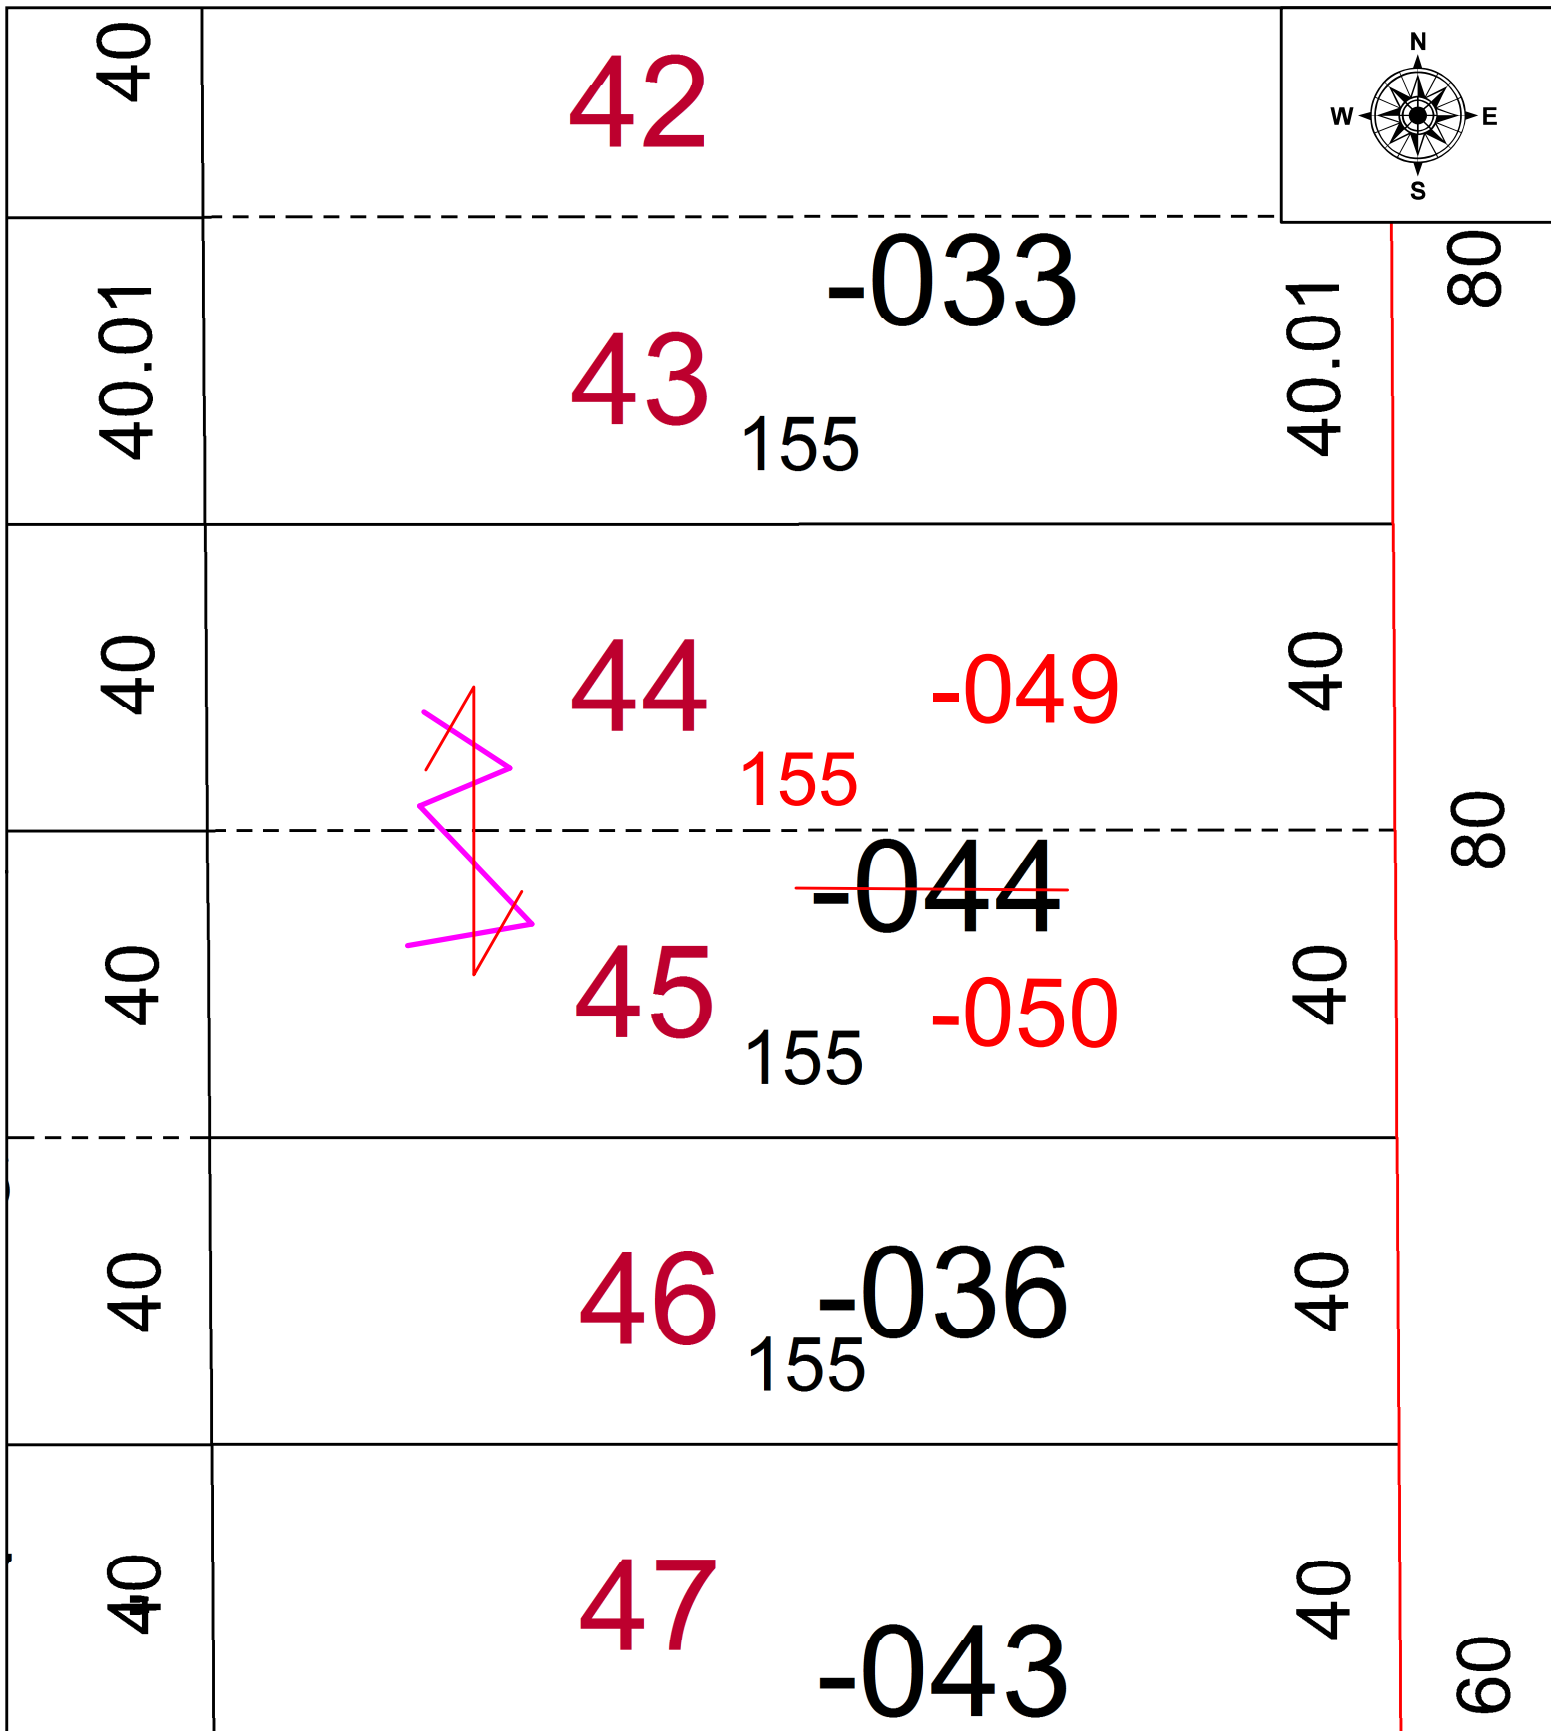

SPLITS/DEEDS PROCESSED
 LORAIN COUNTY TAX MAP DEPARTMENT
 226 MIDDLE AVE. ELYRIA, OH

SURVEYED BY: _____ N/A
 CLOSURE: _____ N/A
 MAP PAGE(S): 04-00-030
 APPROVED BY: _____ WRZ DATE: 6-29-2021
 SCALE: 1" = 25' PRIOR INSTRUMENT: 2021-0799602