
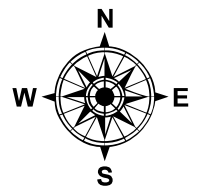


PARENT PARCEL: 09-00-004-101-037 & -058

CHILD PARCEL: 09-00-004-101-064

STARTING POINT: CL OF ANNIS RD. & NORTHERLY LINE O.L. 4

22-04597

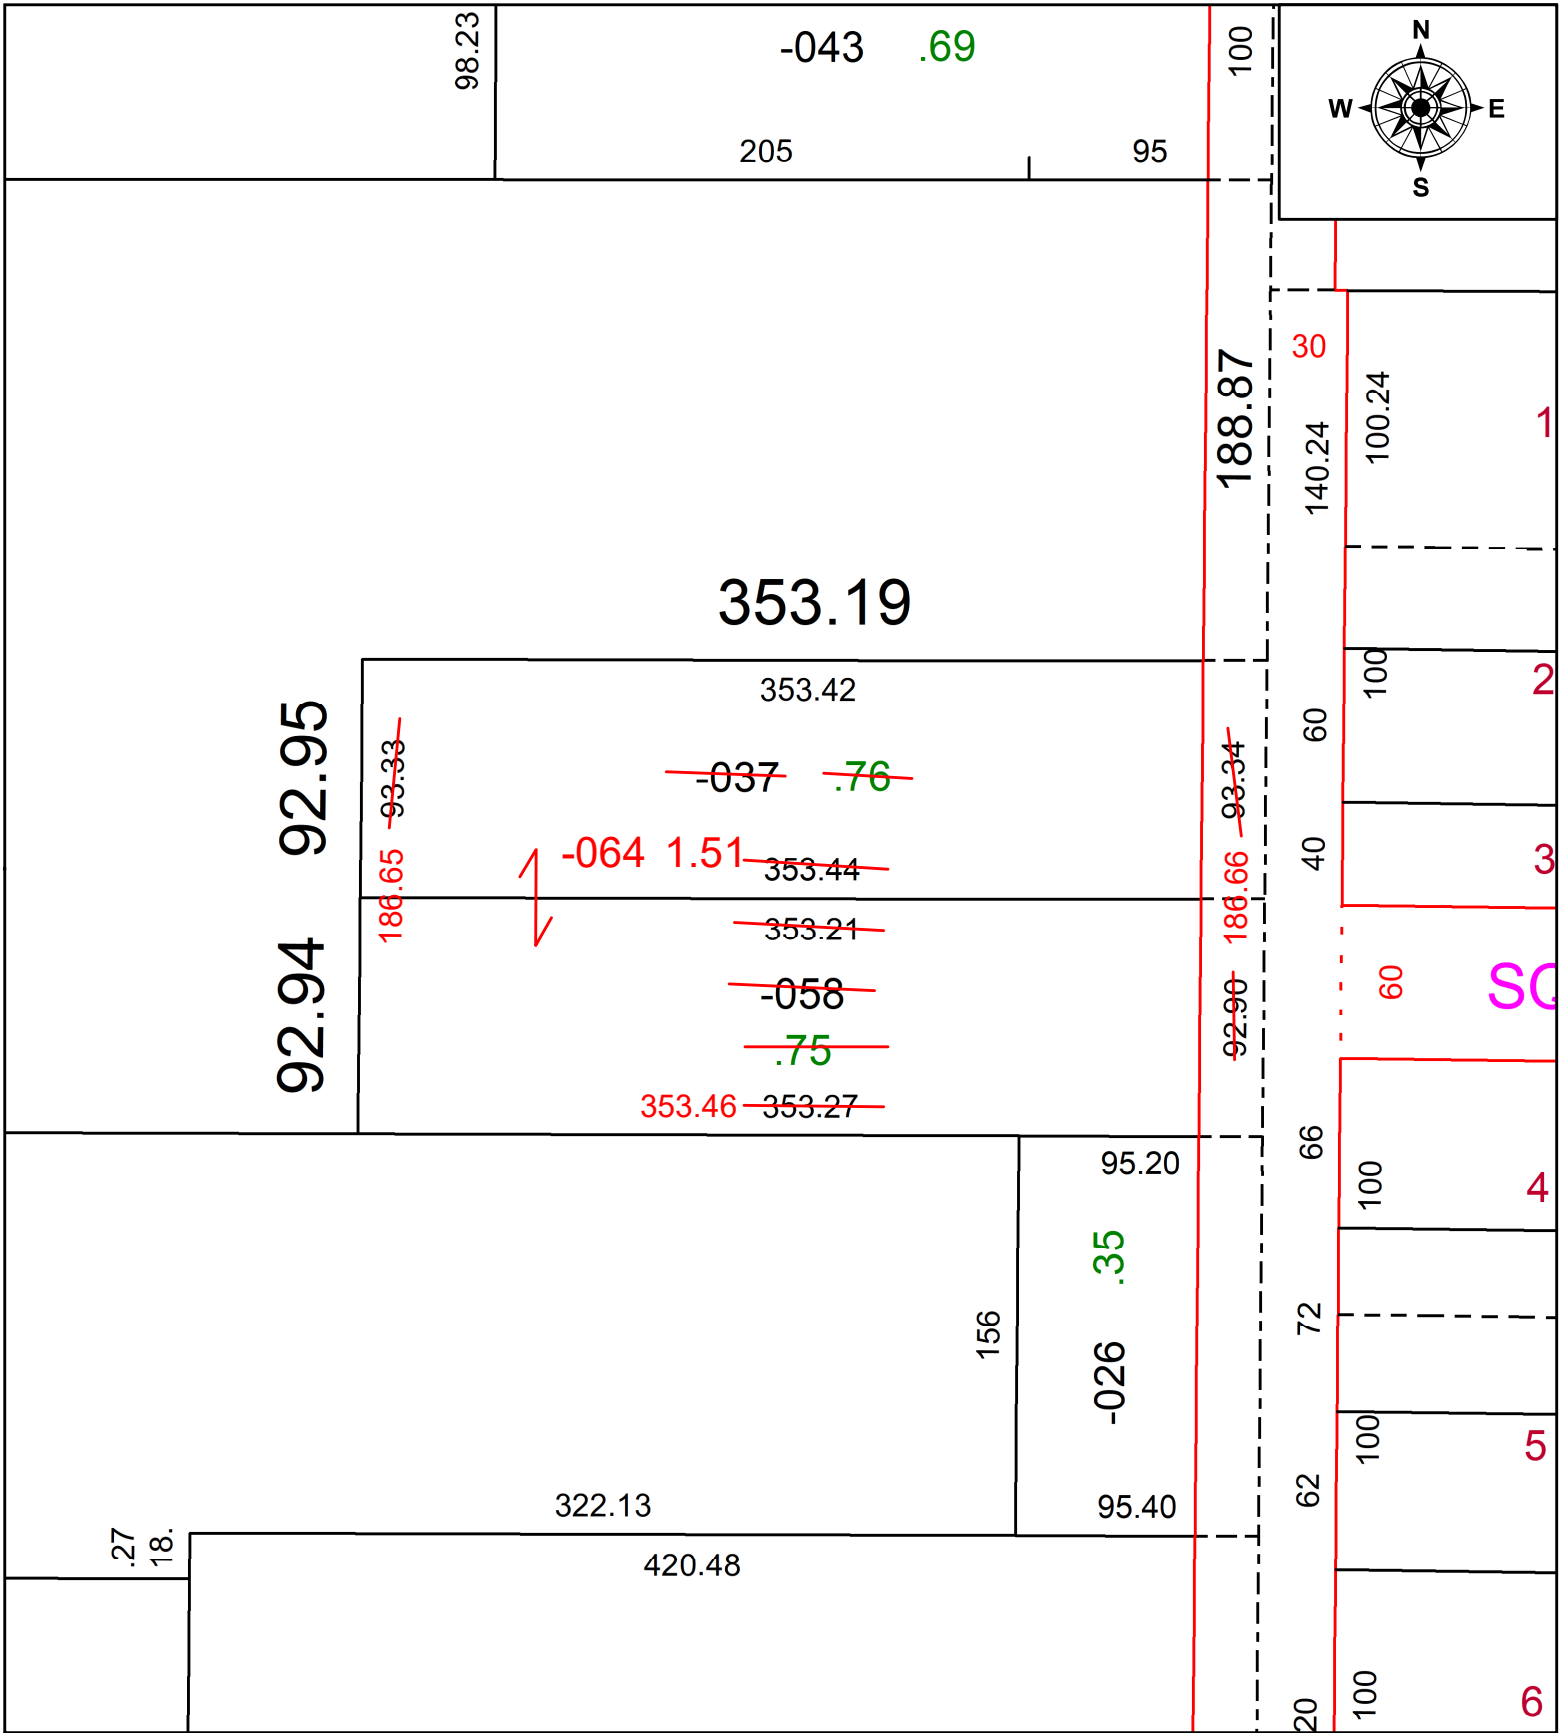

92.94 92.95

-043 .69

205

95

188.87

353.19

353.42

~~-037~~ ~~.76~~

~~-064~~ 1.51 ~~353.44~~

~~353.21~~

~~-058~~

~~.75~~

~~353.46~~ ~~353.27~~

~~186.65~~ ~~93.33~~

~~92.90~~ ~~186.66~~ ~~93.34~~

95.20

-026 .35

156

322.13

95.40

.27
18.

420.48

30

140.24

100.24

100

60

40

66

72

62

20

100

100

1

2


3

SC

4

5

6

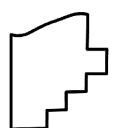

SPLITS/DEEDS PROCESSED
 LORAIN COUNTY TAX MAP DEPARTMENT
 226 MIDDLE AVE. ELYRIA, OH

SURVEYED BY: WILLIAM WALLACE SURVEY #: 50774
 CLOSURE: 1:513700
 MAP PAGE(S): 09-00-004
 APPROVED BY: DMA DATE: 1/9/2023
 SCALE: 1" = 75' PRIOR INSTRUMENT: 2018-0695141