



PARENT PARCEL: ADD TO DUP
CHILD PARCEL: 01-00-002-118-041, 01-00-002-122-035
STARTING POINT: PER ORDINANCE 2021-36

21-04598-V

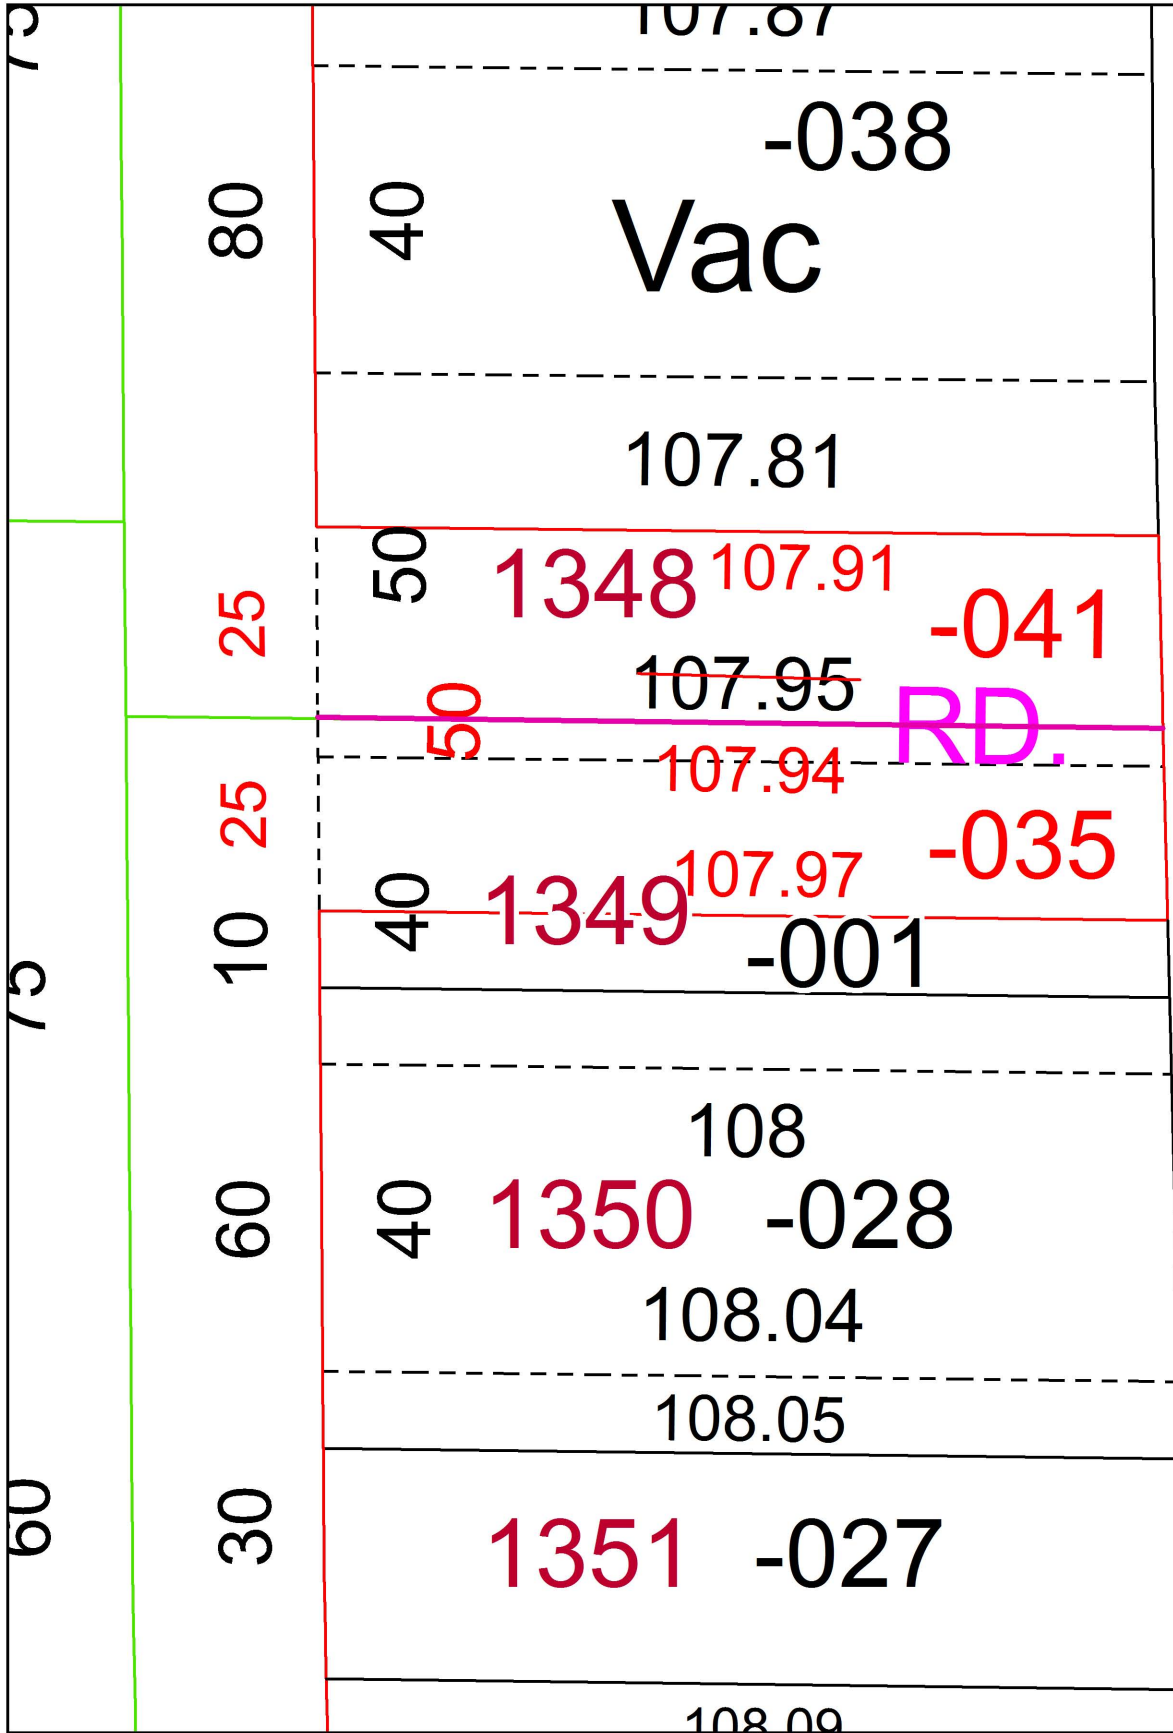

842.55

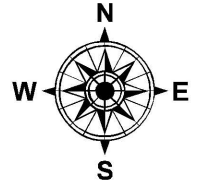

SPLITS/DEEDS PROCESSED
LORAIN COUNTY TAX MAP DEPARTMENT
226 MIDDLE AVE. ELYRIA, OH

SURVEYED BY: PATRICK A. MCGANNON
CLOSURE: 1: 17919
MAP PAGE(S): 01-00-002-D
APPROVED BY: AC DATE: 6/29/2021
SCALE: 1" = 25' PRIOR INSTRUMENT: VOL. 23 PG. 20