


PARENT PARCEL: 06-22-017-102-025

CHILD PARCEL: **ACREAGE CORRECTION**

STARTING POINT: C/L GLADYS AVE AND N. LINE OF OL 17

21-04599-C

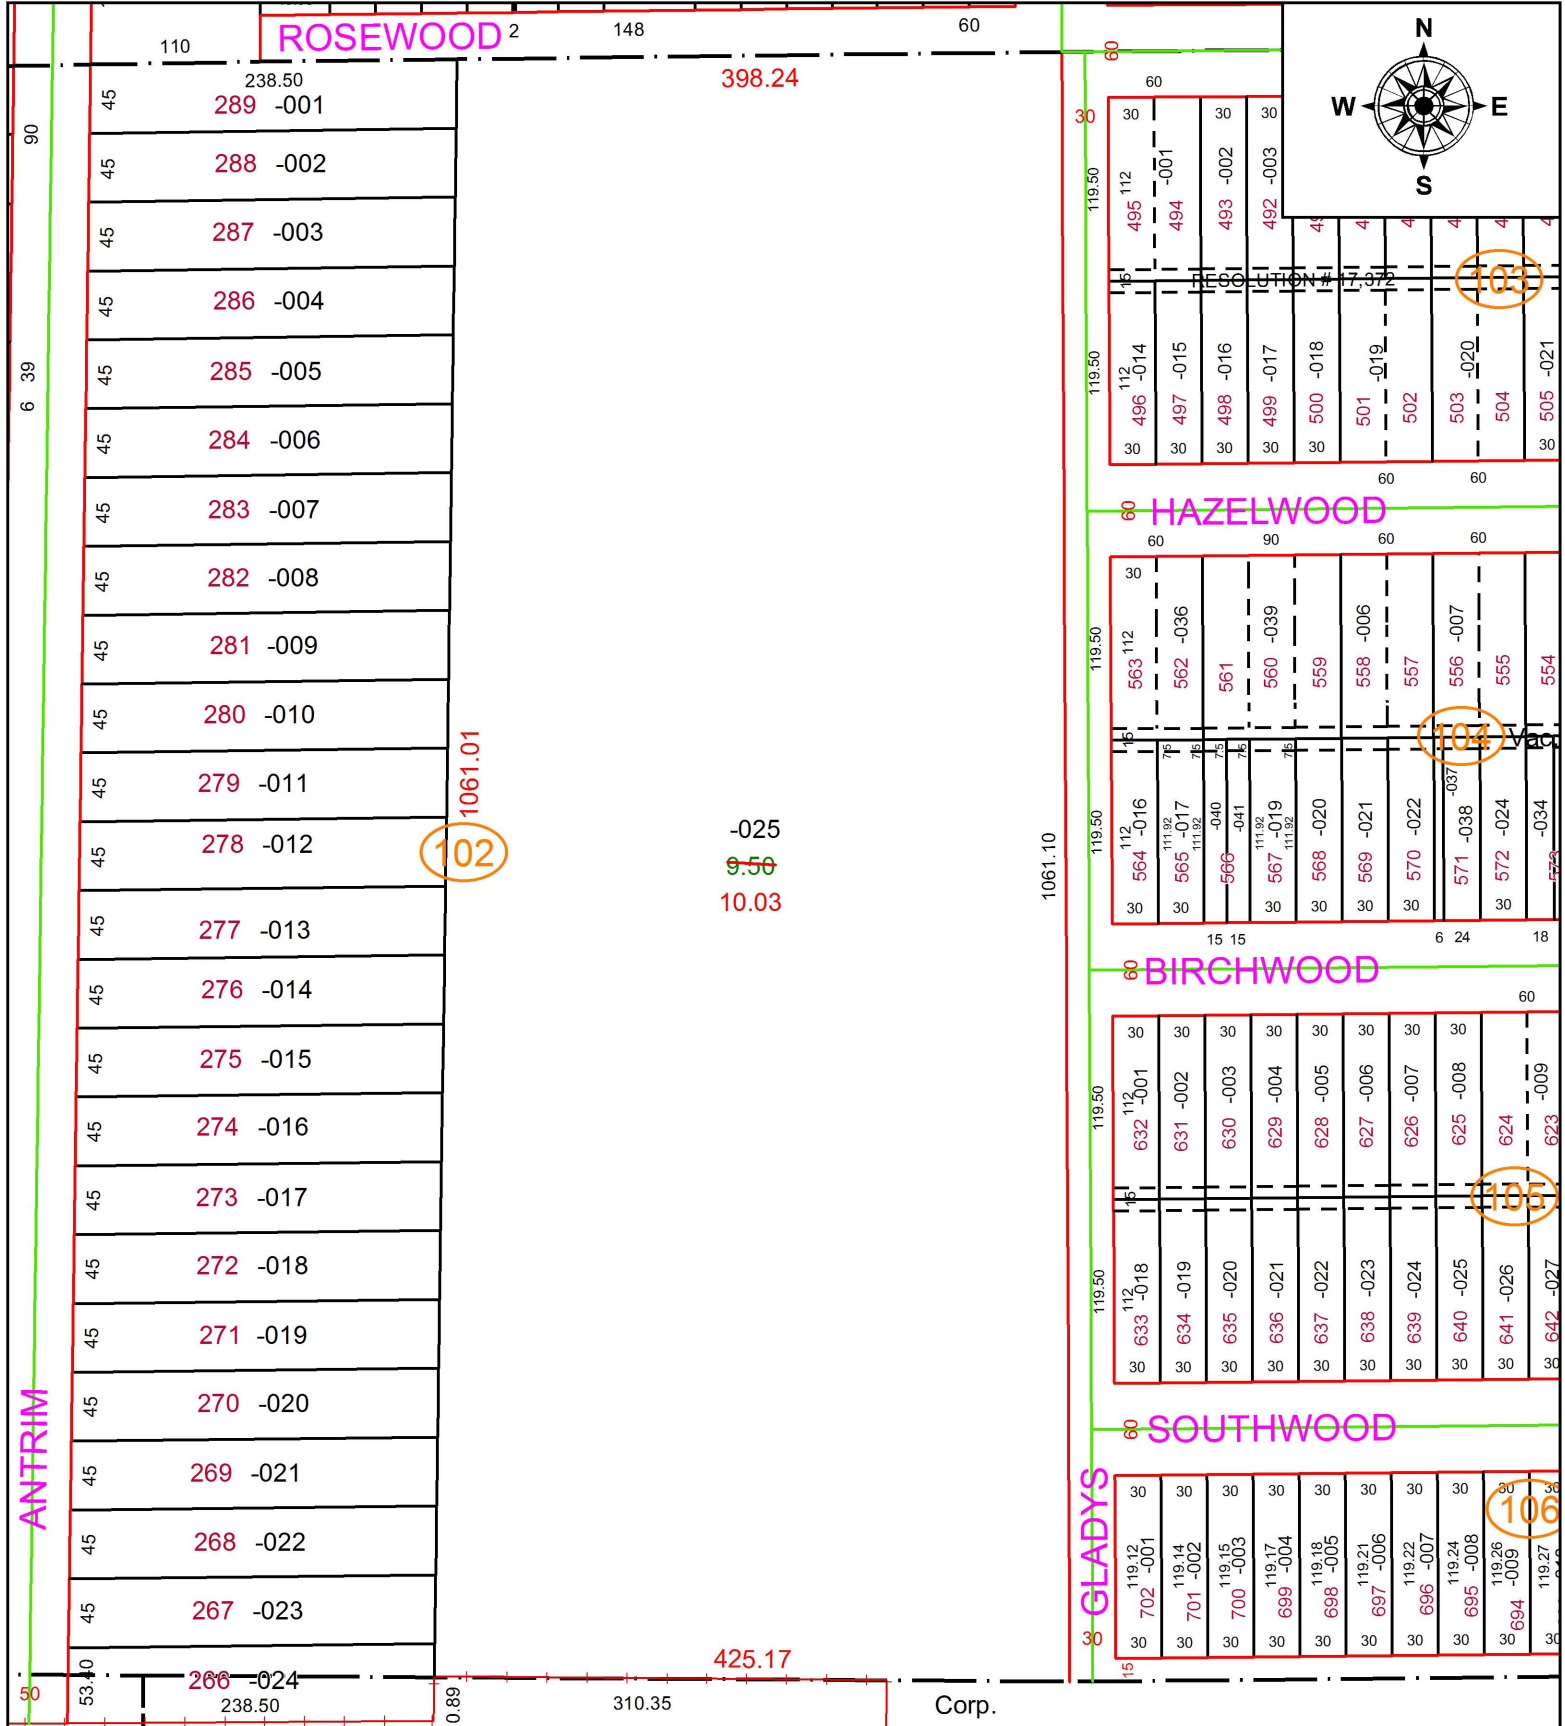

SPLITS/DEEDS PROCESSED
 LORAIN COUNTY TAX MAP DEPARTMENT
 226 MIDDLE AVE. ELYRIA, OH

SURVEYED BY: WILFREDO BARBOSA

CLOSURE: 1: 463567

MAP PAGE(S): 06-7

APPROVED BY: AC **DATE:** 7/1/2021

SCALE: 1" = 125 **PRIOR INSTRUMENT:** 2016-0579375