

PARENT PARCEL:

04-00-010-113-041 & -193

CHILD PARCEL:




04-00-010-113-195 & -196

N/A

22-04600

STARTING POINT:

INTERSECTION OF WESTERLY LINE OF O.L. 10 & C/L OF FRENCH CREEK RD

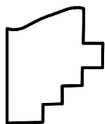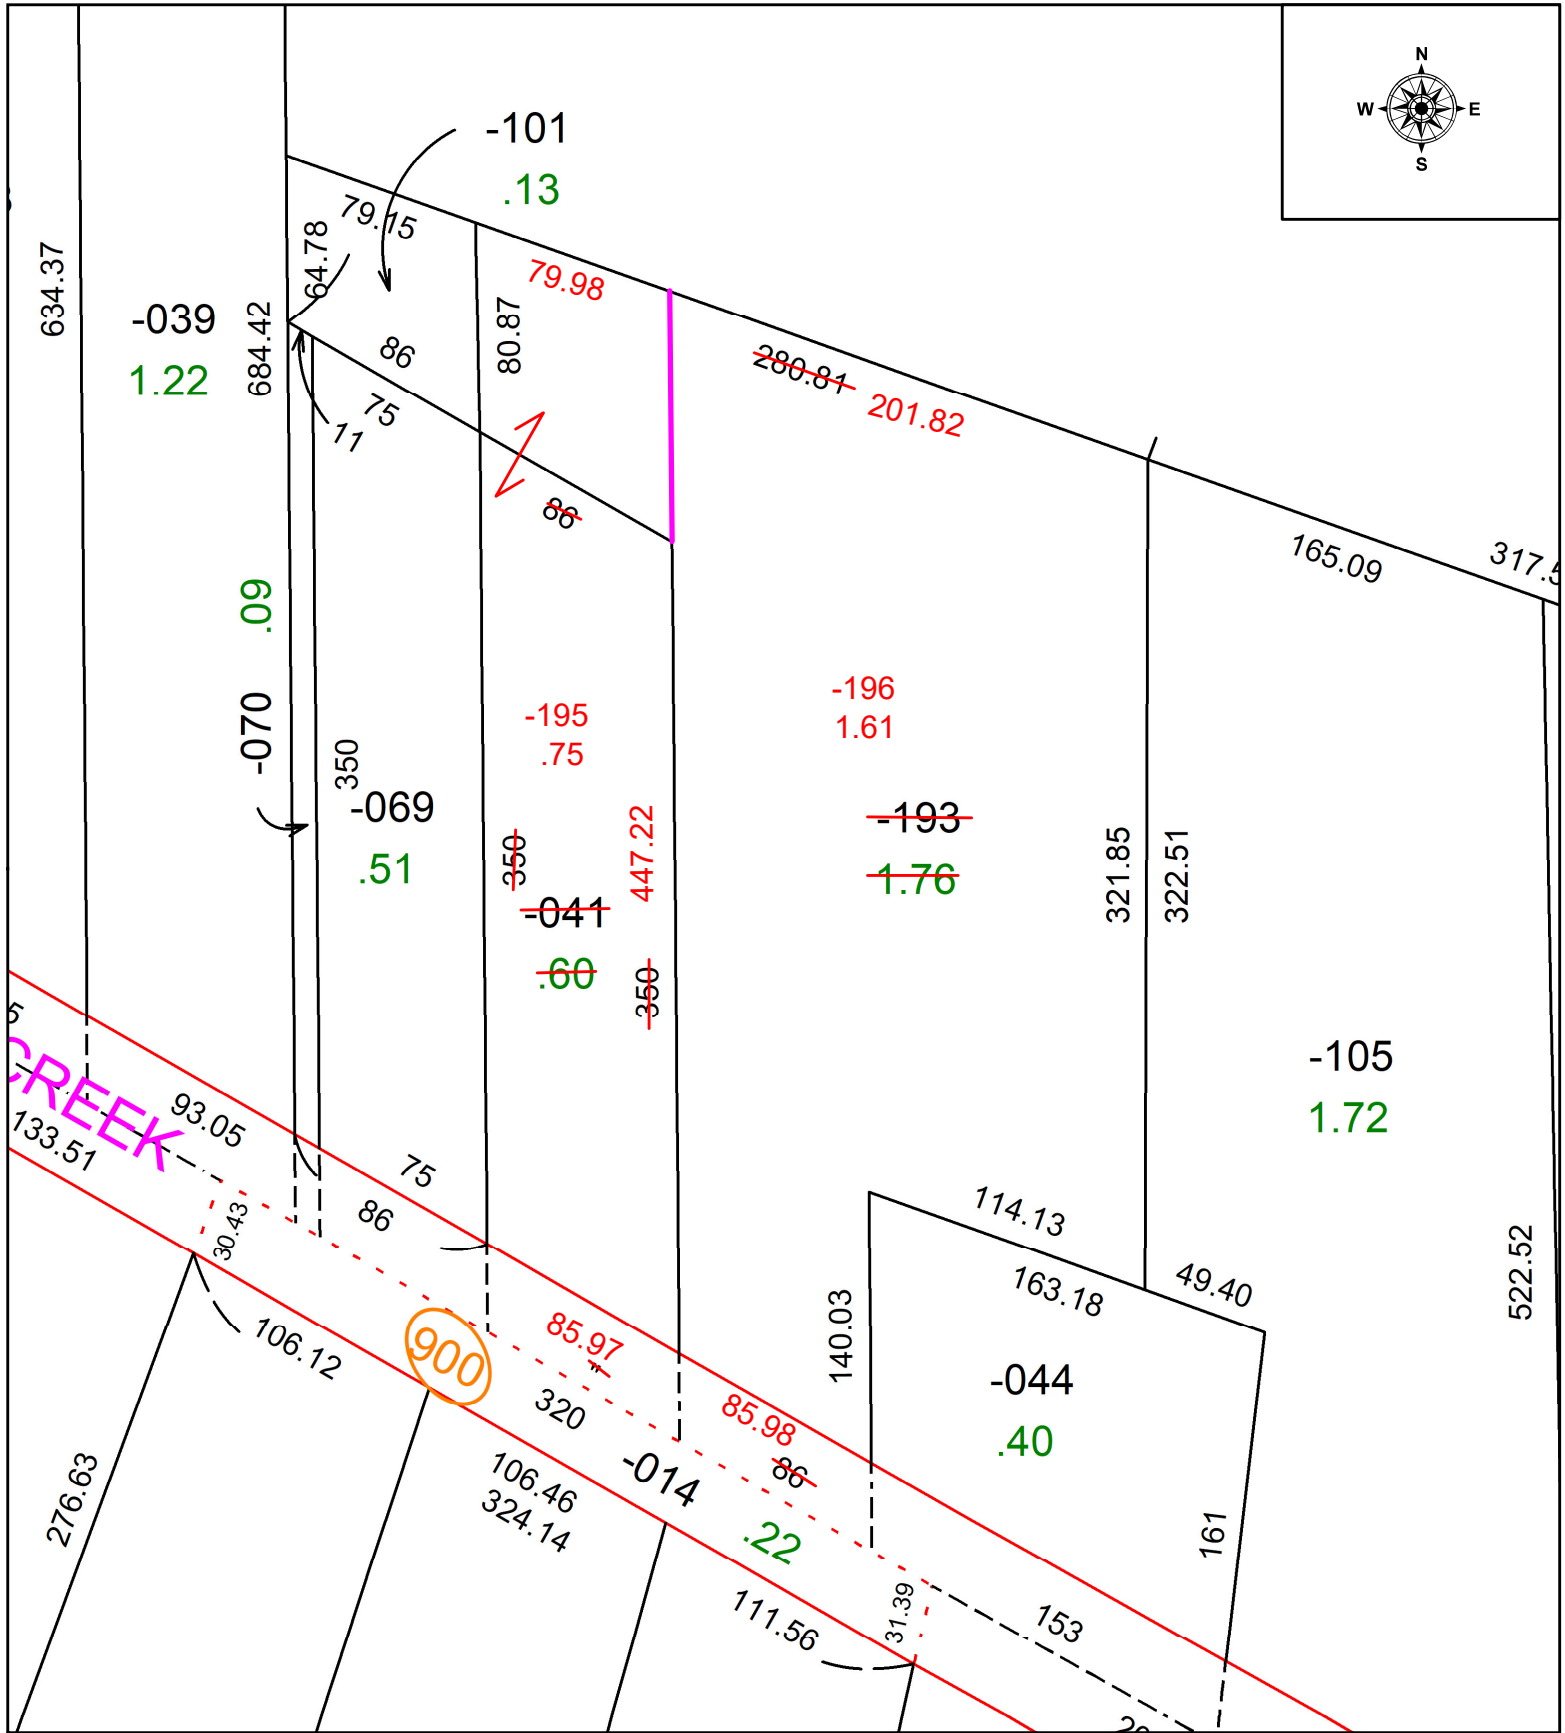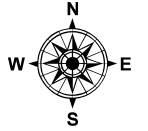

SPLITS/DEEDS PROCESSED
LORAIN COUNTY TAX MAP DEPARTMENT
226 MIDDLE AVE. ELYRIA, OH

SURVEYED BY: PATRICK MCGANNON SURVEY # 50763
CLOSURE: 1: 202867
MAP PAGE(S): 04-00-010
APPROVED BY: WRZ DATE: 12/19/2022
SCALE: 1" = 75 PRIOR INSTRUMENT: #1998-0567307