



PARENT PARCEL: 15-00-035-000-111

CHILD PARCEL: 15-00-035-000-311, -312, & -313


N/A

22-04601

STARTING POINT: NORTHWESTERLY CORNER OF VICKSBURG COURT CONDOMINIUM PH. 1

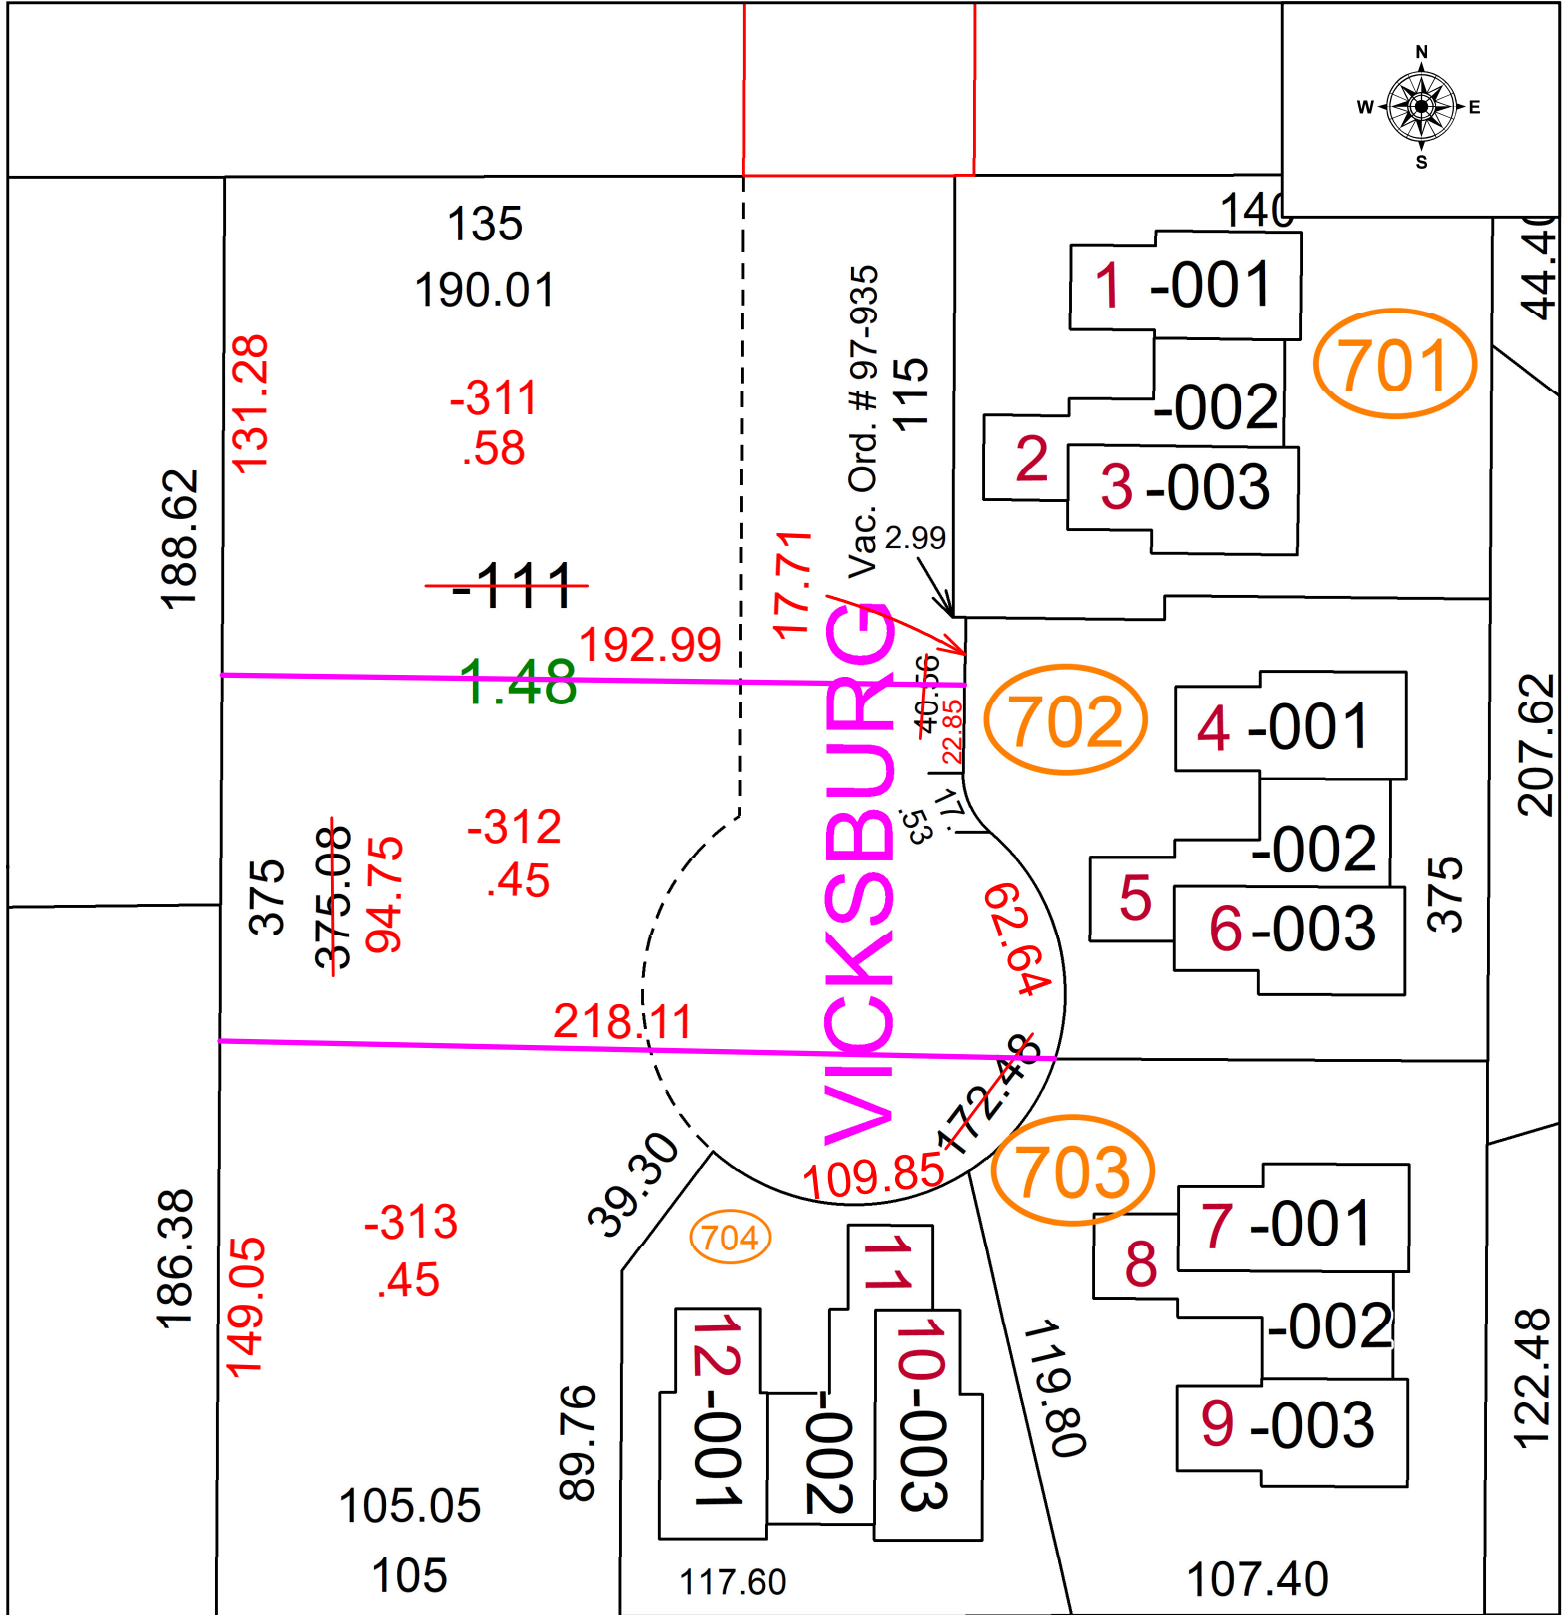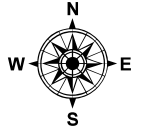

975

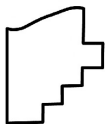

SPLITS/DEEDS PROCESSED
 LORAIN COUNTY TAX MAP DEPARTMENT
 226 MIDDLE AVE. ELYRIA, OH

SURVEYED BY: THOMAS SIMON SURVEY # 50775
 CLOSURE: 1: 111806
 MAP PAGE(S): 15-00-035
 APPROVED BY: WRZ DATE: 1/9/2023
 SCALE: 1" = 50' PRIOR INSTRUMENT: #2021-0856237