
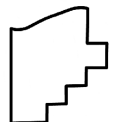


PARENT PARCEL: 11-00-049-000-016
 CHILD PARCEL: 11-00-049-000-021 & -022
 STARTING POINT: CL OF COOLEY RD. & S.R. 83.

22-04603

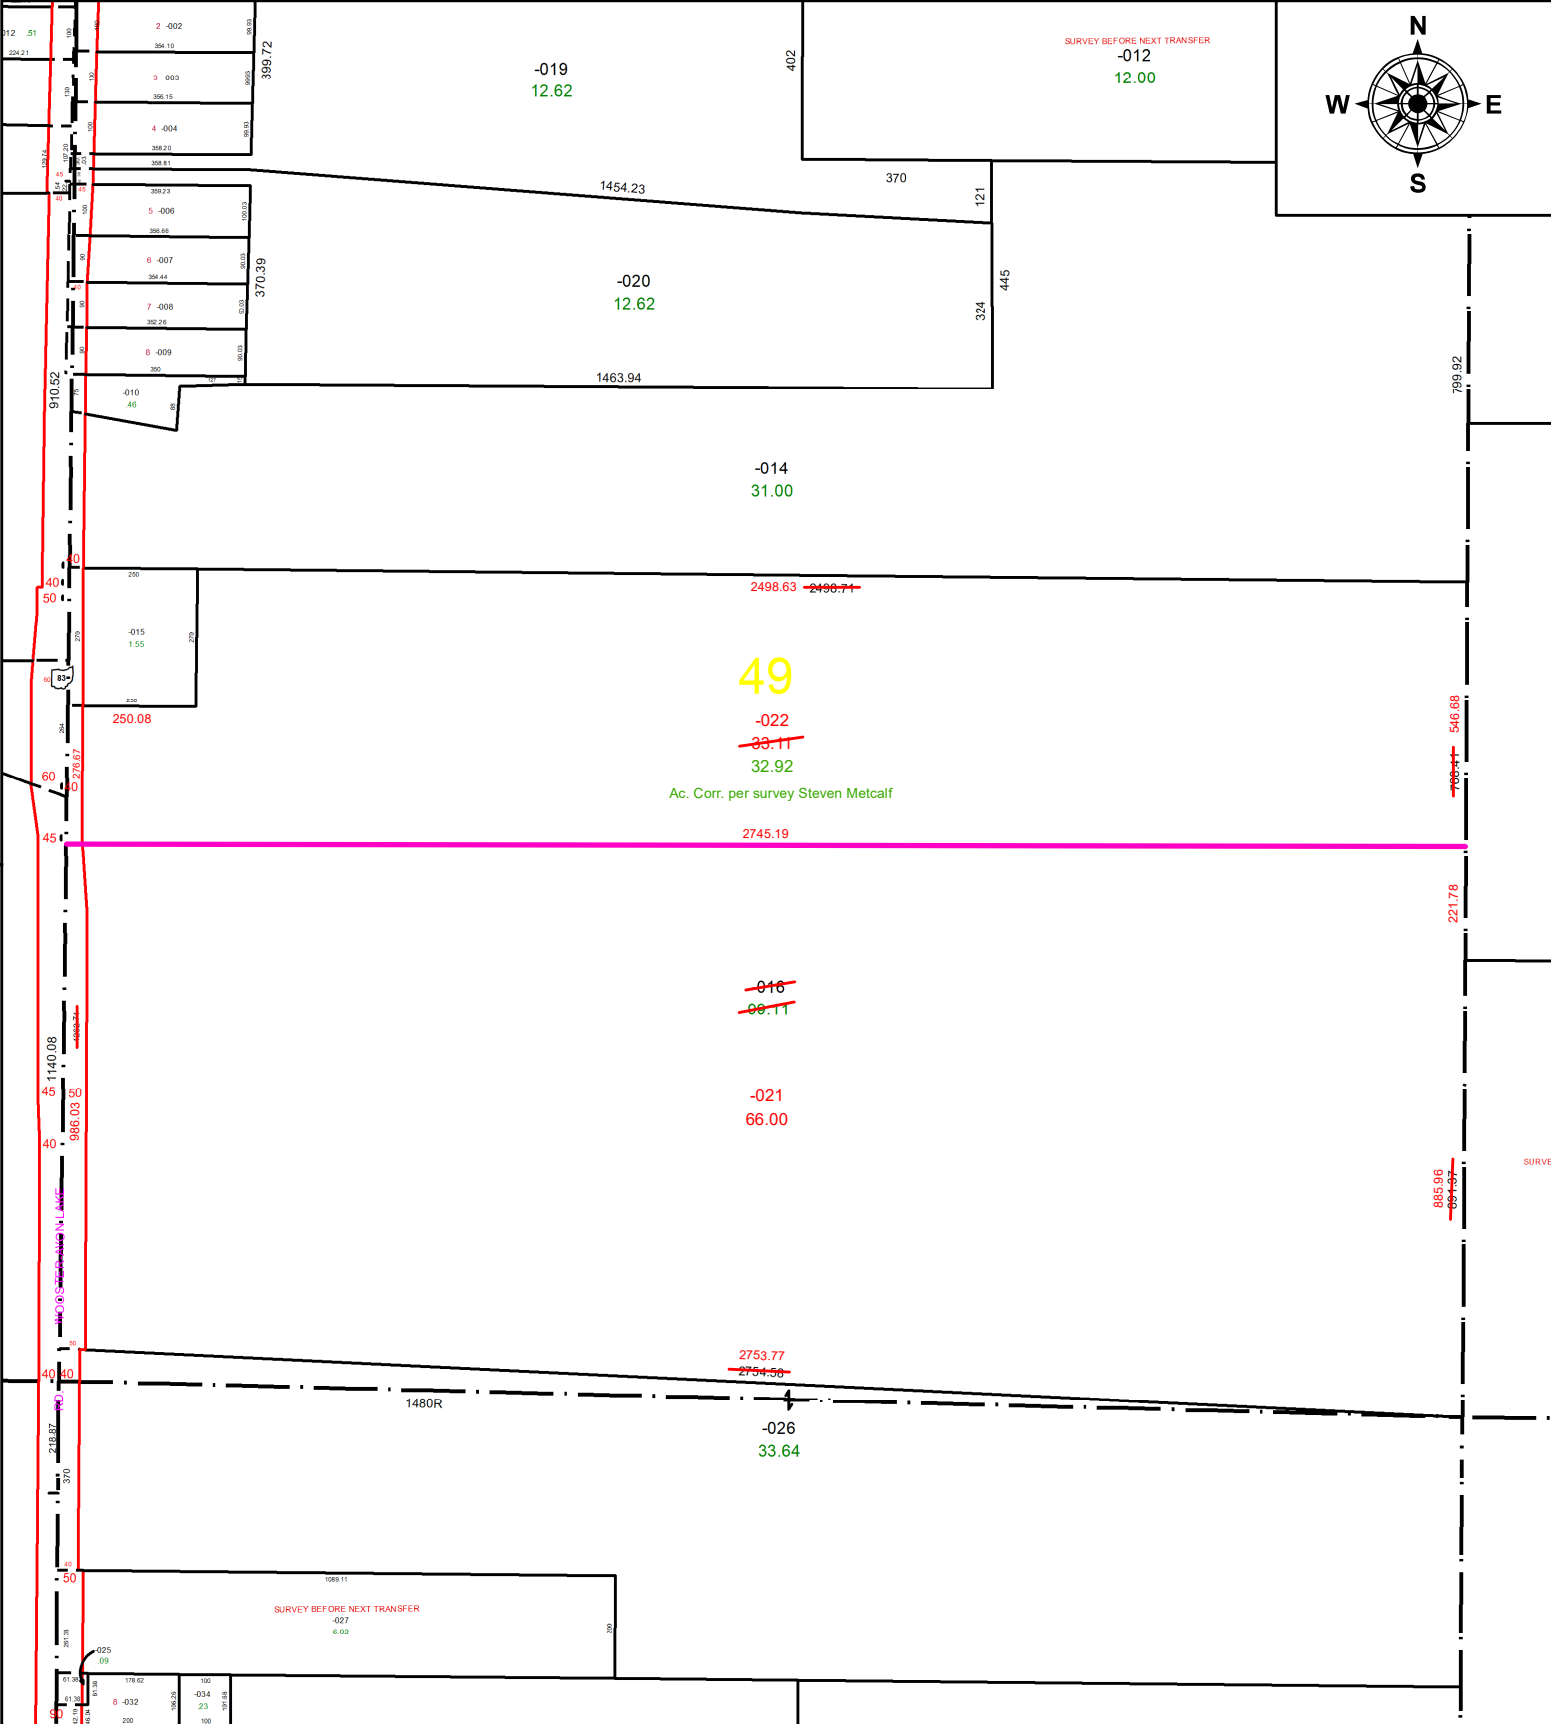

SPLITS/DEEDS PROCESSED
 LORAIN COUNTY TAX MAP DEPARTMENT
 226 MIDDLE AVE. ELYRIA, OH

SURVEYED BY: STEVEN METCALF **SURVEY #:** 50766
CLOSURE: 1:1098401
MAP PAGE(S): 11-00-049
APPROVED BY: DMA **DATE:** 12/22/2022
SCALE: 1" = 375' **PRIOR INSTRUMENT:** 2021-0856434