
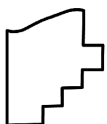


PARENT PARCEL: 05-00-055-000-019

CHILD PARCEL: **AC CORR FROM 0.54 PER SURV BY THOMAS SIMON**

STARTING POINT: SE CORNER OF OL 55

21-04604-C

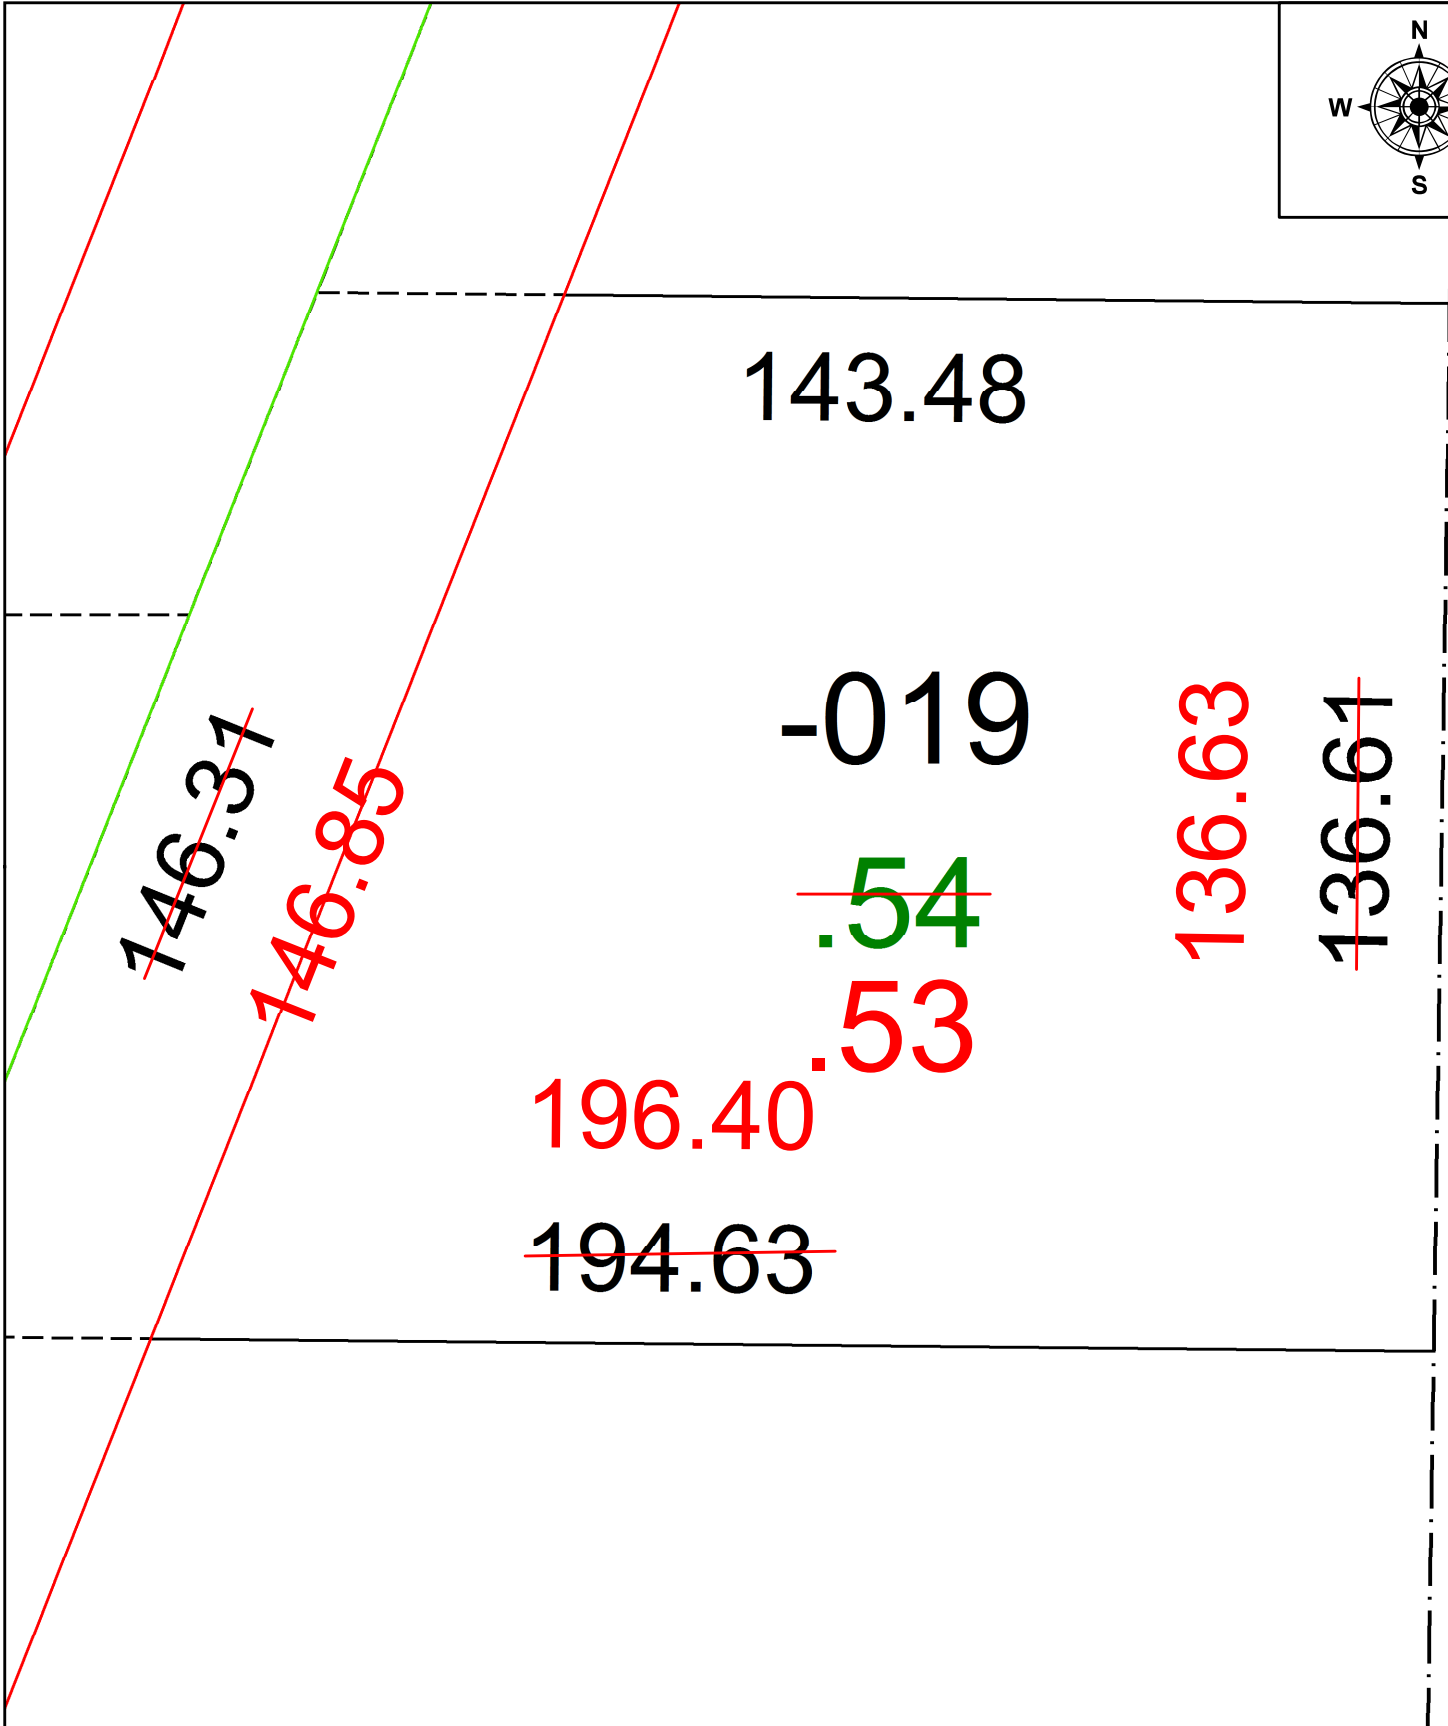

**SPLITS/DEEDS PROCESSED**  
 LORAIN COUNTY TAX MAP DEPARTMENT  
 226 MIDDLE AVE. ELYRIA, OH

SURVEYED BY: THOMAS A. SIMON

CLOSURE: 1: 98141

MAP PAGE(S): 05-00-055

APPROVED BY: AC DATE: 7/6/2021

SCALE: 1" = 25 PRIOR INSTRUMENT: 2019-0741172