


PARENT PARCEL: 16-00-025-103-001 & 16-00-025-101-004

CHILD PARCEL: 16-00-025-103-006, -007, & 16-00-025-101-023 ACREAGE CORRECTION PER SURVEYOR THOMAS SIMON

22-04604

STARTING POINT: NORTHWESTERLY CORNER OF S/L 17 IN KINGSLEY ACRES SUBDIVISION

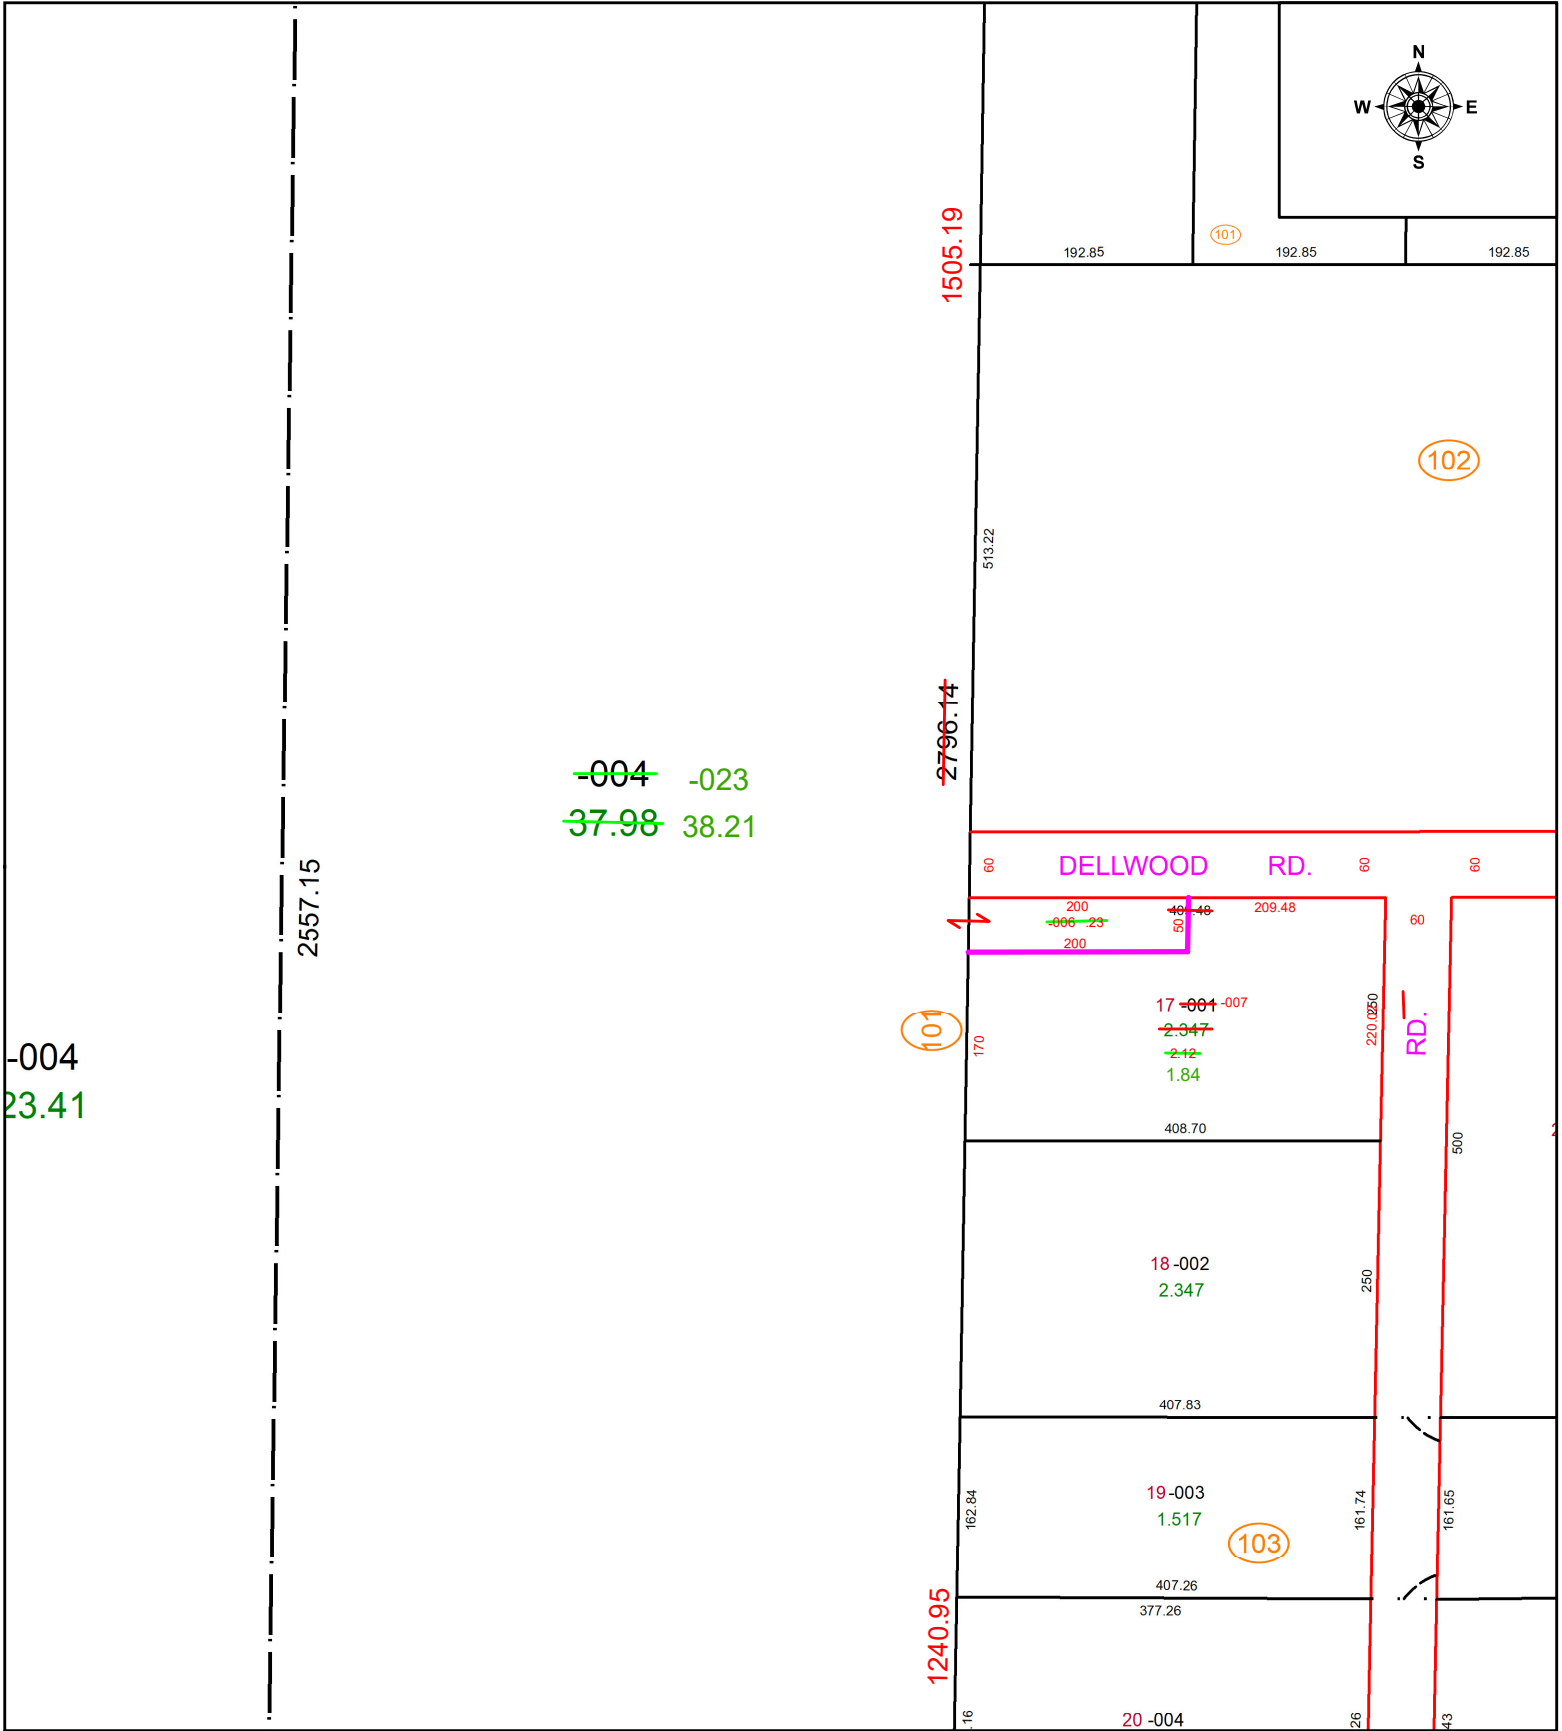

-004
23.41

~~-004~~ -023
~~37.98~~ 38.21

1505.19

2796.14

1240.95

192.85

192.85

192.85

513.22

60

DELLWOOD RD.

60

60

200
~~200~~ 23
200

40 48
50 48
209.48

17 -001 -007

~~2.347~~
~~2.12~~
1.84

408.70

18 -002

2.347

407.83

19 -003

1.517

407.26

377.26

20 -004

SURVEY # 50768


SURVEYED BY: THOMAS SIMON

CLOSURE: 1: INF

MAP PAGE(S): 16-00-025

APPROVED BY: WRZ DATE: 12/29/2022

SCALE: 1" = 175 PRIOR INSTRUMENT: #2001-0734069

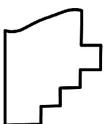

SPLITS/DEEDS PROCESSED
LORAIN COUNTY TAX MAP DEPARTMENT
226 MIDDLE AVE. ELYRIA, OH