
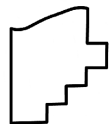


PARENT PARCEL: 04-00-018-130-022
 CHILD PARCEL: XX-XX-XXX-XXX-XXX
 STARTING POINT: XXXXXXXXX

21-04606-A

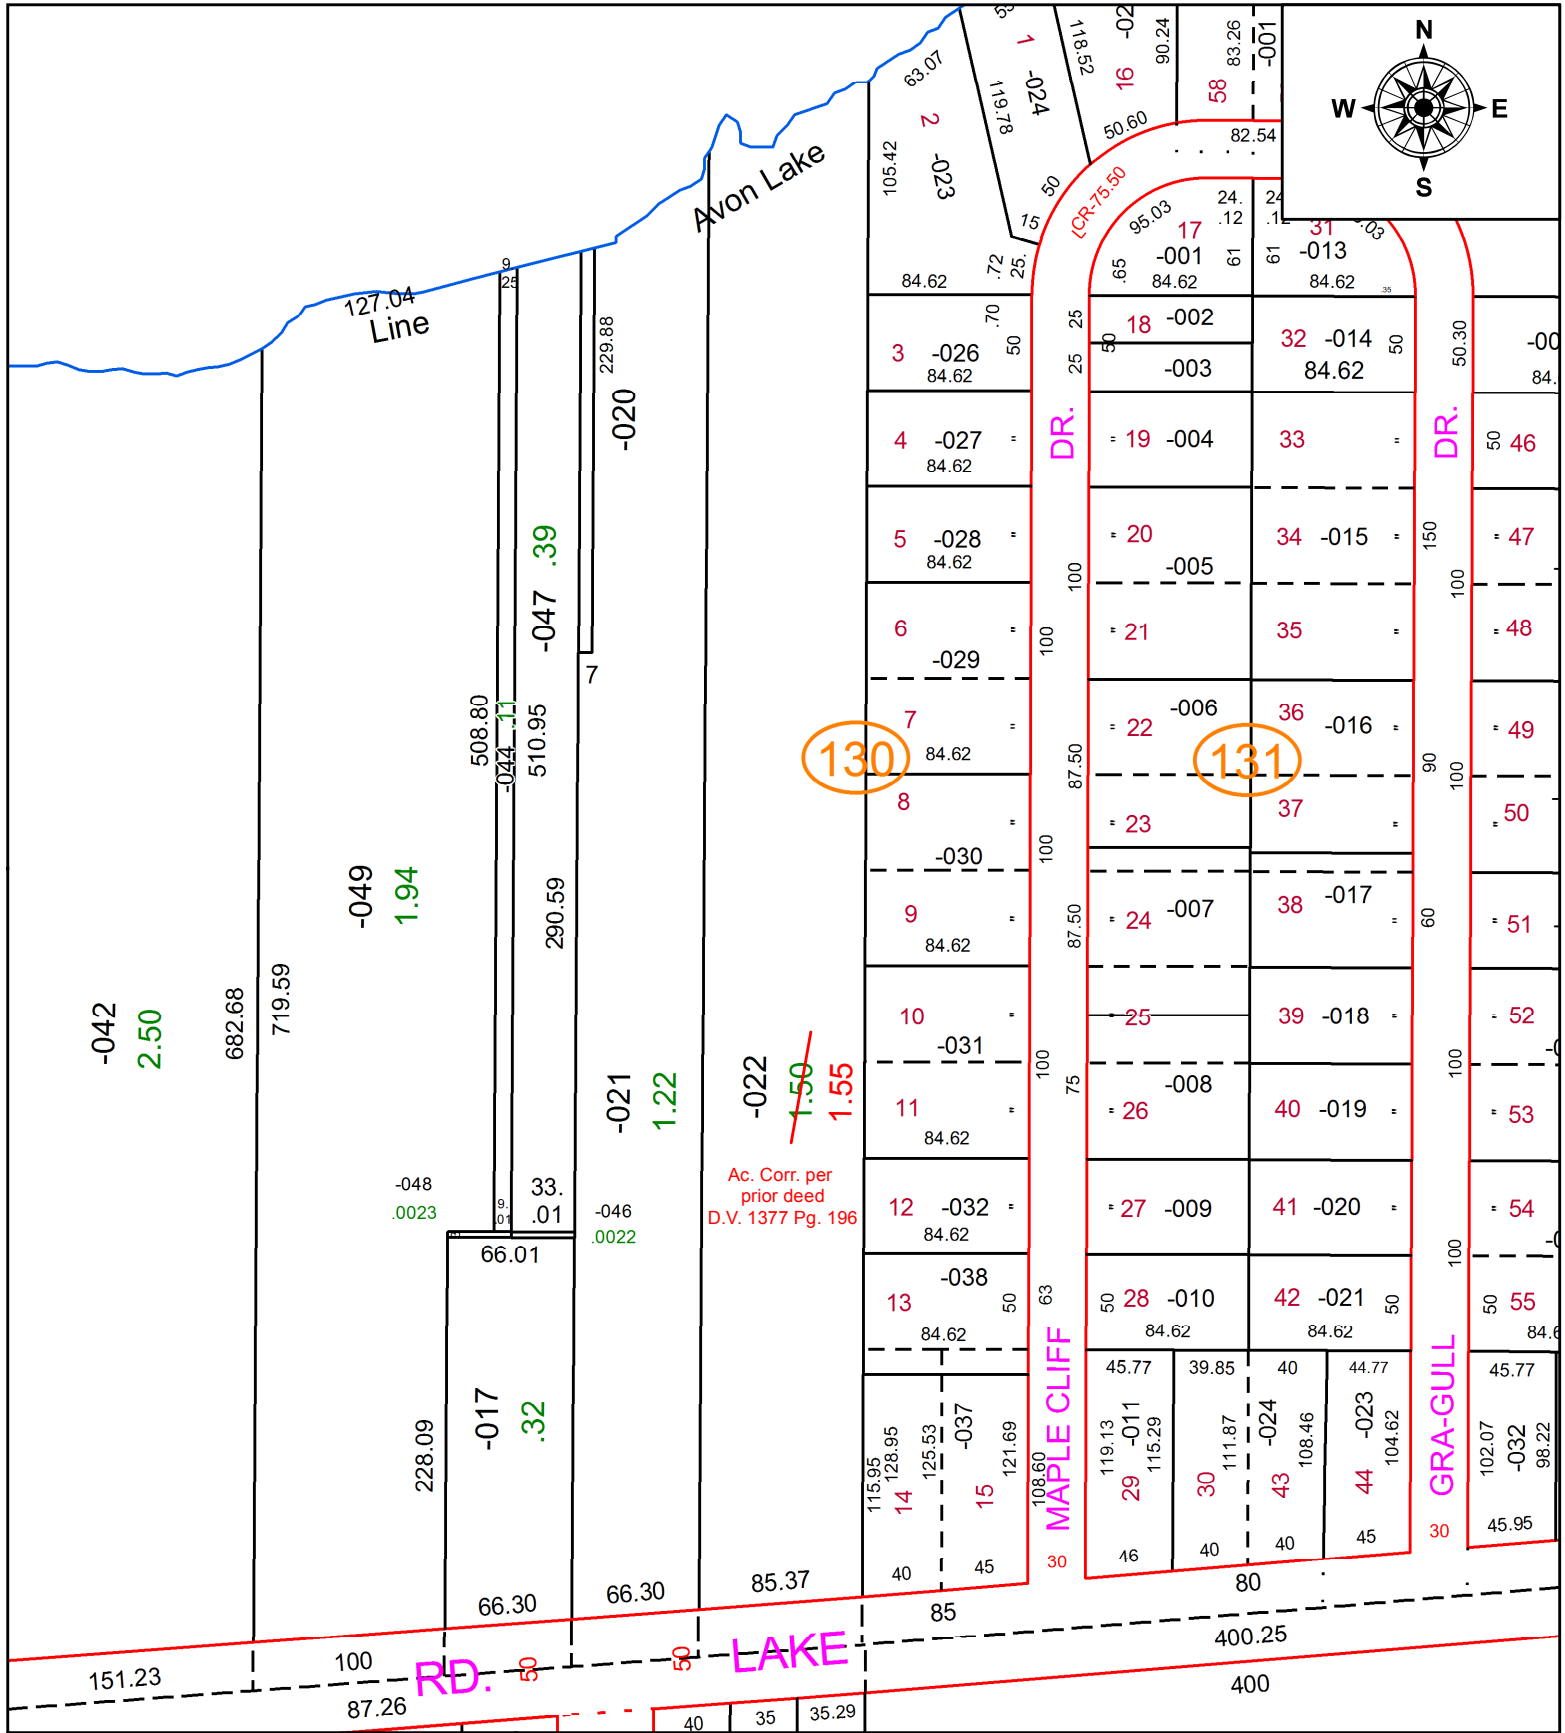

SPLITS/DEEDS PROCESSED
 LORAIN COUNTY TAX MAP DEPARTMENT
 226 MIDDLE AVE. ELYRIA, OH

SURVEYED BY: XXXXXX
 CLOSURE: XXXX
 MAP PAGE(S): 04-00-018
 APPROVED BY: DMA DATE: 7/14/2021
 SCALE: 1" = 100 Ft. PRIOR INSTRUMENT: D.V 1377 PG. 196