


PARENT PARCEL: 01-00-002-122-016 & -017


CHILD PARCEL: 01-00-002-122-037 COMBINATION

STARTING POINT: N/A

23-04610

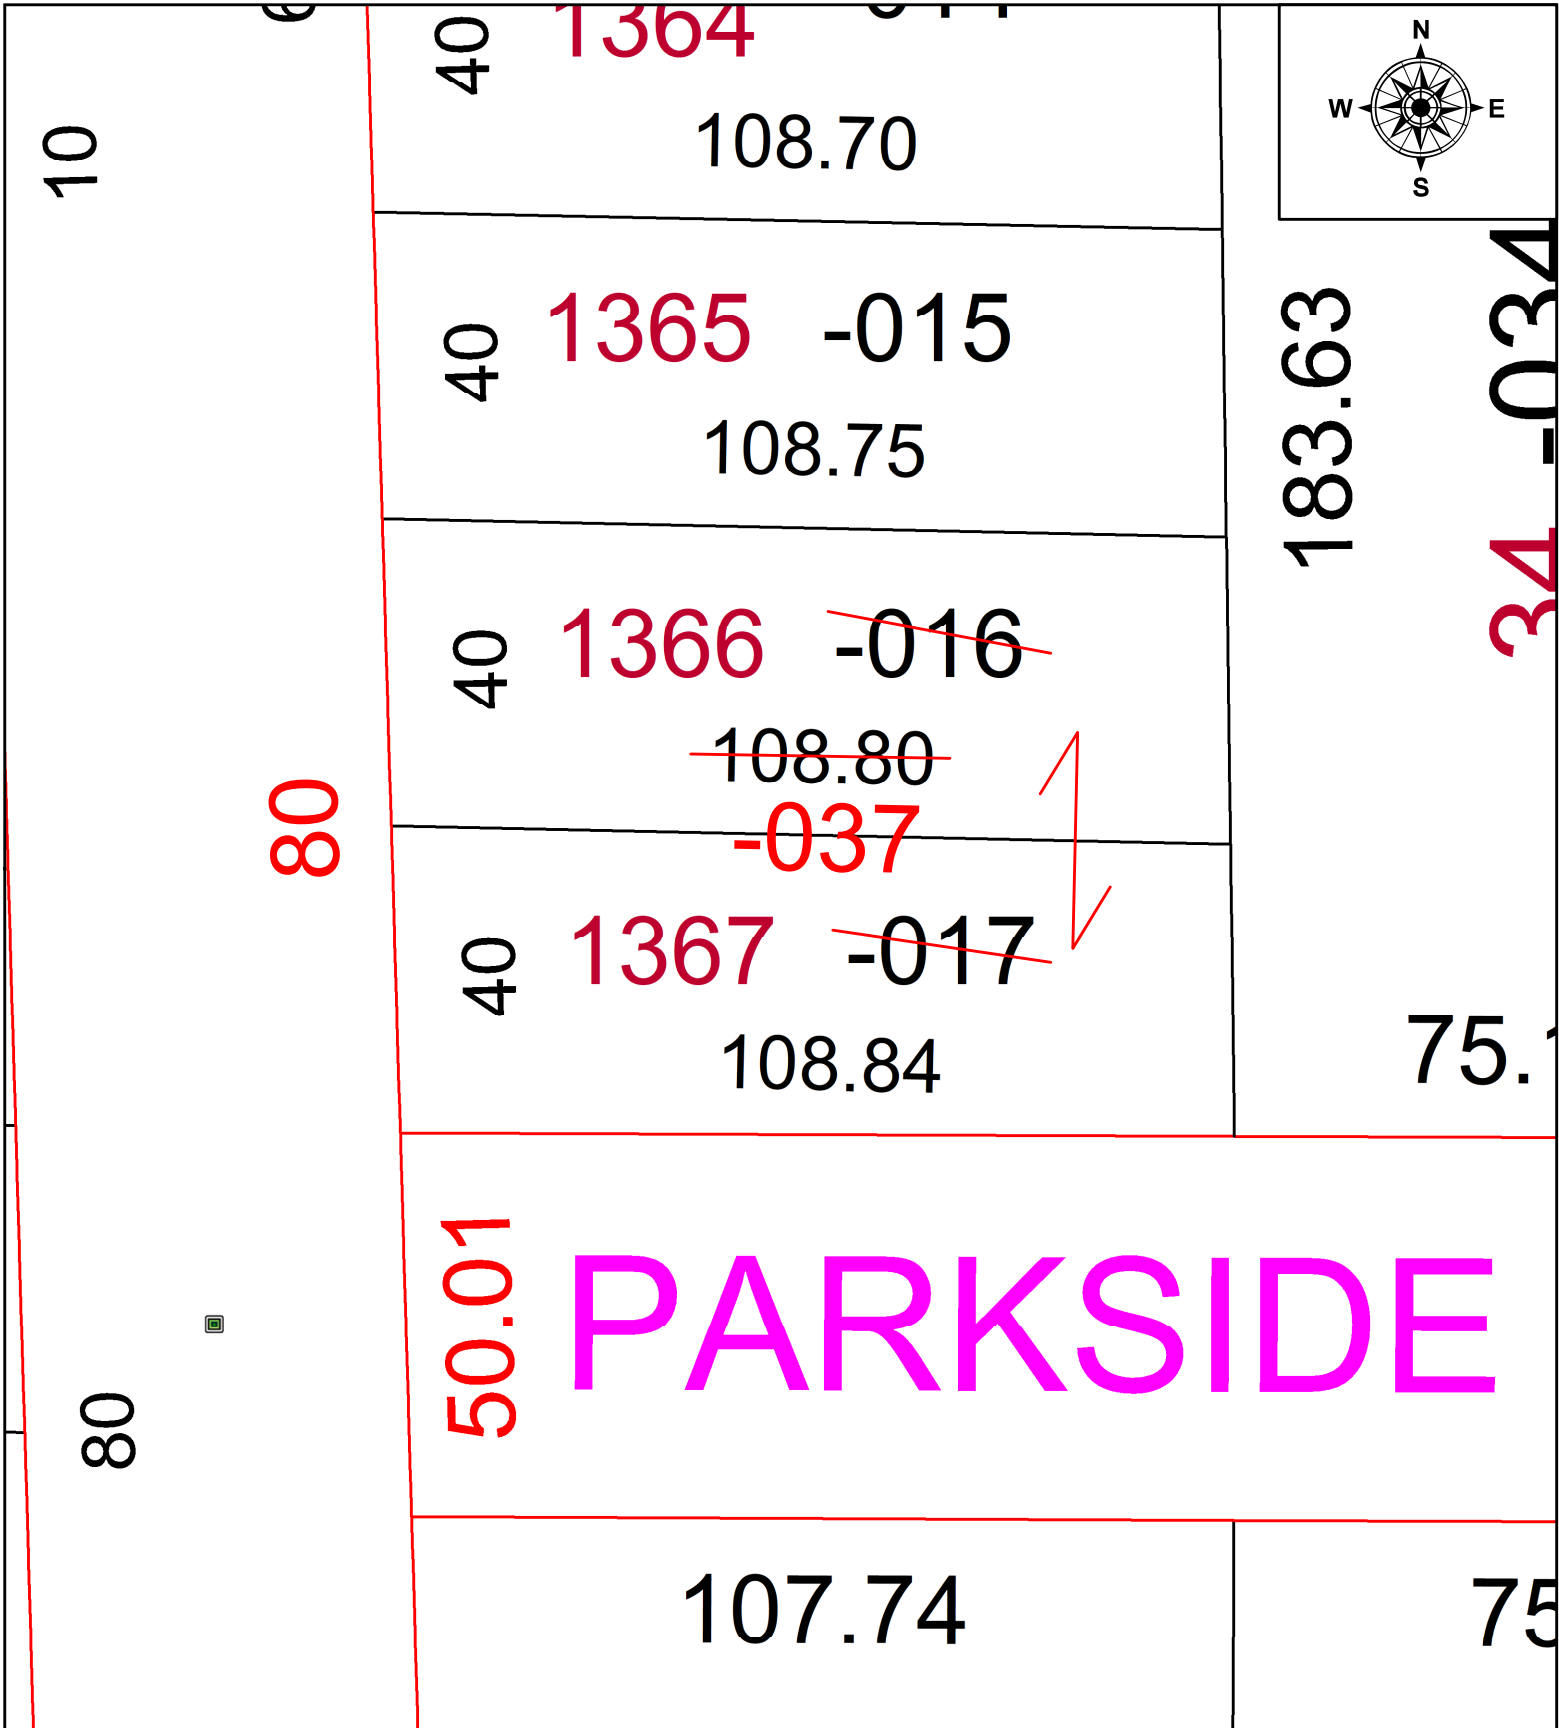

PARKSIDE

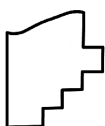

SPLITS/DEEDS PROCESSED
LORAIN COUNTY TAX MAP DEPARTMENT
226 MIDDLE AVE. ELYRIA, OH

SURVEYED BY: N/A	SURVEY #: N/A
CLOSURE: N/A	
MAP PAGE(S): 01-00-002	
APPROVED BY: DMA	DATE: 1/11/2023
SCALE: 1" = 25'	PRIOR INSTRUMENT: 2021-0847908