
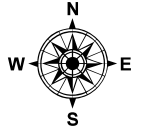


PARENT PARCEL: 15-00-036-000-024

CHILD PARCEL: 15-00-036-000-135 & -136 ACREAGE CORRECTION PER SURVEYOR DALE HAYWOOD

23-04612

STARTING POINT: BRASS DISK MONUMENT @ C/L OF BIGGS RD & NORTHWEST CORNER OF O.L. 36

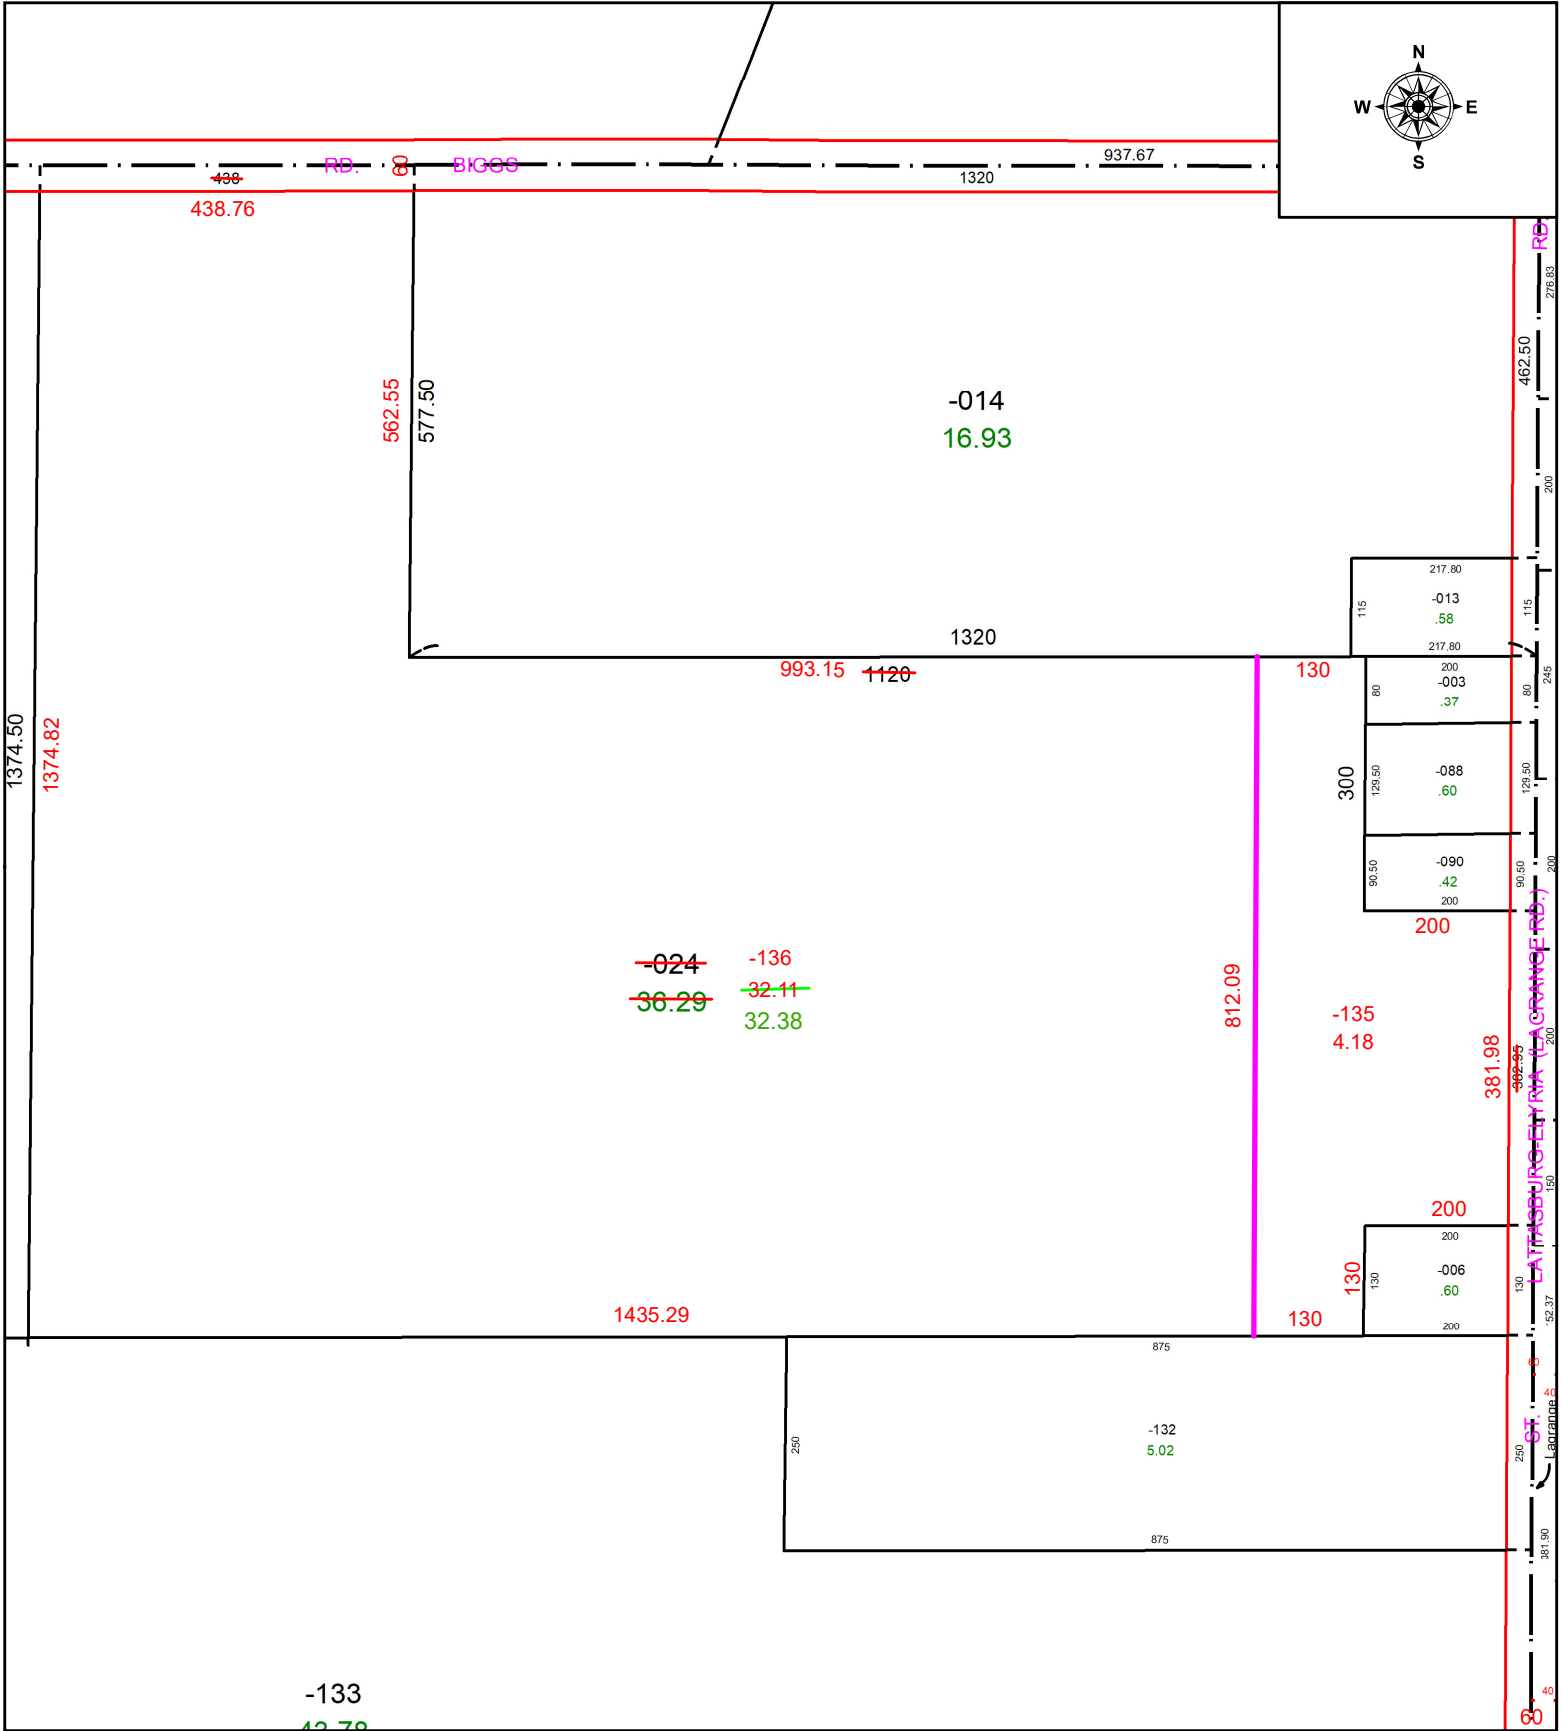

SPLITS/DEEDS PROCESSED
 LORAIN COUNTY TAX MAP DEPARTMENT
 226 MIDDLE AVE. ELYRIA, OH

SURVEYED BY: DALE HAYWOOD SURVEY # 50785
 CLOSURE: 1: 2095072
 MAP PAGE(S): 15-00-036
 APPROVED BY: WRZ DATE: 1/19/2023
 SCALE: 1" = 225 PRIOR INSTRUMENT: #2021-0853257