
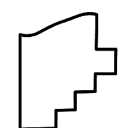


PARENT PARCEL: 07-00-016-101-047

CHILD PARCEL: 07-00-016-101-055 & -056

STARTING POINT: CL OF CENTER RIDGE RD. & JAYCOX RD.

23-04614

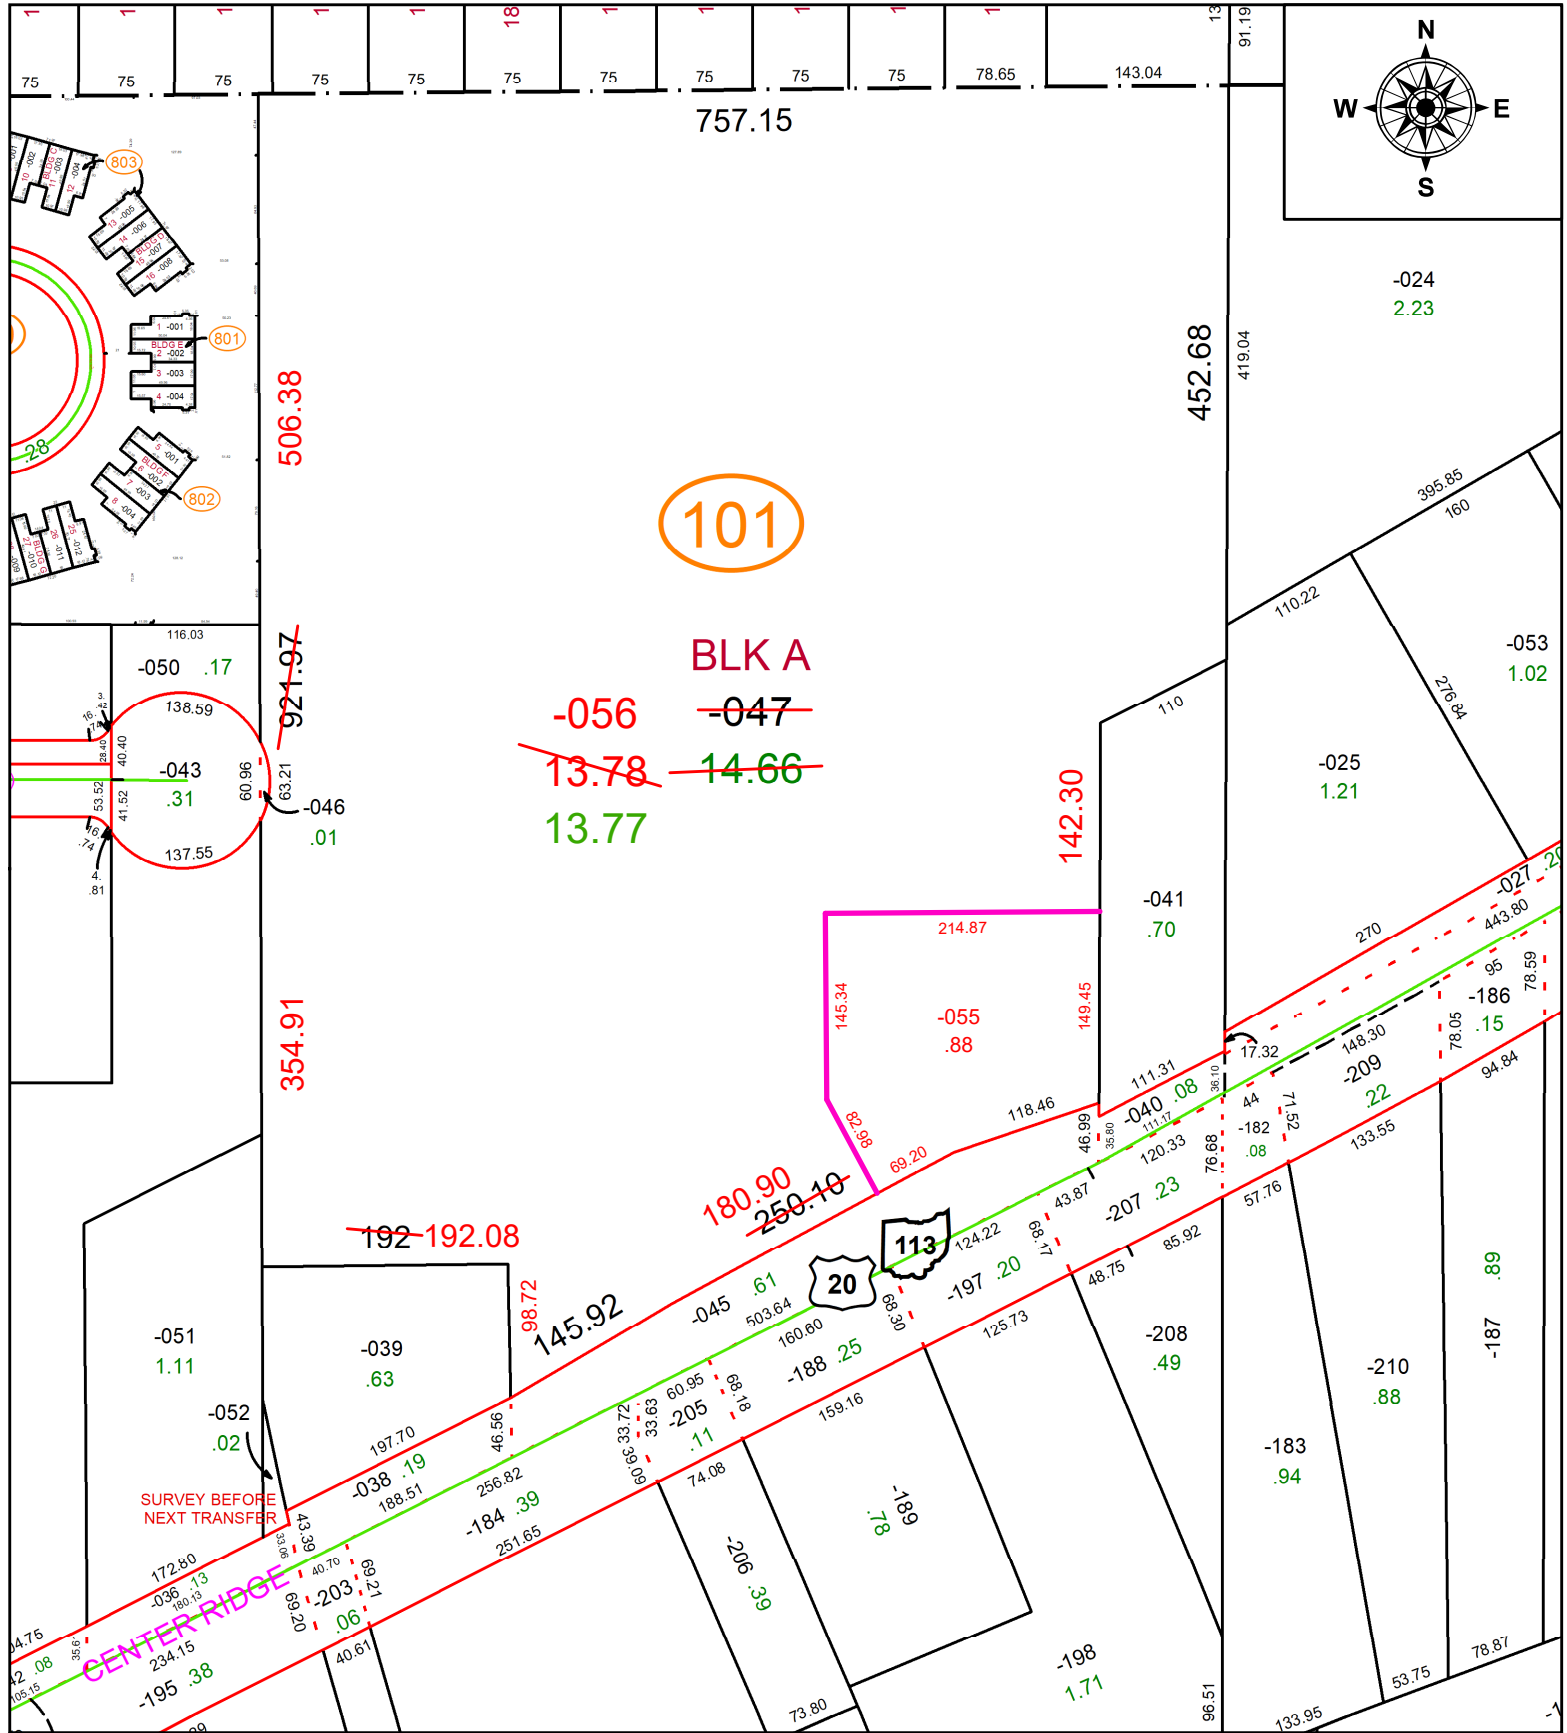

SPLITS/DEEDS PROCESSED
 LORAIN COUNTY TAX MAP DEPARTMENT
 226 MIDDLE AVE. ELYRIA, OH

SURVEYED BY: DANIEL CLIPSE
CLOSURE: 1:242097
MAP PAGE(S): 07-00-016
APPROVED BY: DMA **DATE:** 1/19/2023
SCALE: 1" = 150' **PRIOR INSTRUMENT:** D.V. 1165 PG. 577

SURVEY #: 50787