
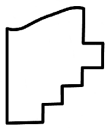
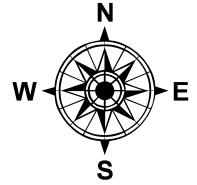


PARENT PARCEL: 01-00-007-103-009 & 01-00-008-000-014

CHILD PARCEL: 01-00-007-103-010 thru -012, 01-00-008-000-014 ST. TRN. 01-00-010-000-027 ST. TRN.

STARTING POINT: CL OF BAUMART RD. & WEST ERIE AVE.

23-04615

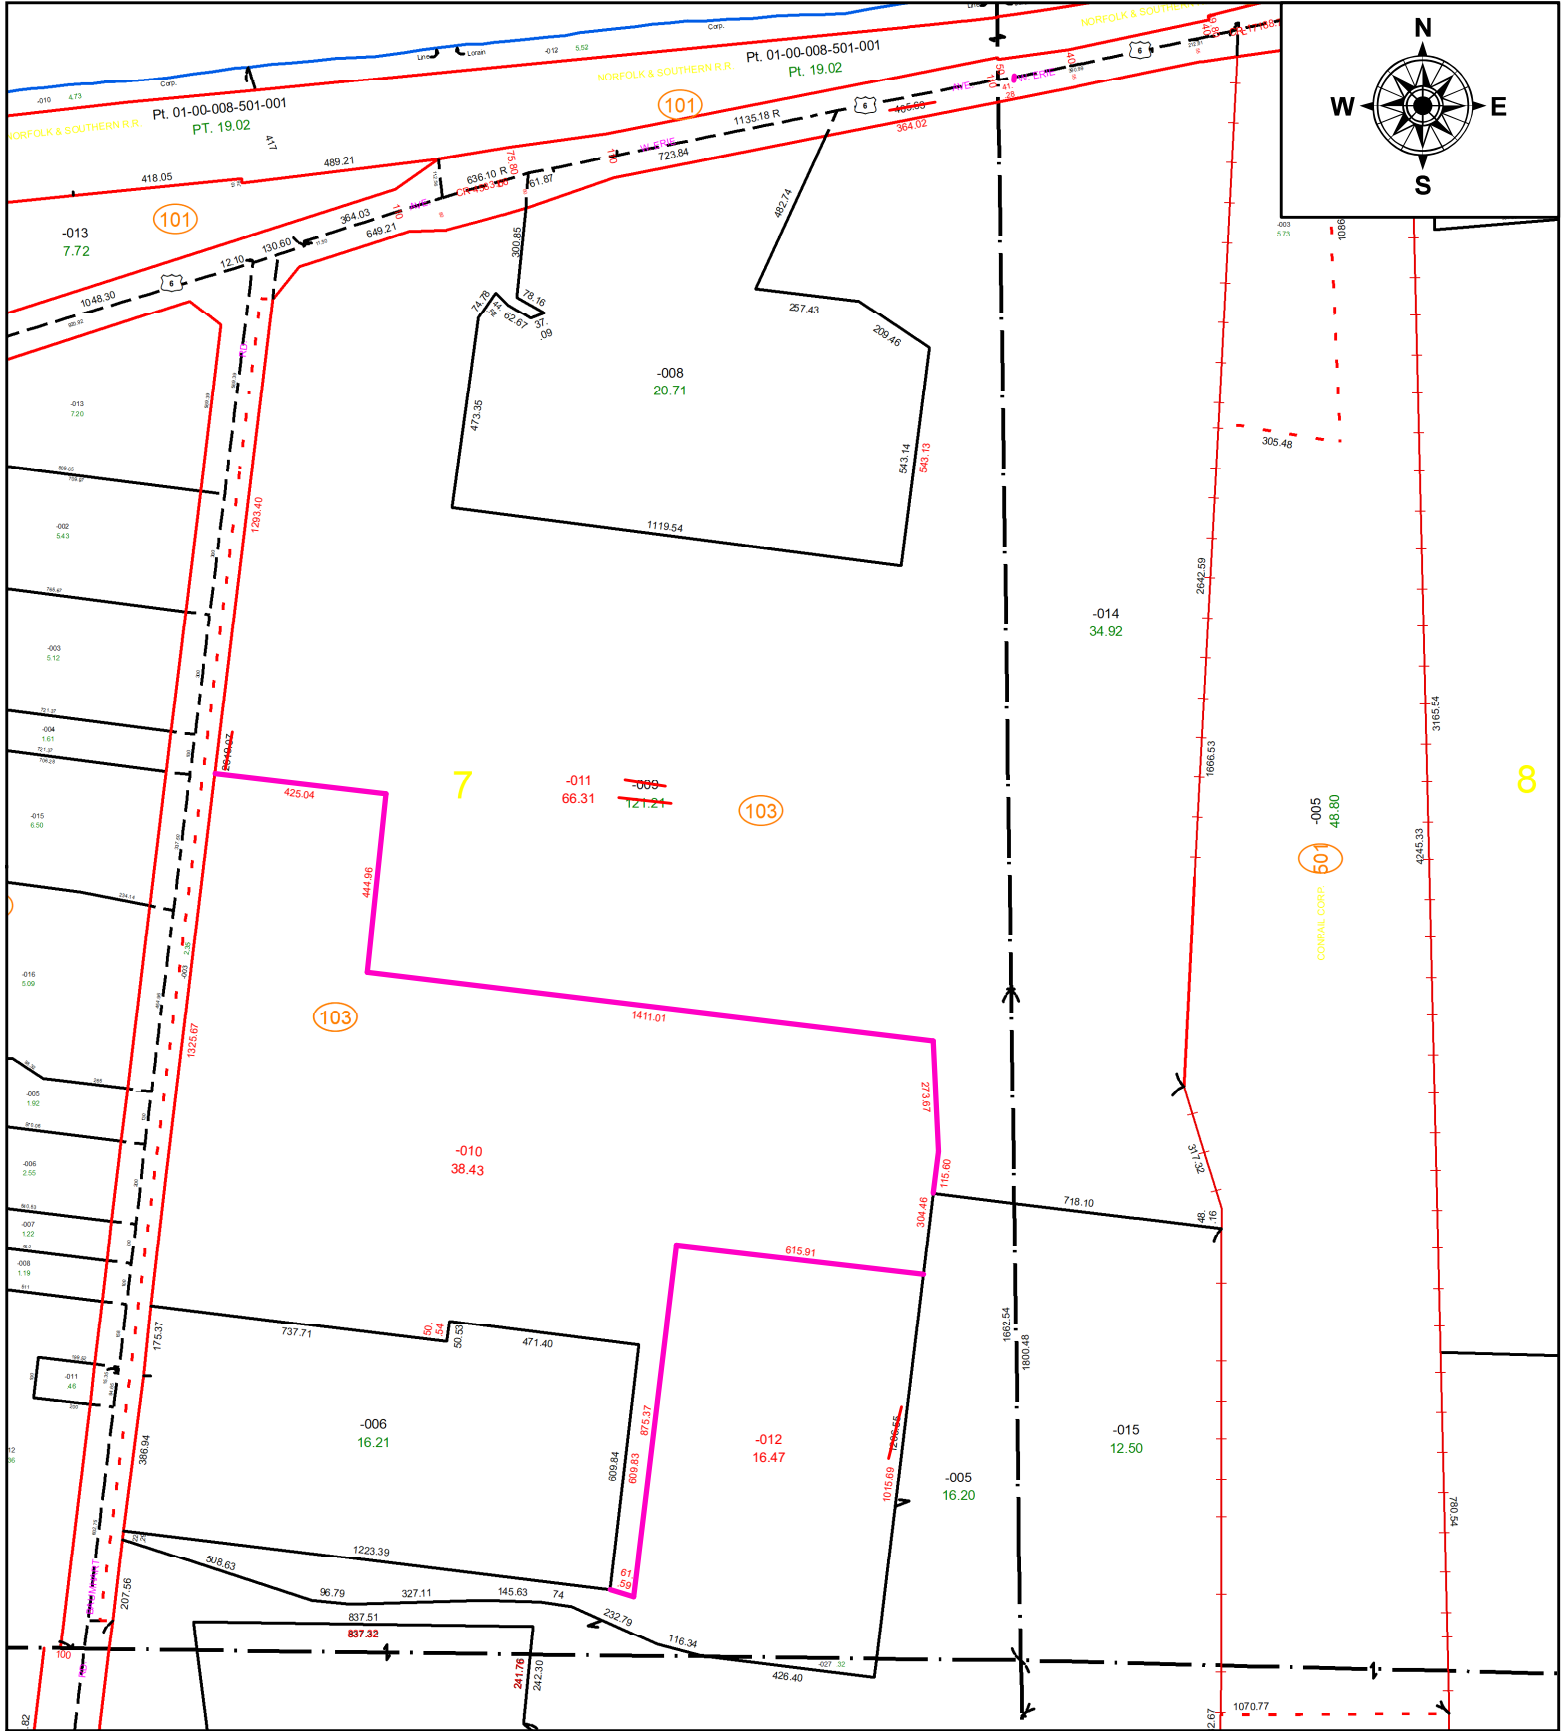

**SPLITS/DEEDS PROCESSED**  
 LORAIN COUNTY TAX MAP DEPARTMENT  
 226 MIDDLE AVE. ELYRIA, OH

**SURVEYED BY:** JOHN ALBAN **SURVEY #:** 50789  
**CLOSURE:** 1:2117652  
**MAP PAGE(S):** 01-00-007 & -008  
**APPROVED BY:** DMA **DATE:** 1/20/2023  
**SCALE:** 1" = 475' **PRIOR INSTRUMENT:** 2016-0593812