


PARENT PARCEL: 09-00-052-000-017

CHILD PARCEL: 09-00-052-000-019 thru -021

STARTING POINT: CL OF GARFIELD RD. & QUARRY RD.

23-04617

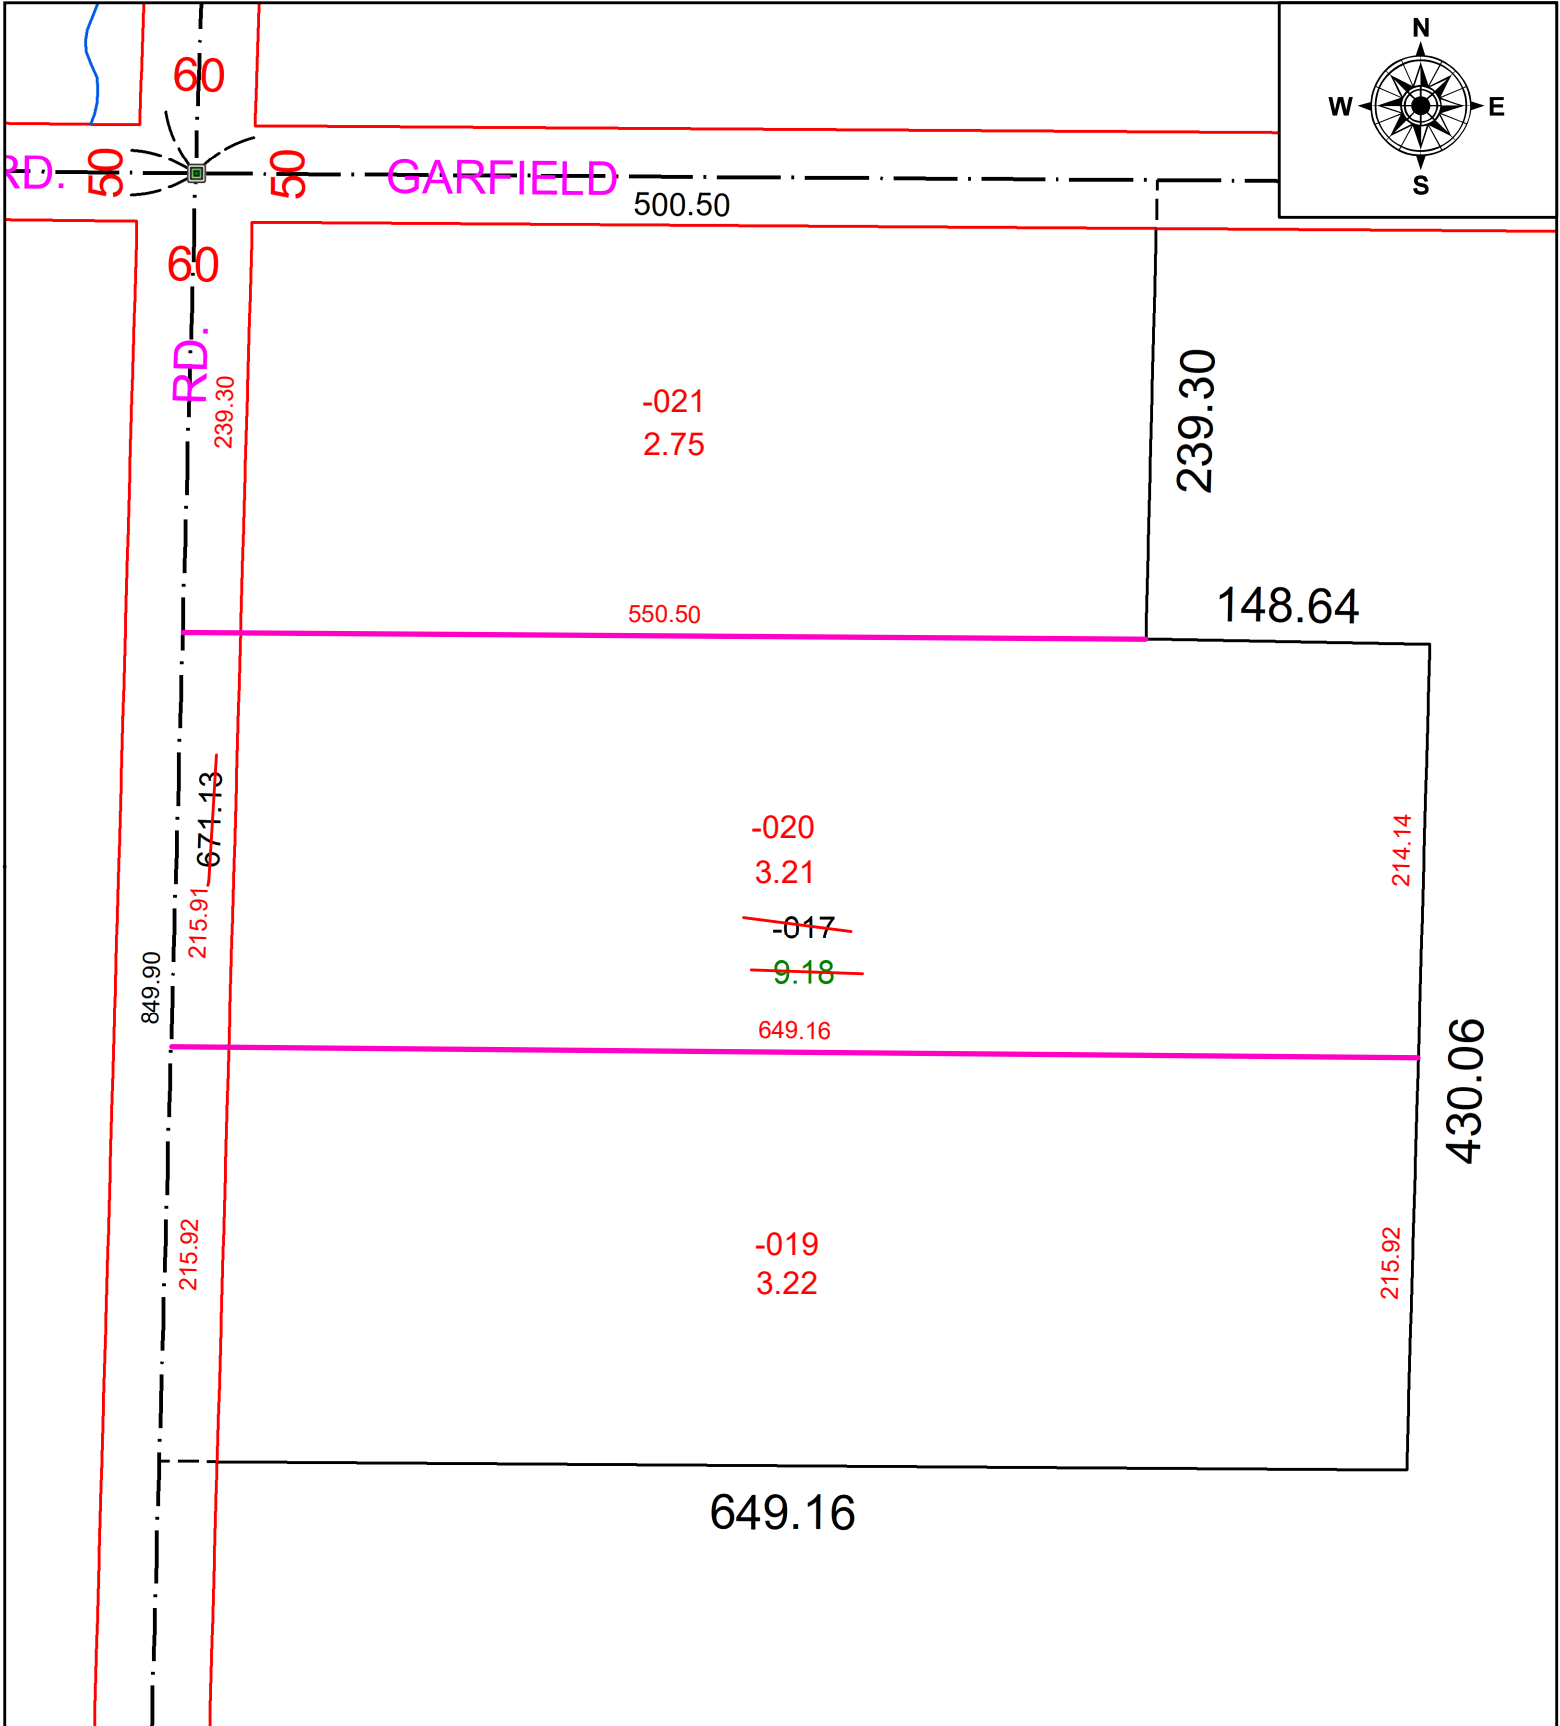

SPLITS/DEEDS PROCESSED
 LORAIN COUNTY TAX MAP DEPARTMENT
 226 MIDDLE AVE. ELYRIA, OH

SURVEYED BY: PATRICK MCGANNON **SURVEY #:** 50791
CLOSURE: 1:1652793
MAP PAGE(S): 09-00-052
APPROVED BY: DMA **DATE:** 1/24/2023
SCALE: 1" = 100' **PRIOR INSTRUMENT:** 2022-0899716