


PARENT PARCEL: 10-00-008-111-007

CHILD PARCEL: AC. CORR. PER SURVEY J.W. WARDEN

STARTING POINT: XXXXXXXXXXXX

21-04618-A

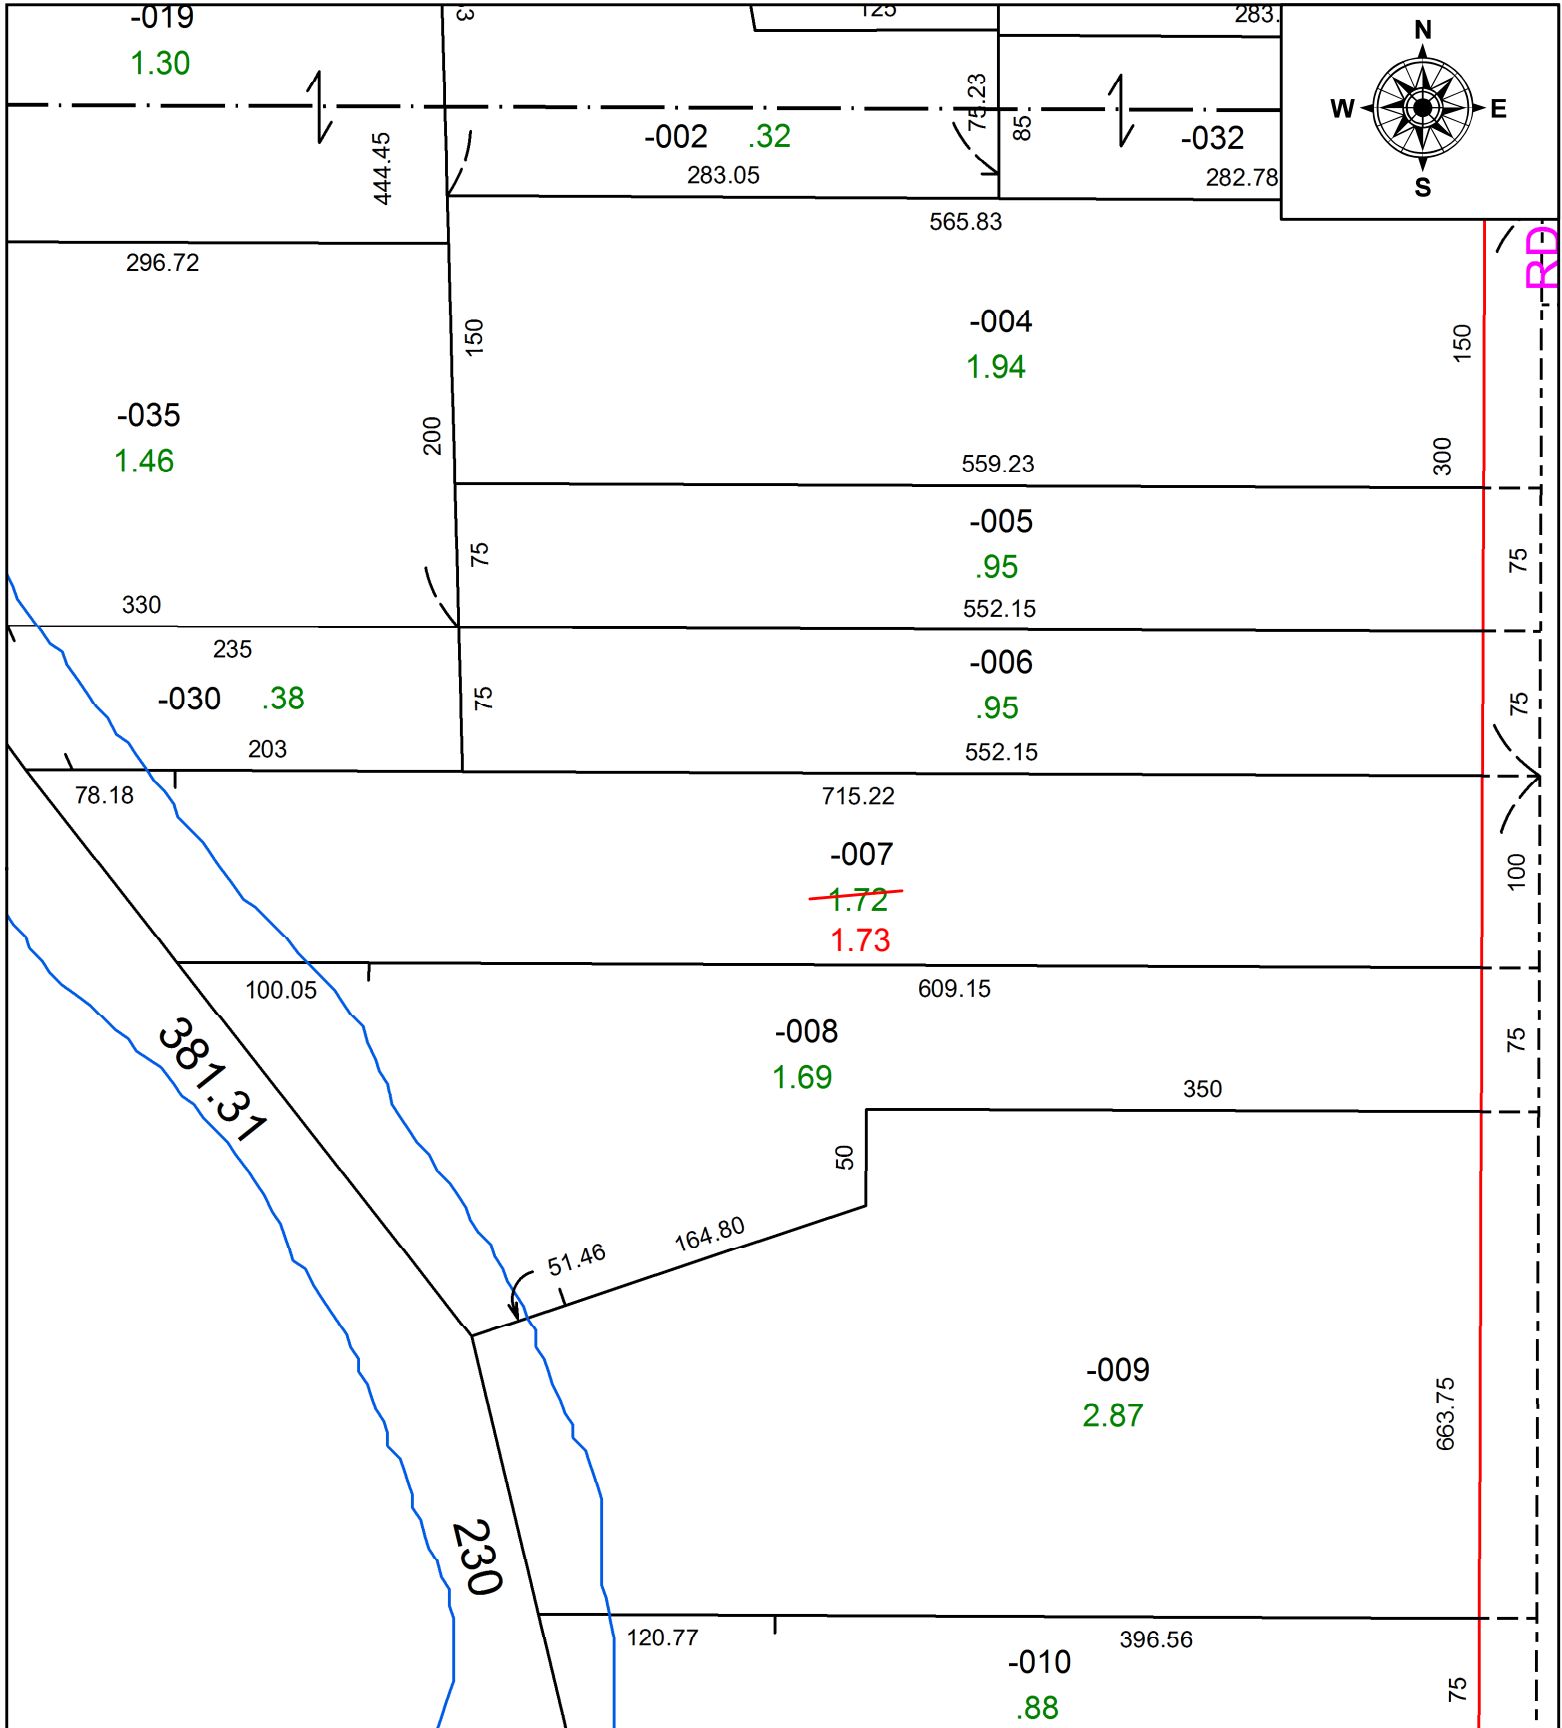

SPLITS/DEEDS PROCESSED
 LORAIN COUNTY TAX MAP DEPARTMENT
 226 MIDDLE AVE. ELYRIA, OH

SURVEYED BY: J.W. WARDEN

CLOSURE: XXXXXXXXXXXX

MAP PAGE(S): 10-00-008

APPROVED BY: DMA DATE: 8/5/2021

SCALE: 1" = 100' PRIOR INSTRUMENT: 20090283114