


PARENT PARCEL: 06-24-025-102-017

CHILD PARCEL: **MAP CORRECTION ONLY**

STARTING POINT: C/L OF PENFIELD AND BELL AVE

21-04619-C

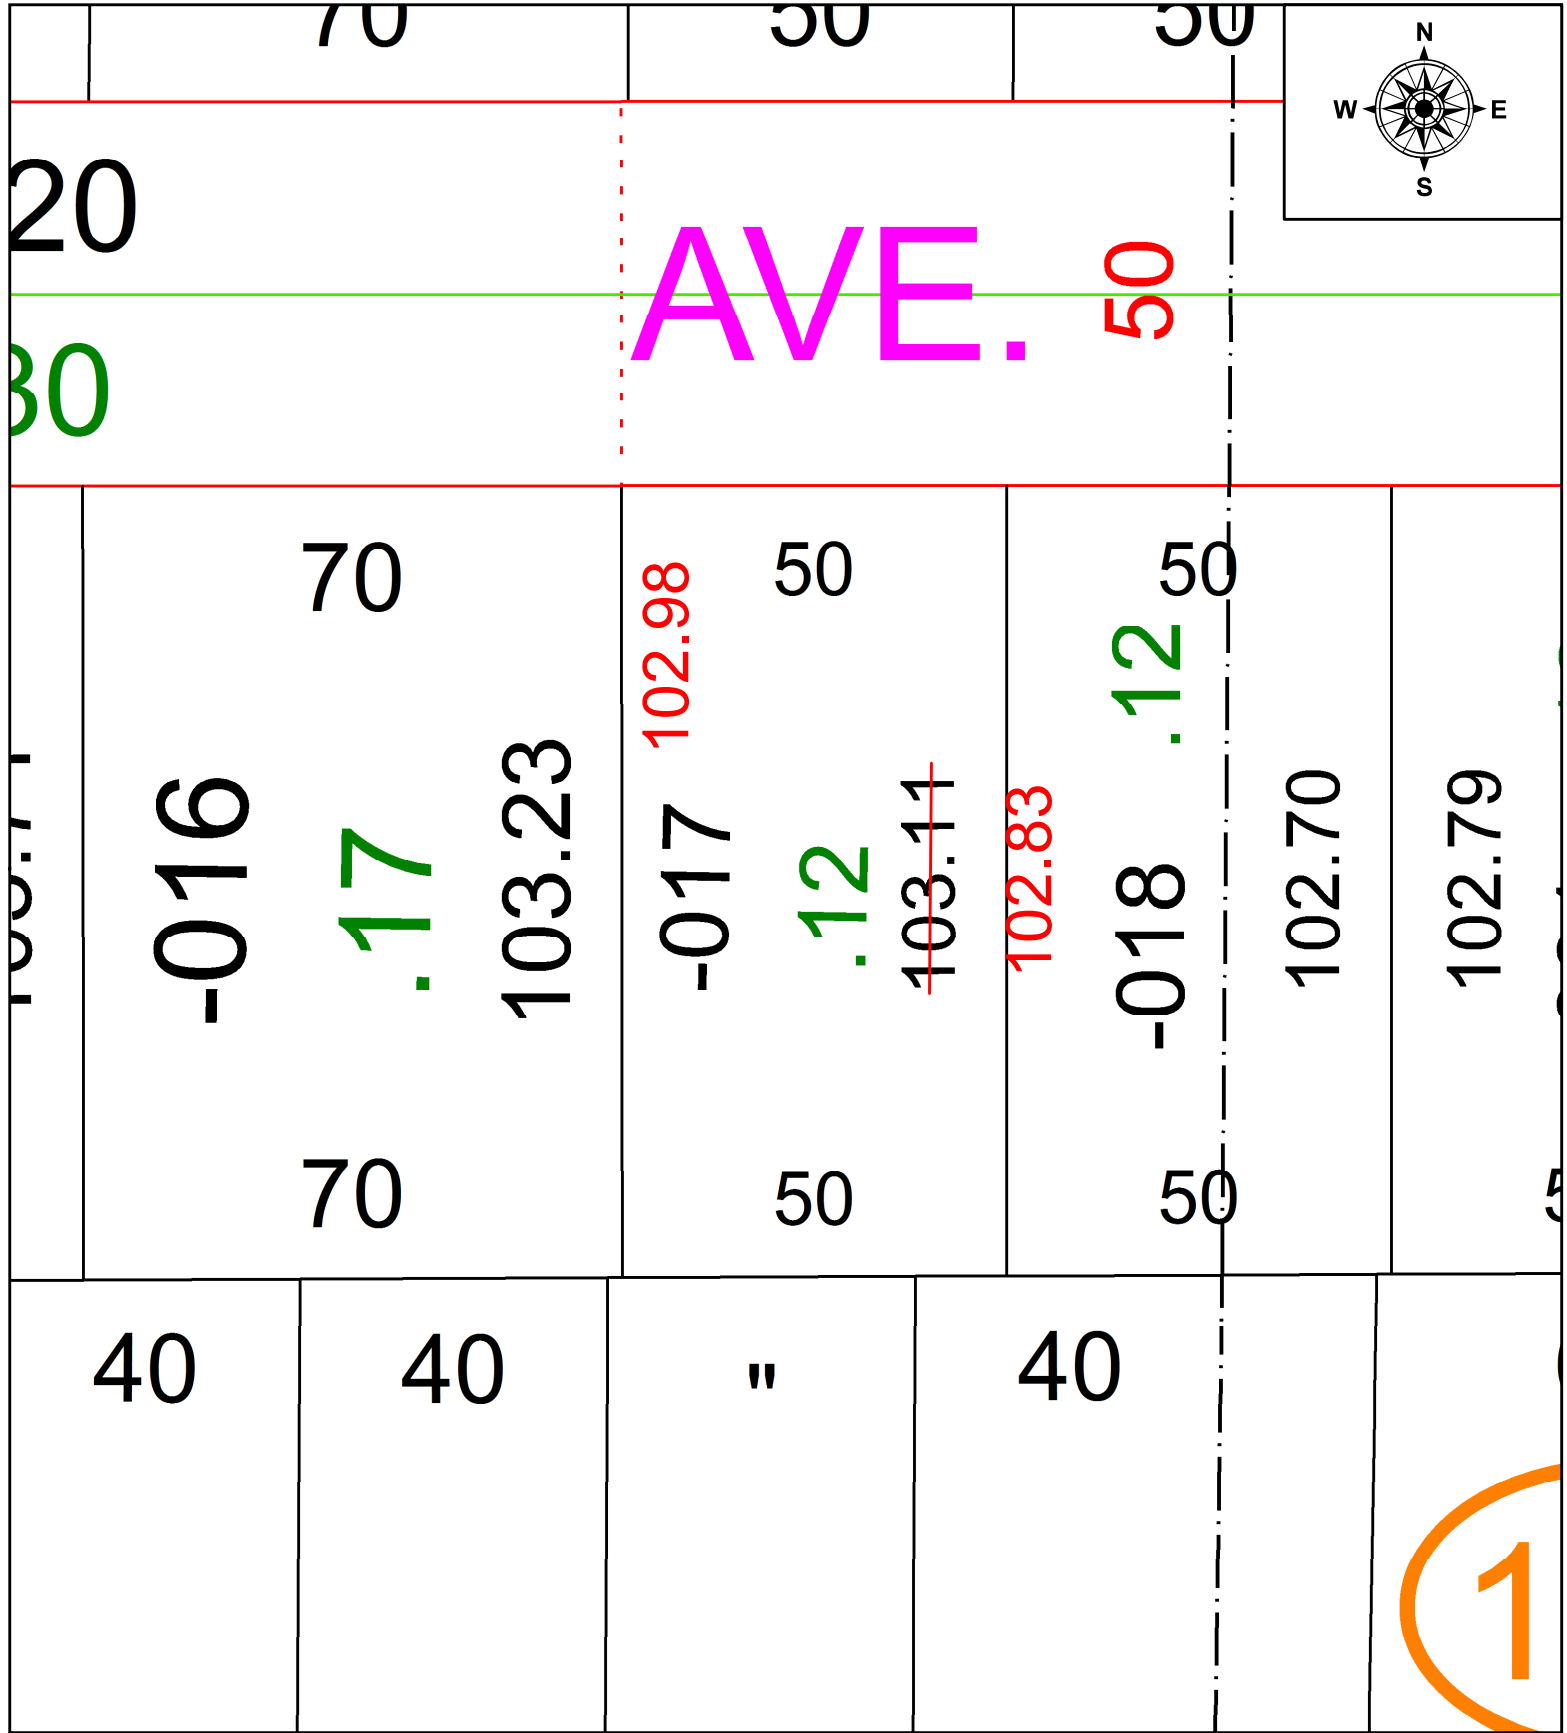

**SPLITS/DEEDS PROCESSED**  
 LORAIN COUNTY TAX MAP DEPARTMENT  
 226 MIDDLE AVE. ELYRIA, OH

SURVEYED BY: THOMAS A. SIMON  
 CLOSURE: 1: 200998  
 MAP PAGE(S): 06-78  
 APPROVED BY: AC DATE: 8/6/2021  
 SCALE: 1" = 25' PRIOR INSTRUMENT: 2020- 0759950