
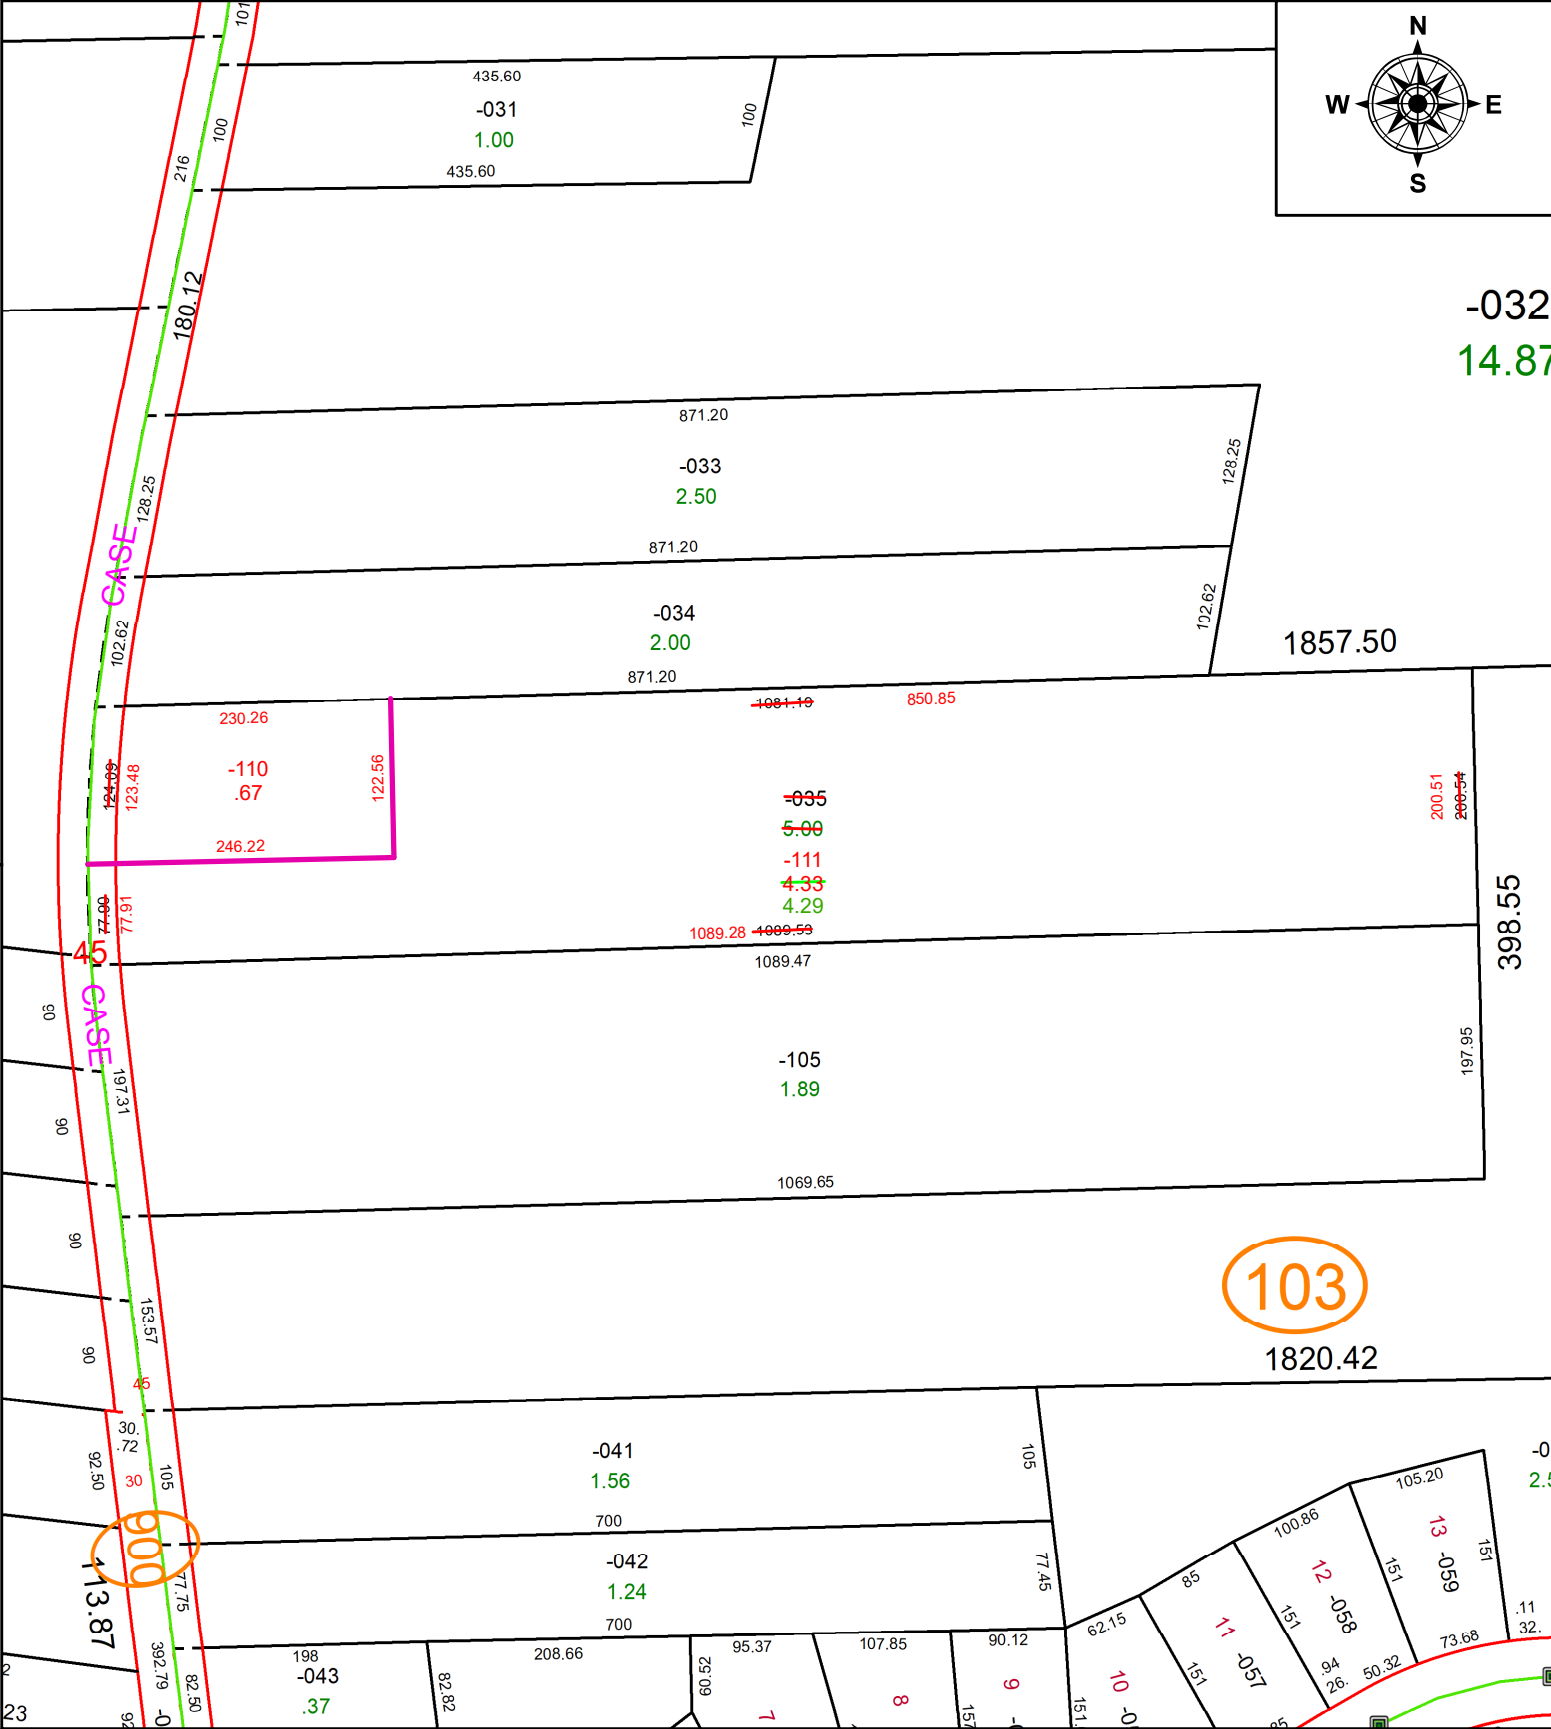


PARENT PARCEL: 07-00-043-103-035

CHILD PARCEL: 07-00-043-103-110 & -111

STARTING POINT: **AC CORR PER SURV BY RICHARD A. THOMPSON JR.**

23-04621

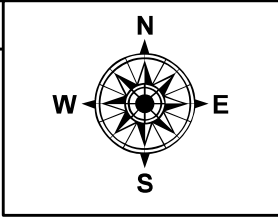

SPLITS/DEEDS PROCESSED
LORAIN COUNTY TAX MAP DEPARTMENT
226 MIDDLE AVE. ELYRIA, OH

SURVEYED BY: RICHARD A. THOMPSON JR. **SURV # 50801**
CLOSURE: 1: 100789
MAP PAGE(S): 07-00-043-A
APPROVED BY: AC **DATE:** February 03, 2023
SCALE: 1 in = 150 ft **PRIOR INSTRUMENT:** 2019- 0721912