


PARENT PARCEL: 01-00-063-000-058, -057 & -004

CHILD PARCEL: 01-00-063-000-066 THRU -073 & 01-00-064-000-080 THRU -085 N/A

23-04622

STARTING POINT: INTERSECTION OF C/L'S OF GORE ORPHANAGE RD & NORTH RIDGE RD

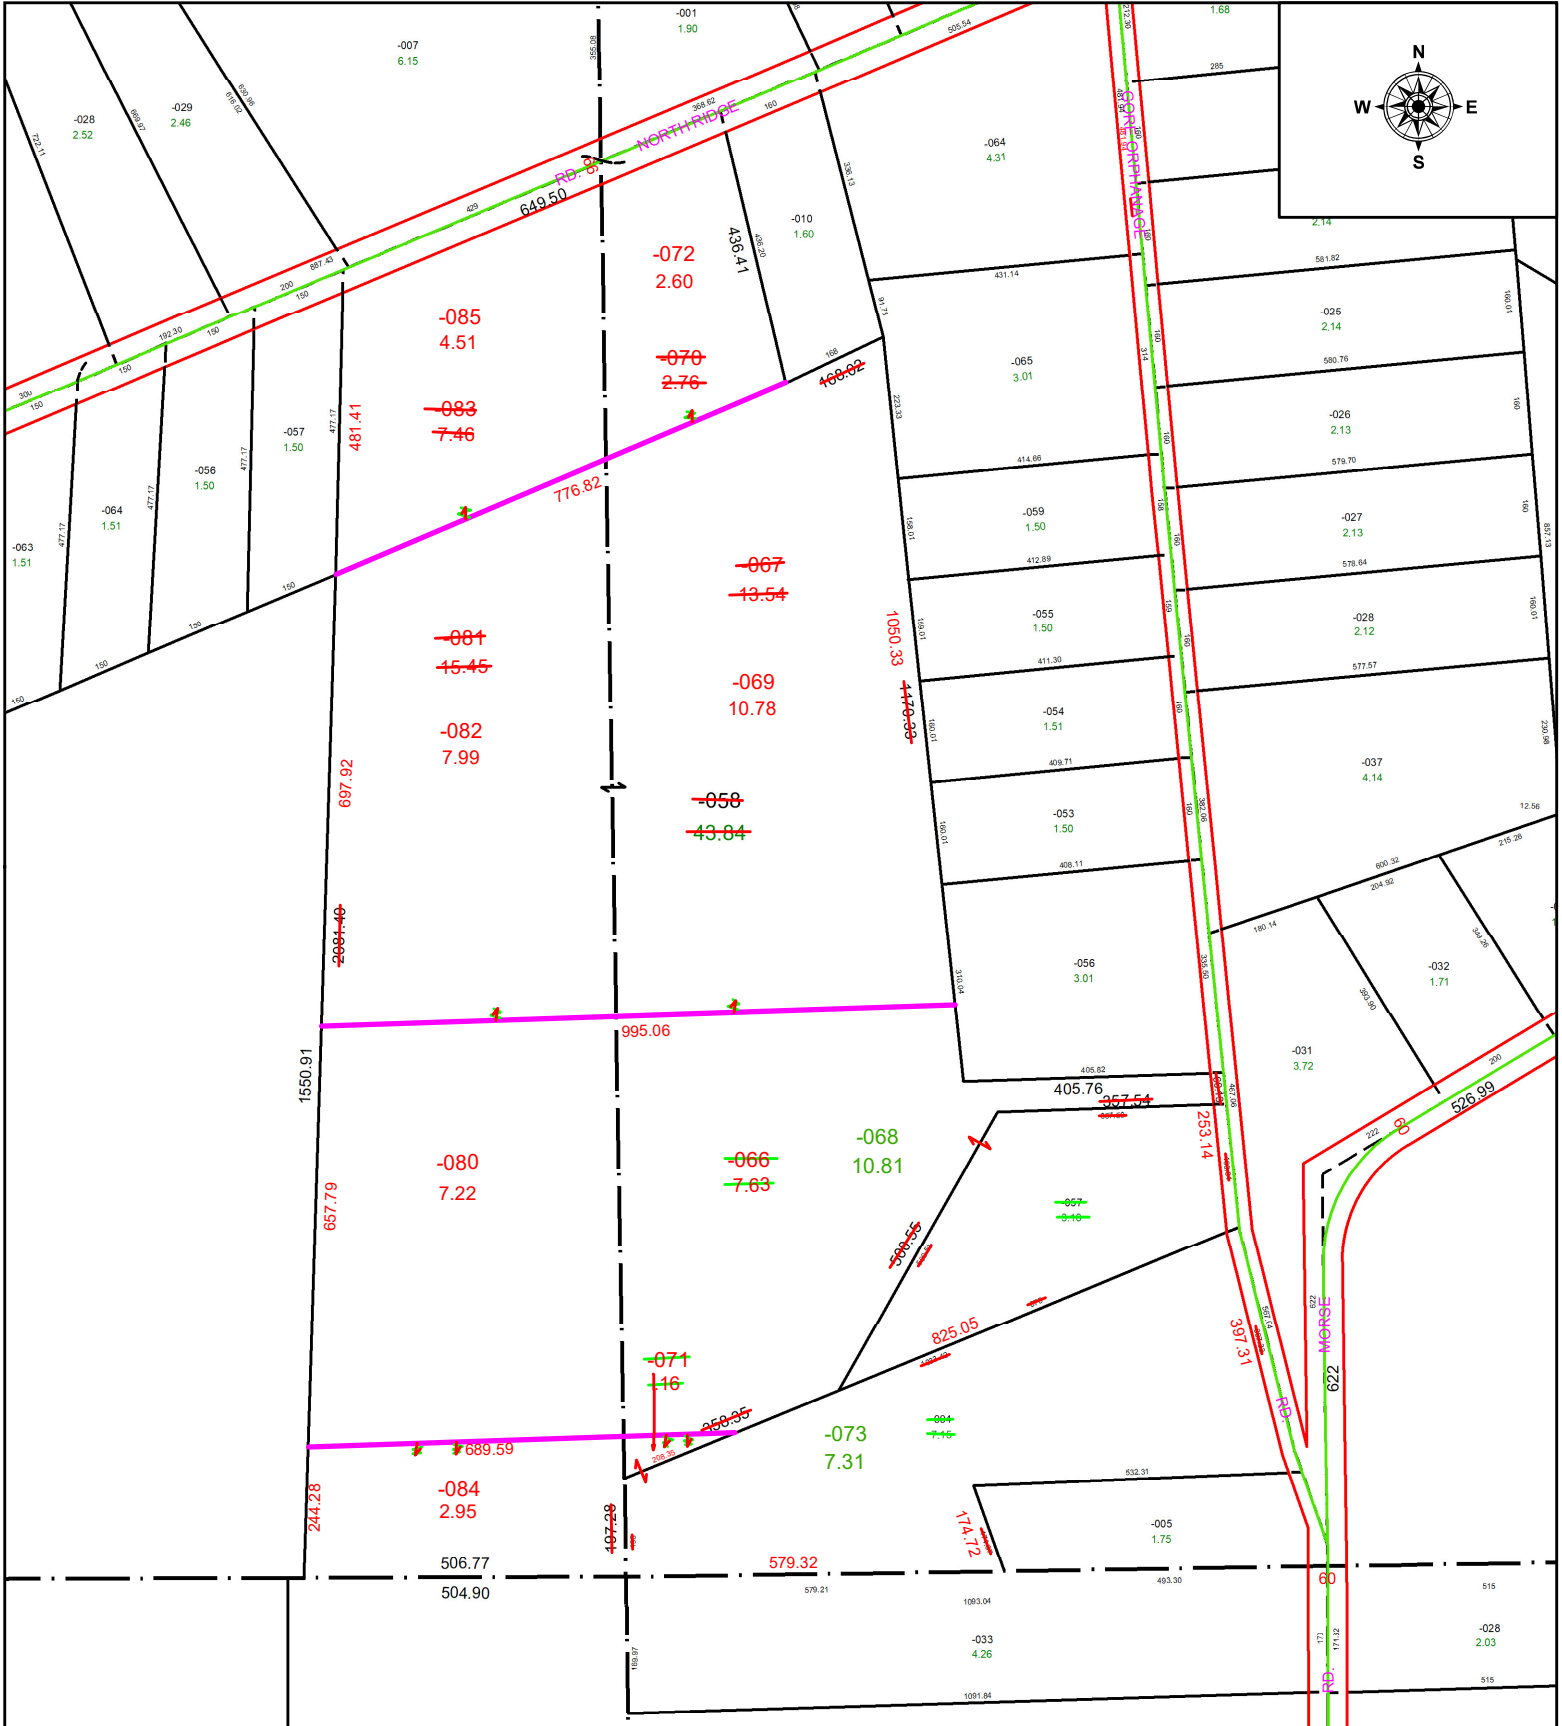

**SPLITS/DEEDS PROCESSED**  
 LORAIN COUNTY TAX MAP DEPARTMENT  
 226 MIDDLE AVE. ELYRIA, OH

SURVEYED BY: JOHN DECHANT JR. SURVEY # 50735  
 CLOSURE: 1: 307890  
 MAP PAGE(S): 01-00-063 & 01-00-064  
 APPROVED BY: WRZ DATE: 2/9/2023  
 SCALE: 1" = 300 PRIOR INSTRUMENT: #2022-0897867