
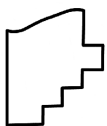


PARENT PARCEL: 03-00-087-102-025

CHILD PARCEL: 03-00-087-102-026, -027, -028

STARTING POINT: **UNCOMBINATION**

21-04623-U

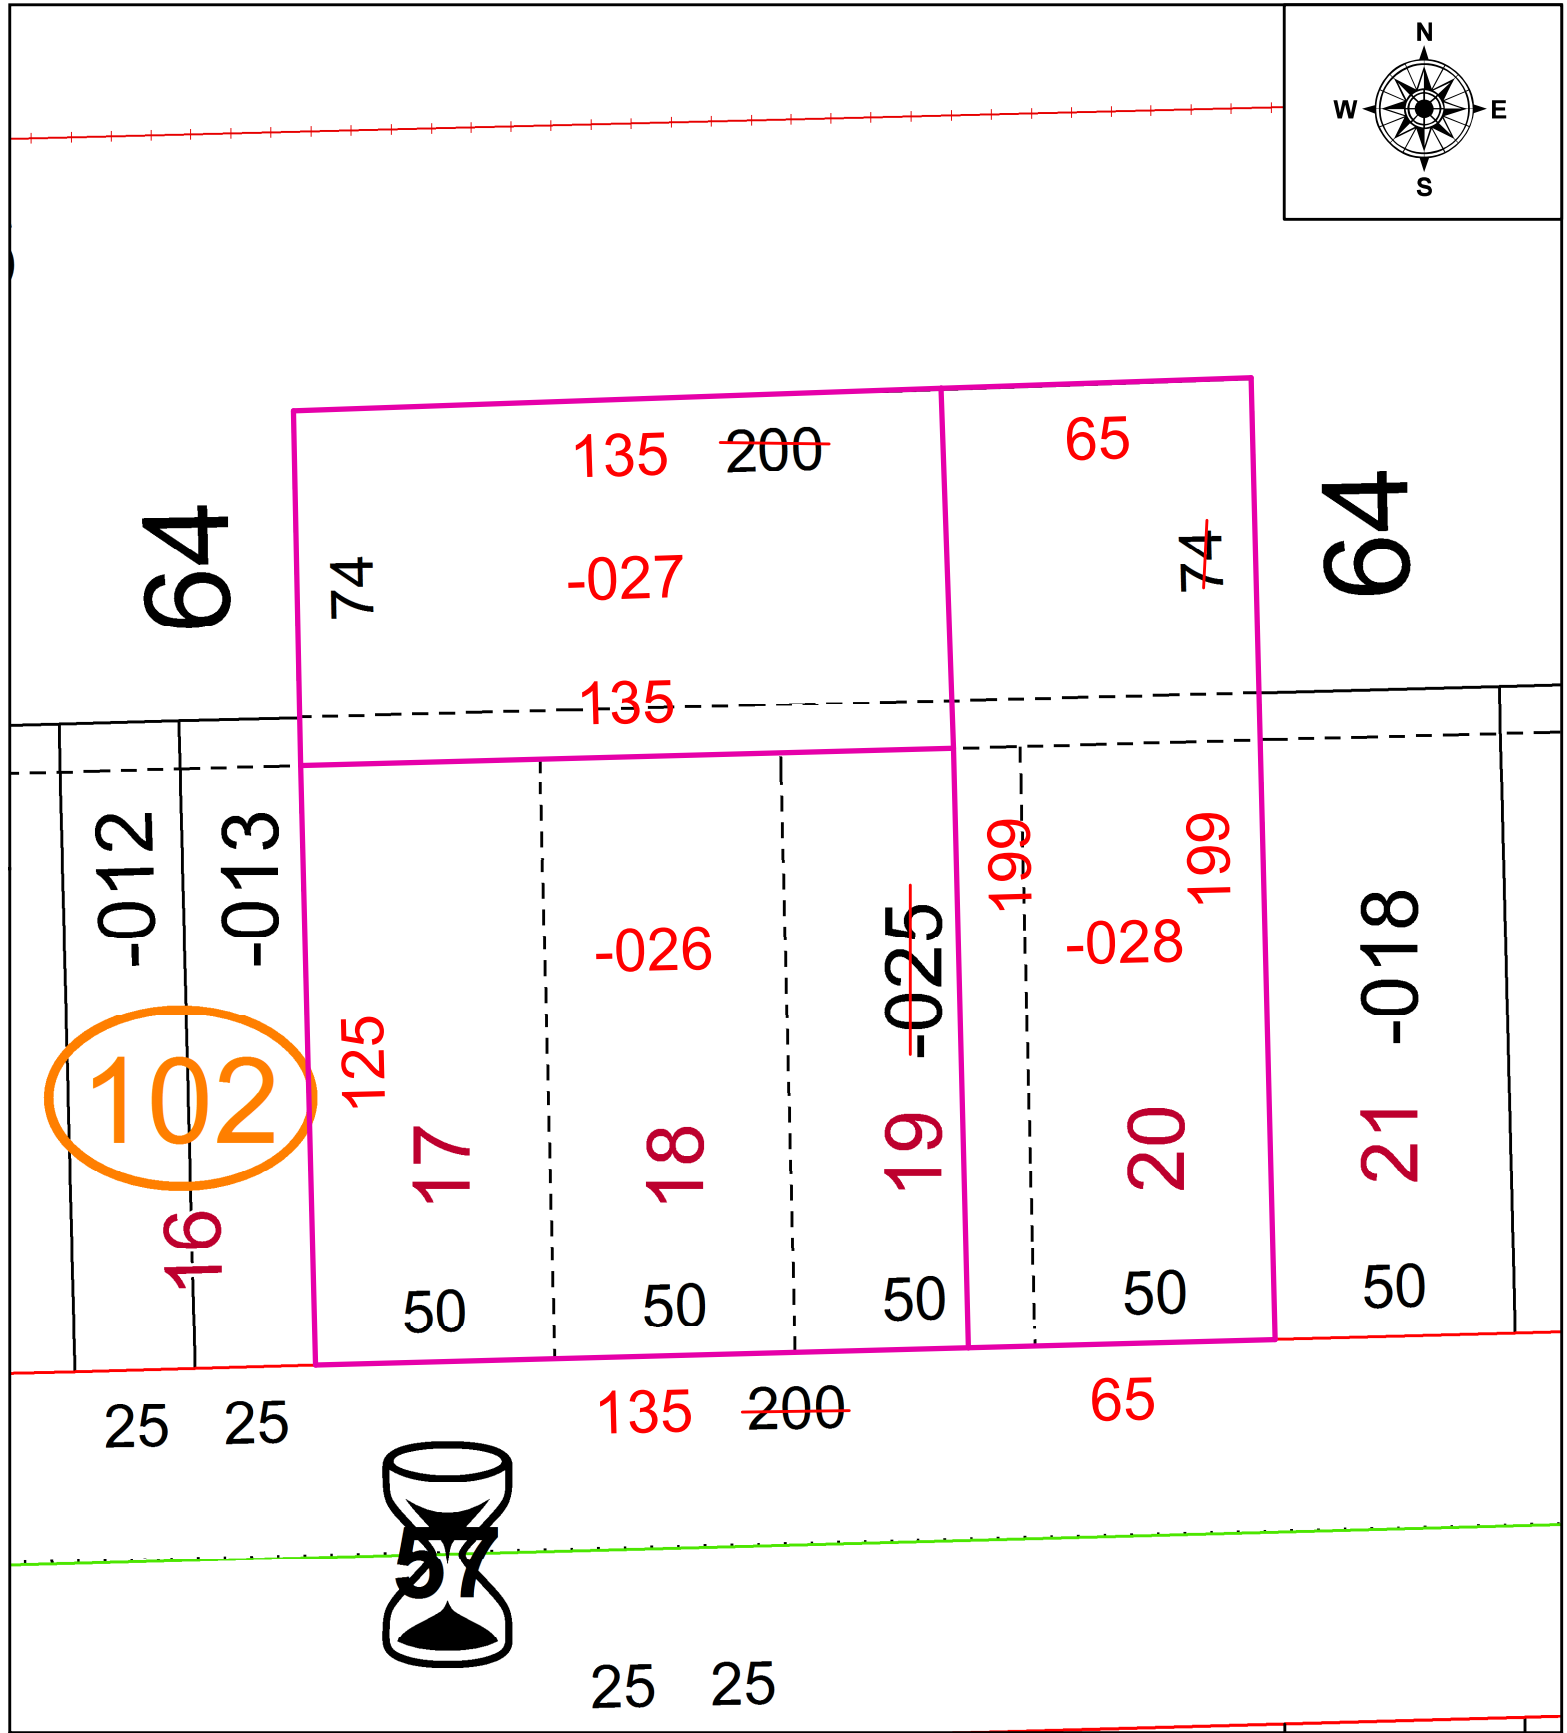

**SPLITS/DEEDS PROCESSED**  
 LORAIN COUNTY TAX MAP DEPARTMENT  
 226 MIDDLE AVE. ELYRIA, OH

SURVEYED BY: N/A  
 CLOSURE: N/A  
 MAP PAGE(S): 03-00-095-A  
 APPROVED BY: AC DATE: 8/10/2021  
 SCALE: 1" = 40' PRIOR INSTRUMENT: 2019- 0732276