


PARENT PARCEL: 07-00-009-120-034



CHILD PARCEL: **AC. CORR. PER PRIOR DEED/SURVEY INSTR. # 1990606762**

21-04624-A

STARTING POINT: C/L OF LEAR NAGLE RD & CHESNUT RIDGE RD.

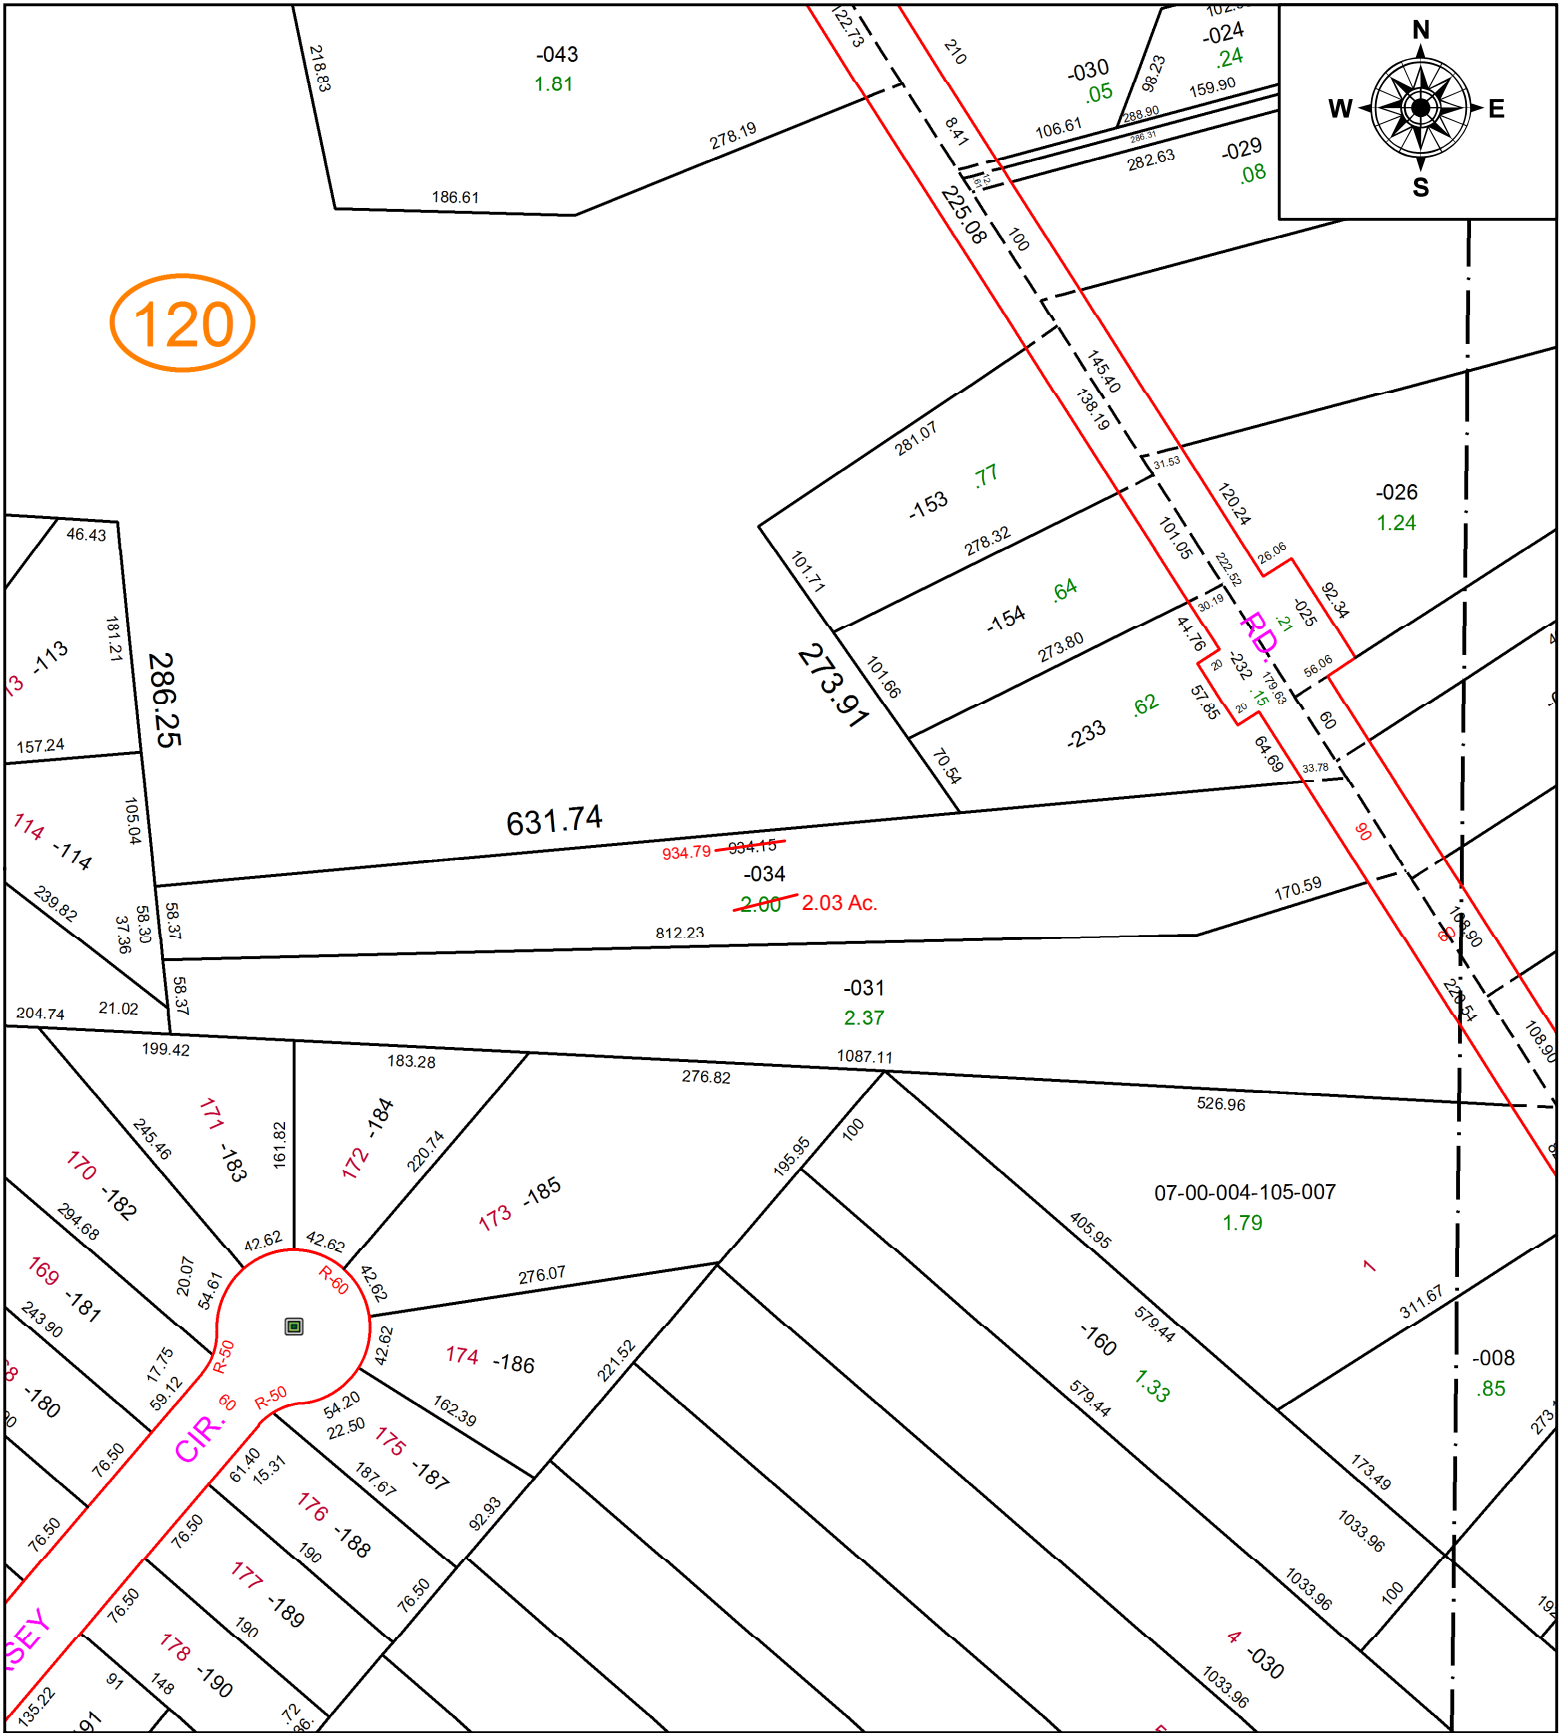

120

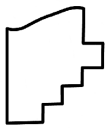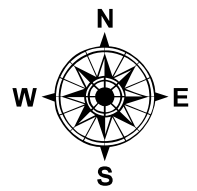

SPLITS/DEEDS PROCESSED
 LORAIN COUNTY TAX MAP DEPARTMENT
 226 MIDDLE AVE. ELYRIA, OH

SURVEYED BY: GARY PENFOUND
CLOSURE: XXXXXXXXXXXX
MAP PAGE(S): 07-00-009
APPROVED BY: DMA **DATE:** 8/10/2021
SCALE: 1" = 150' **PRIOR INSTRUMENT:** 1990606762