
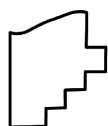
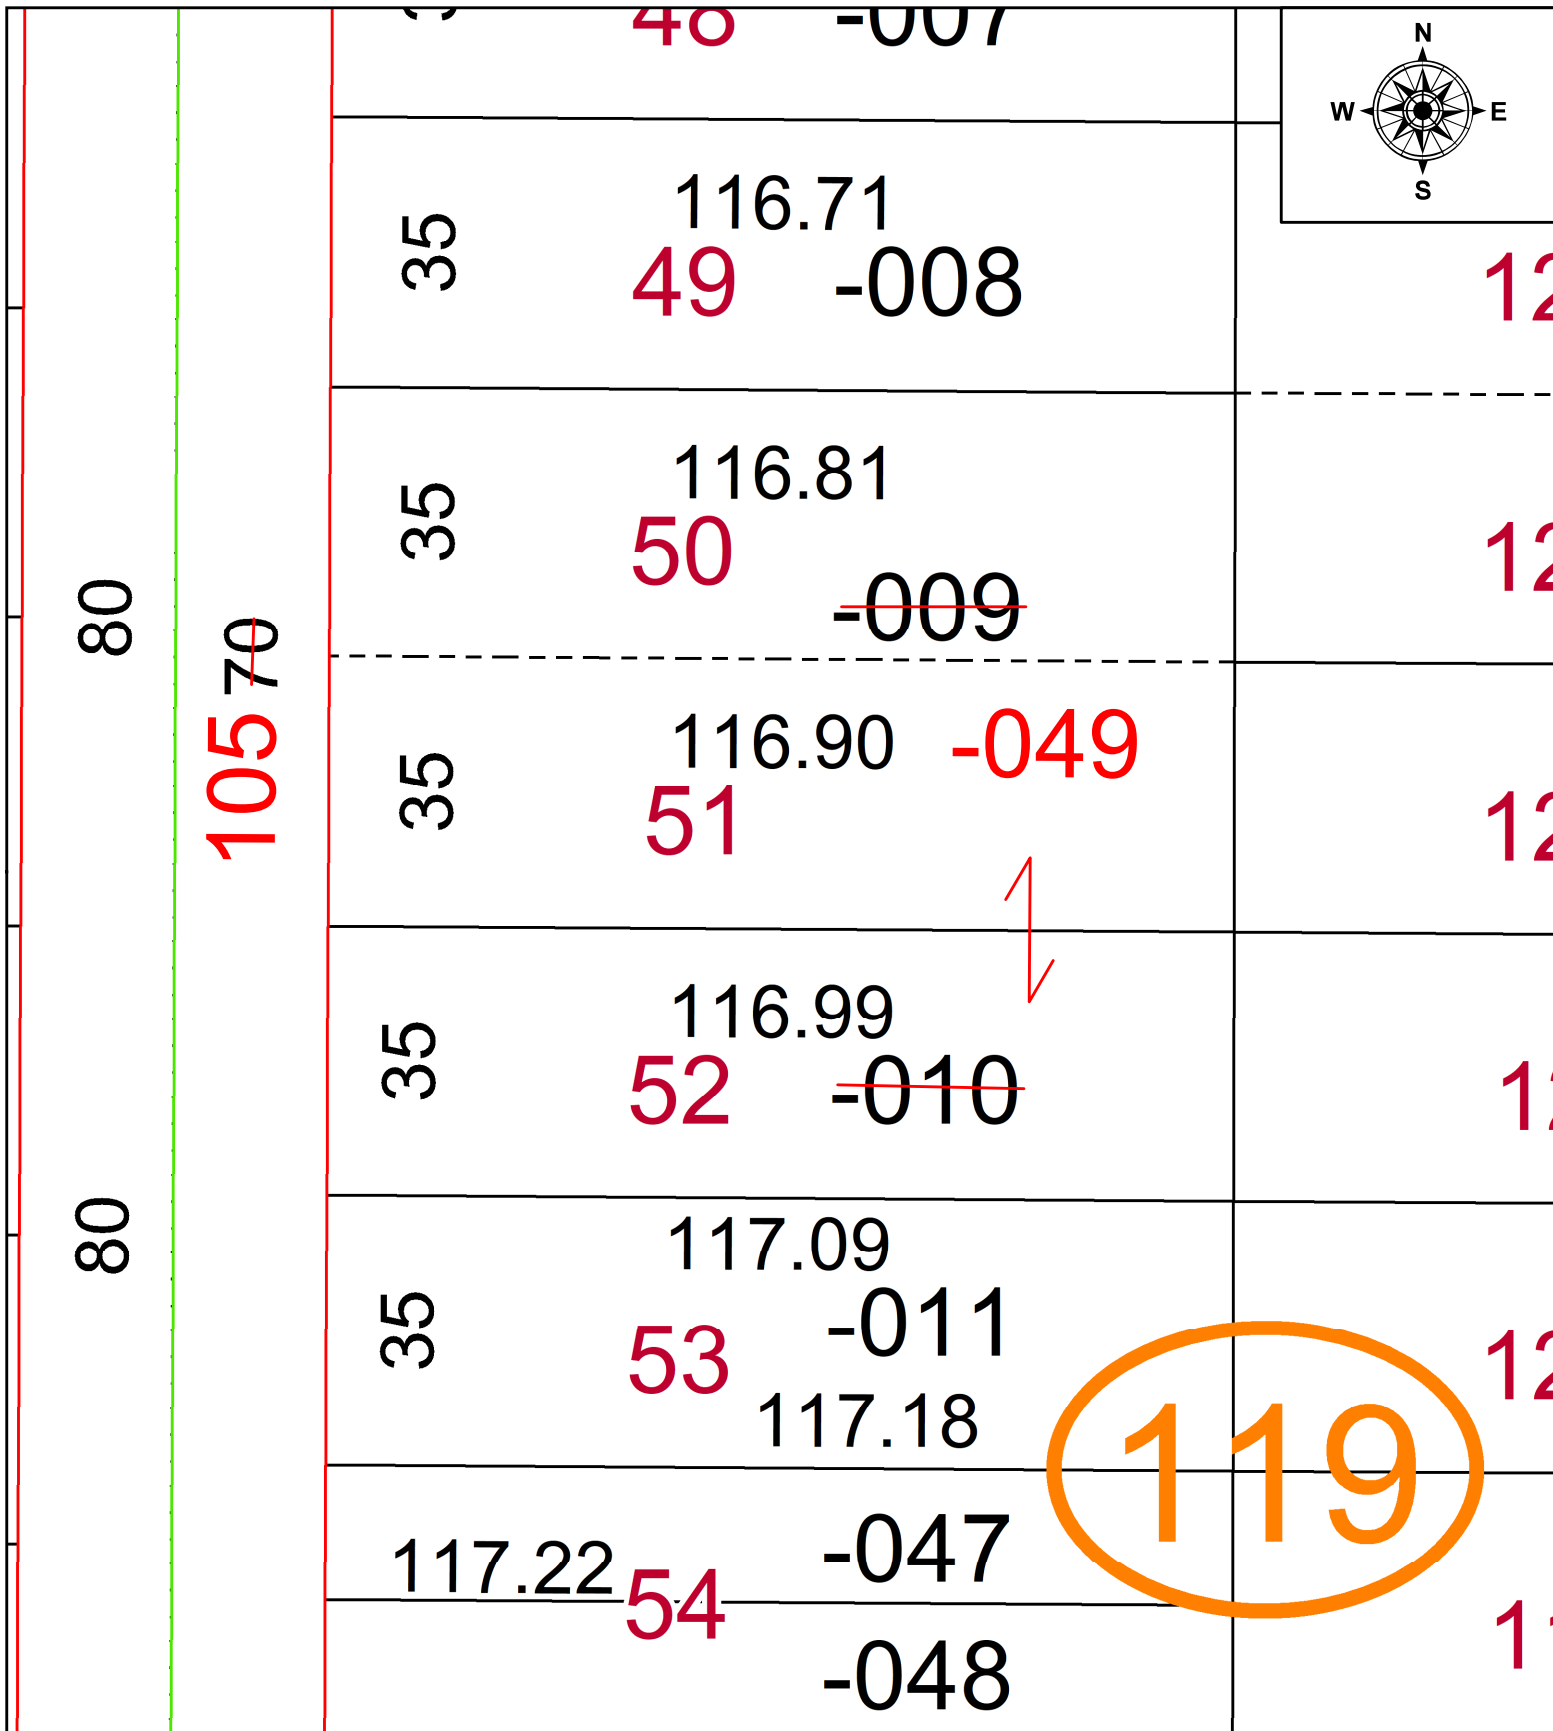


PARENT PARCEL: 04-00-019-119-009, -010

CHILD PARCEL: 04-00-019-119-049

STARTING POINT: COMBINATION PER DEED

23-04624

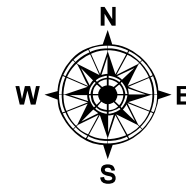

SPLITS/DEEDS PROCESSED
 LORAIN COUNTY TAX MAP DEPARTMENT
 226 MIDDLE AVE. ELYRIA, OH

SURVEYED BY: N/A SURV # N/A
 CLOSURE: N/A
 MAP PAGE(S): 04-00-019-A
 APPROVED BY: AC DATE: February 09, 2023
 SCALE: 1 in = 25 ft PRIOR INSTRUMENT: 2020- 0783799