


PARENT PARCEL: 01-00-003-118-001 THRU -005

CHILD PARCEL: 01-00-003-118-021


STARTING POINT: COMBINATION PER SURV BY JOHN A. DECHANT JR.

23-04625

DUP.#1
DUP.#2
3 TOTAL

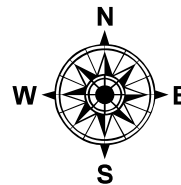

1.66

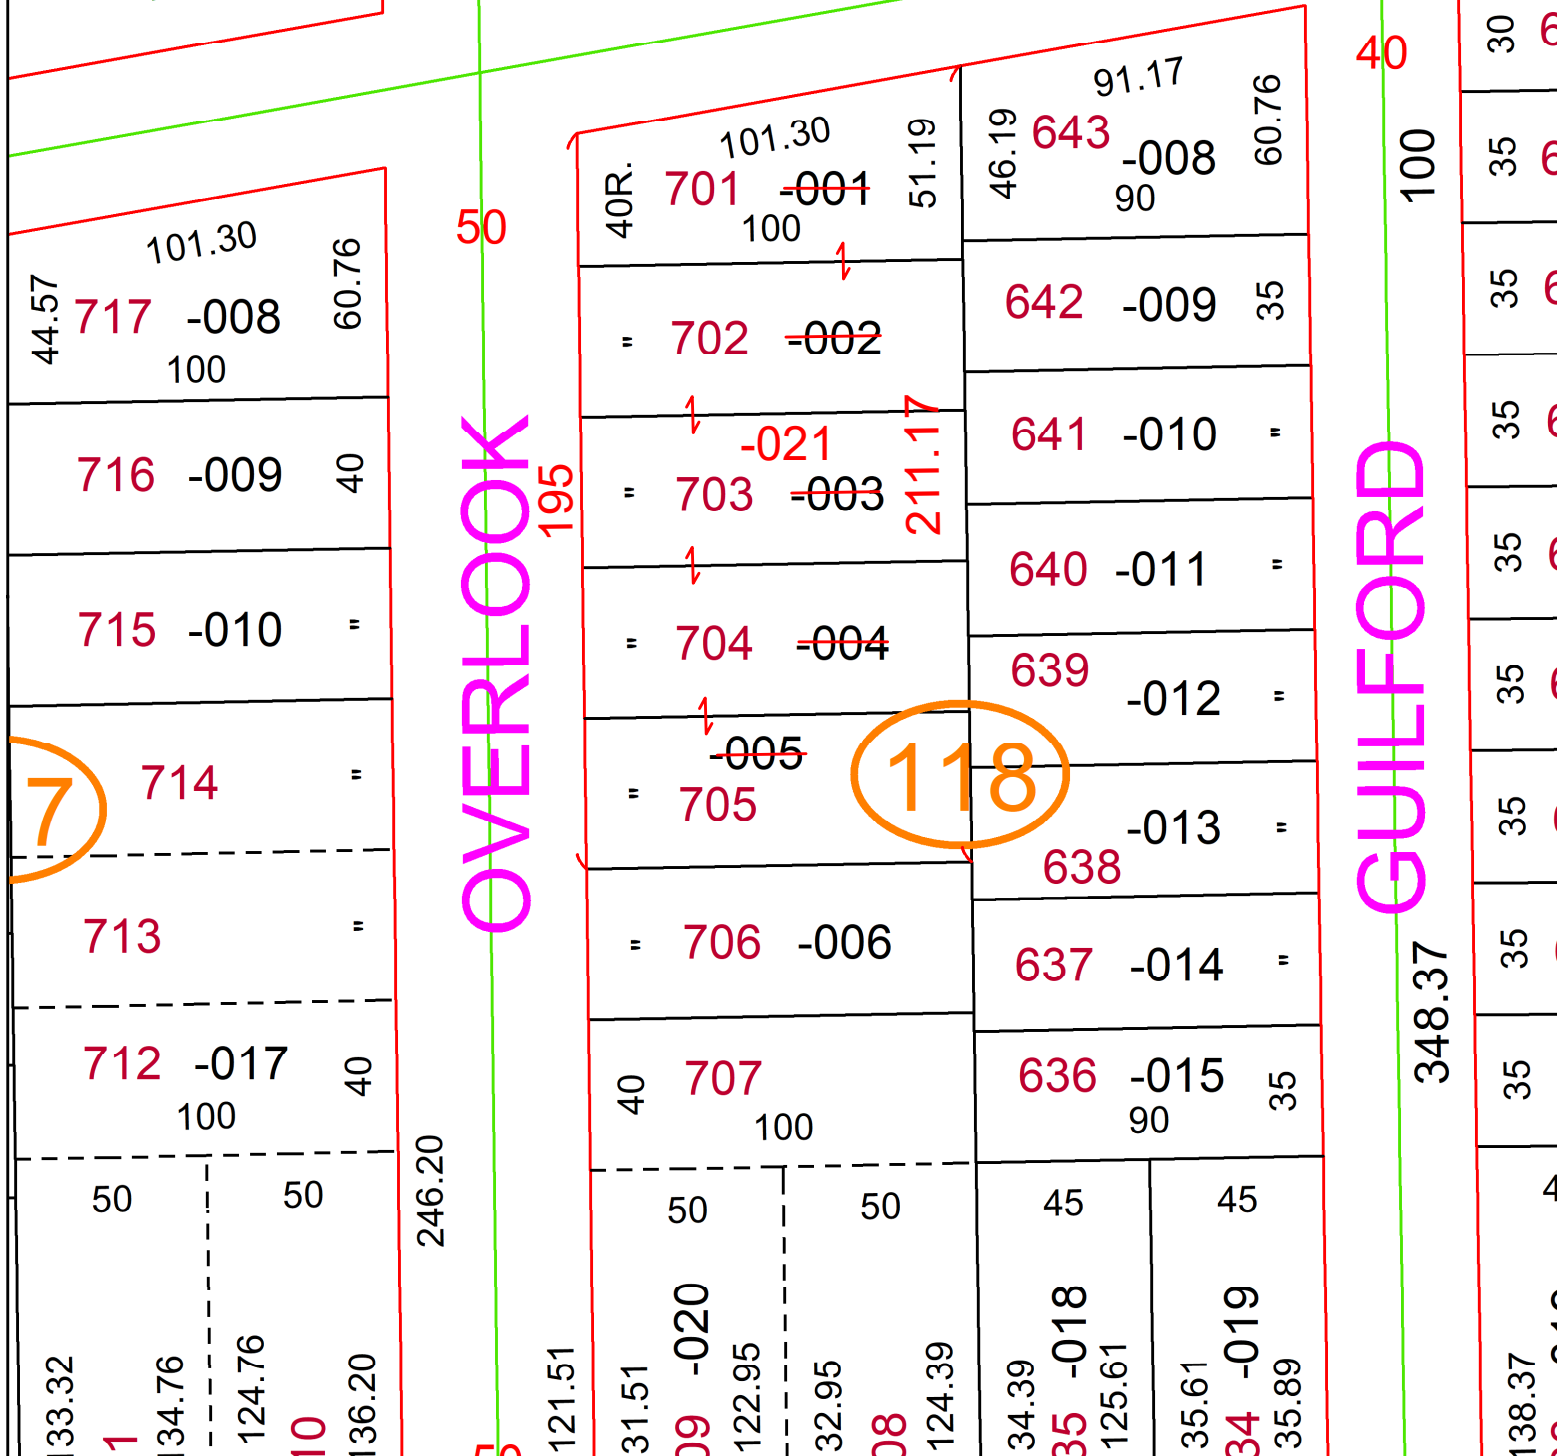

OVERLOOK

GUILFORD

118

7

133.32
1
134.76
124.76
10
136.20


246.20

121.51
31.51
09 -020
122.95
32.95
08
124.39

34.39
35 -018
125.61
135.61
34 -019
135.89

348.37

138.37
4

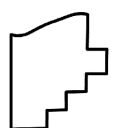

SPLITS/DEEDS PROCESSED

LORAIN COUNTY TAX MAP DEPARTMENT
226 MIDDLE AVE. ELYRIA, OH

SURVEYED BY: JOHN A. DECHANT JR SURV # 50804
 CLOSURE: 1: 395883
 MAP PAGE(S): 01-00-003-A
 APPROVED BY: AC DATE: February 09, 2023
 SCALE: 1 in = 50 ft PRIOR INSTRUMENT: 2022- 0889439