
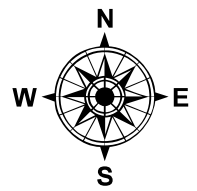


PARENT PARCEL: 07-00-004-104-021 **AC CORR PER SURV BY RICHARD A. THOMPSON JR.**

CHILD PARCEL: 07-00-004-104-075 THRU -079

STARTING POINT: C/L OF LEAR-NAGEL AND CHESTNUT RIDGE RD

23-04628

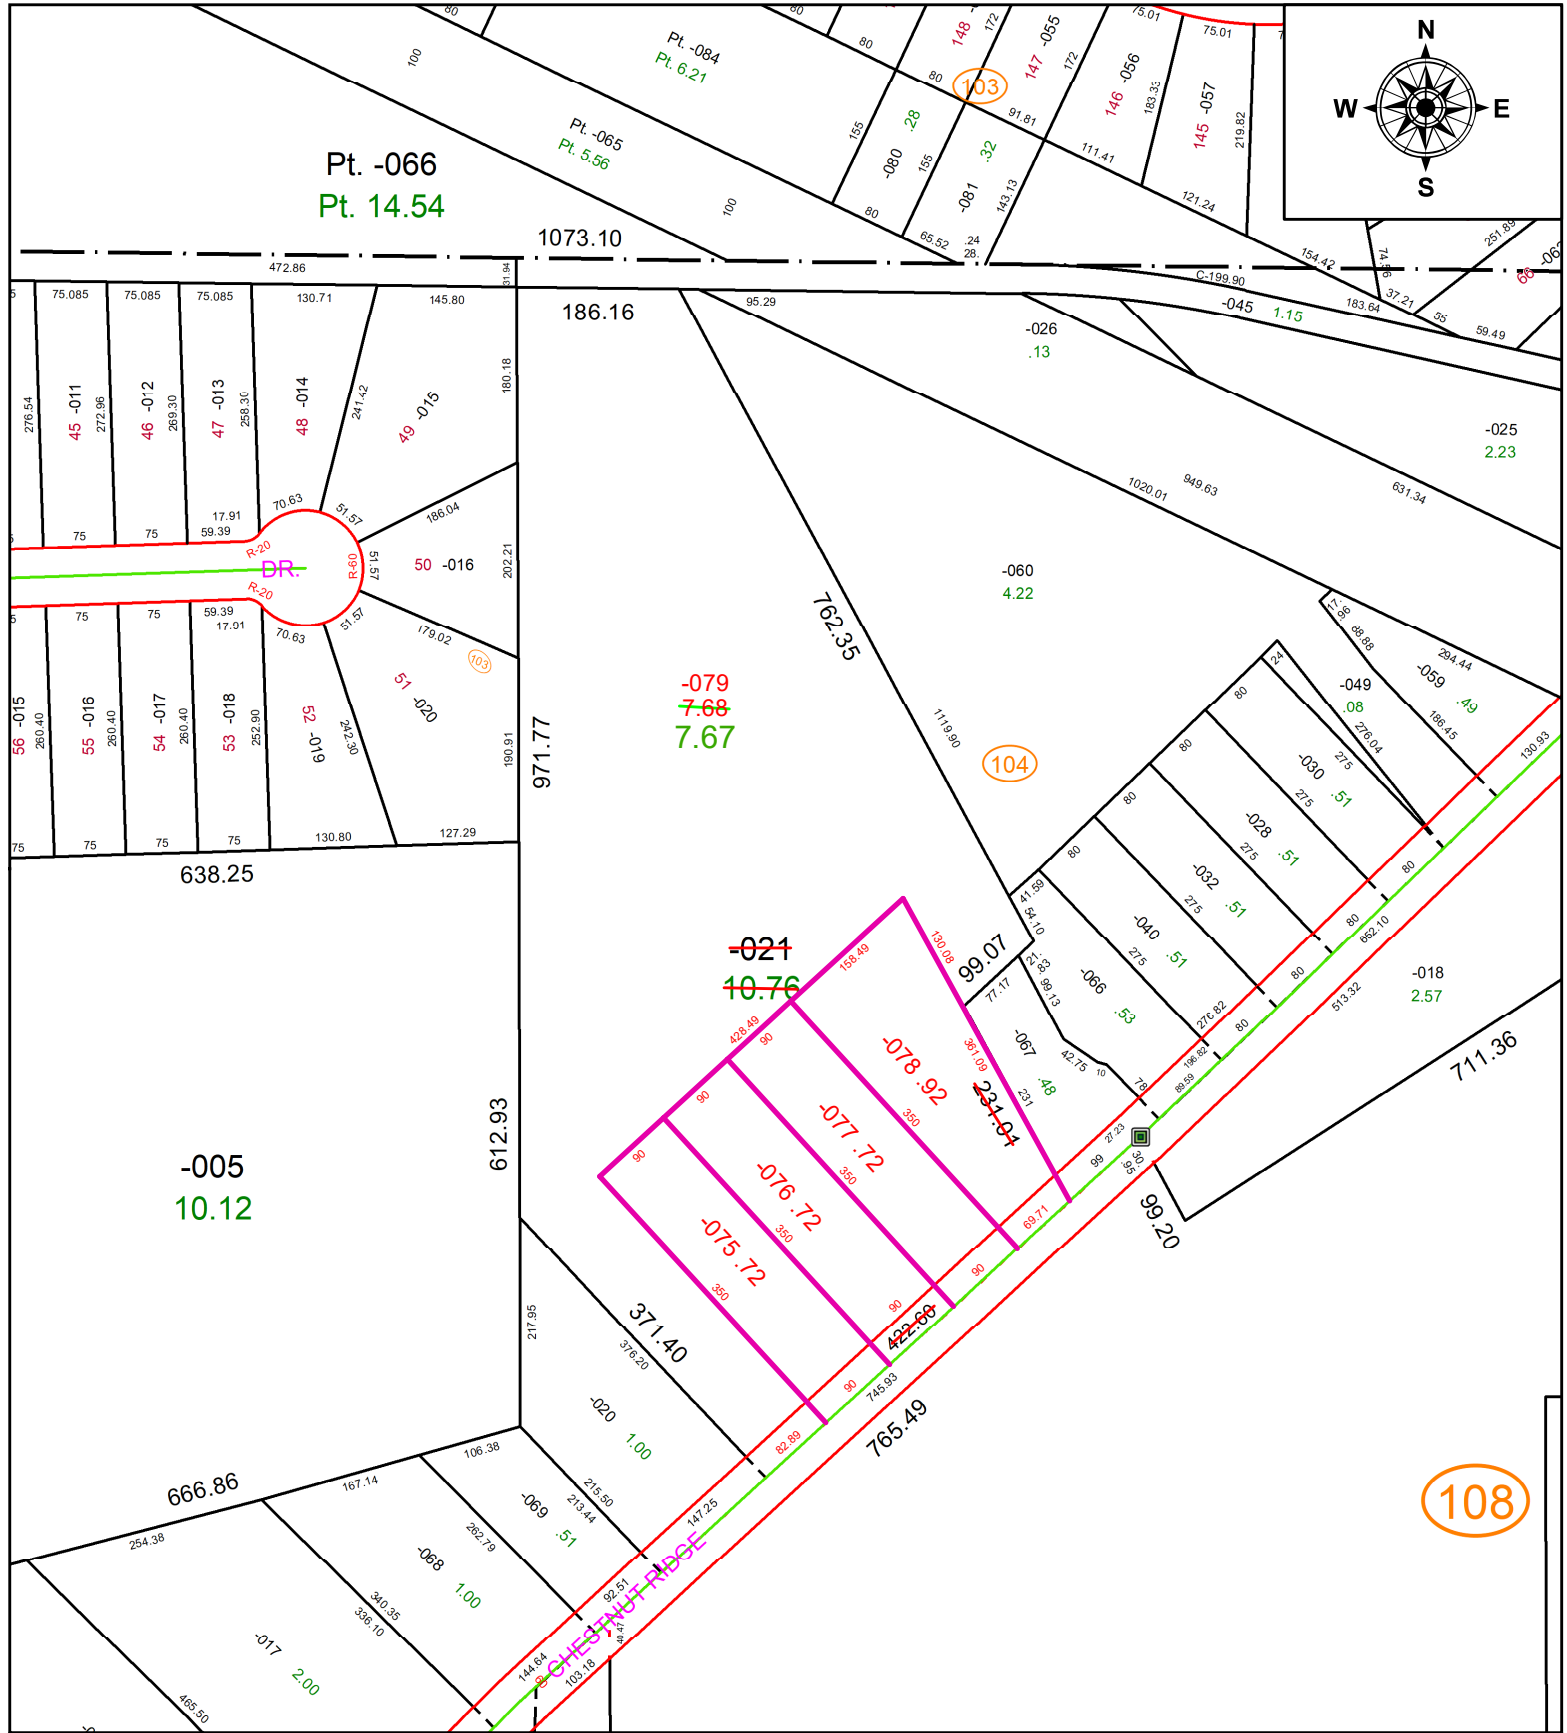

SPLITS/DEEDS PROCESSED
 LORAIN COUNTY TAX MAP DEPARTMENT
 226 MIDDLE AVE. ELYRIA, OH

SURVEYED BY: RICHARD A. THOMPSON JR. **SURV # 50806**
CLOSURE: 1: 2147483648
MAP PAGE(S): 07-00-004
APPROVED BY: AC **DATE:** February 14, 2023
SCALE: 1 in = 200 ft **PRIOR INSTRUMENT:** 2022- 0898602