
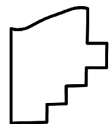


PARENT PARCEL: 03-00-045-102-002

CHILD PARCEL: ACREAGE CORRECTION

STARTING POINT: INTERSECTION OF C/LS OF E ERIE AVE AND ROOT RD

21-04633-C

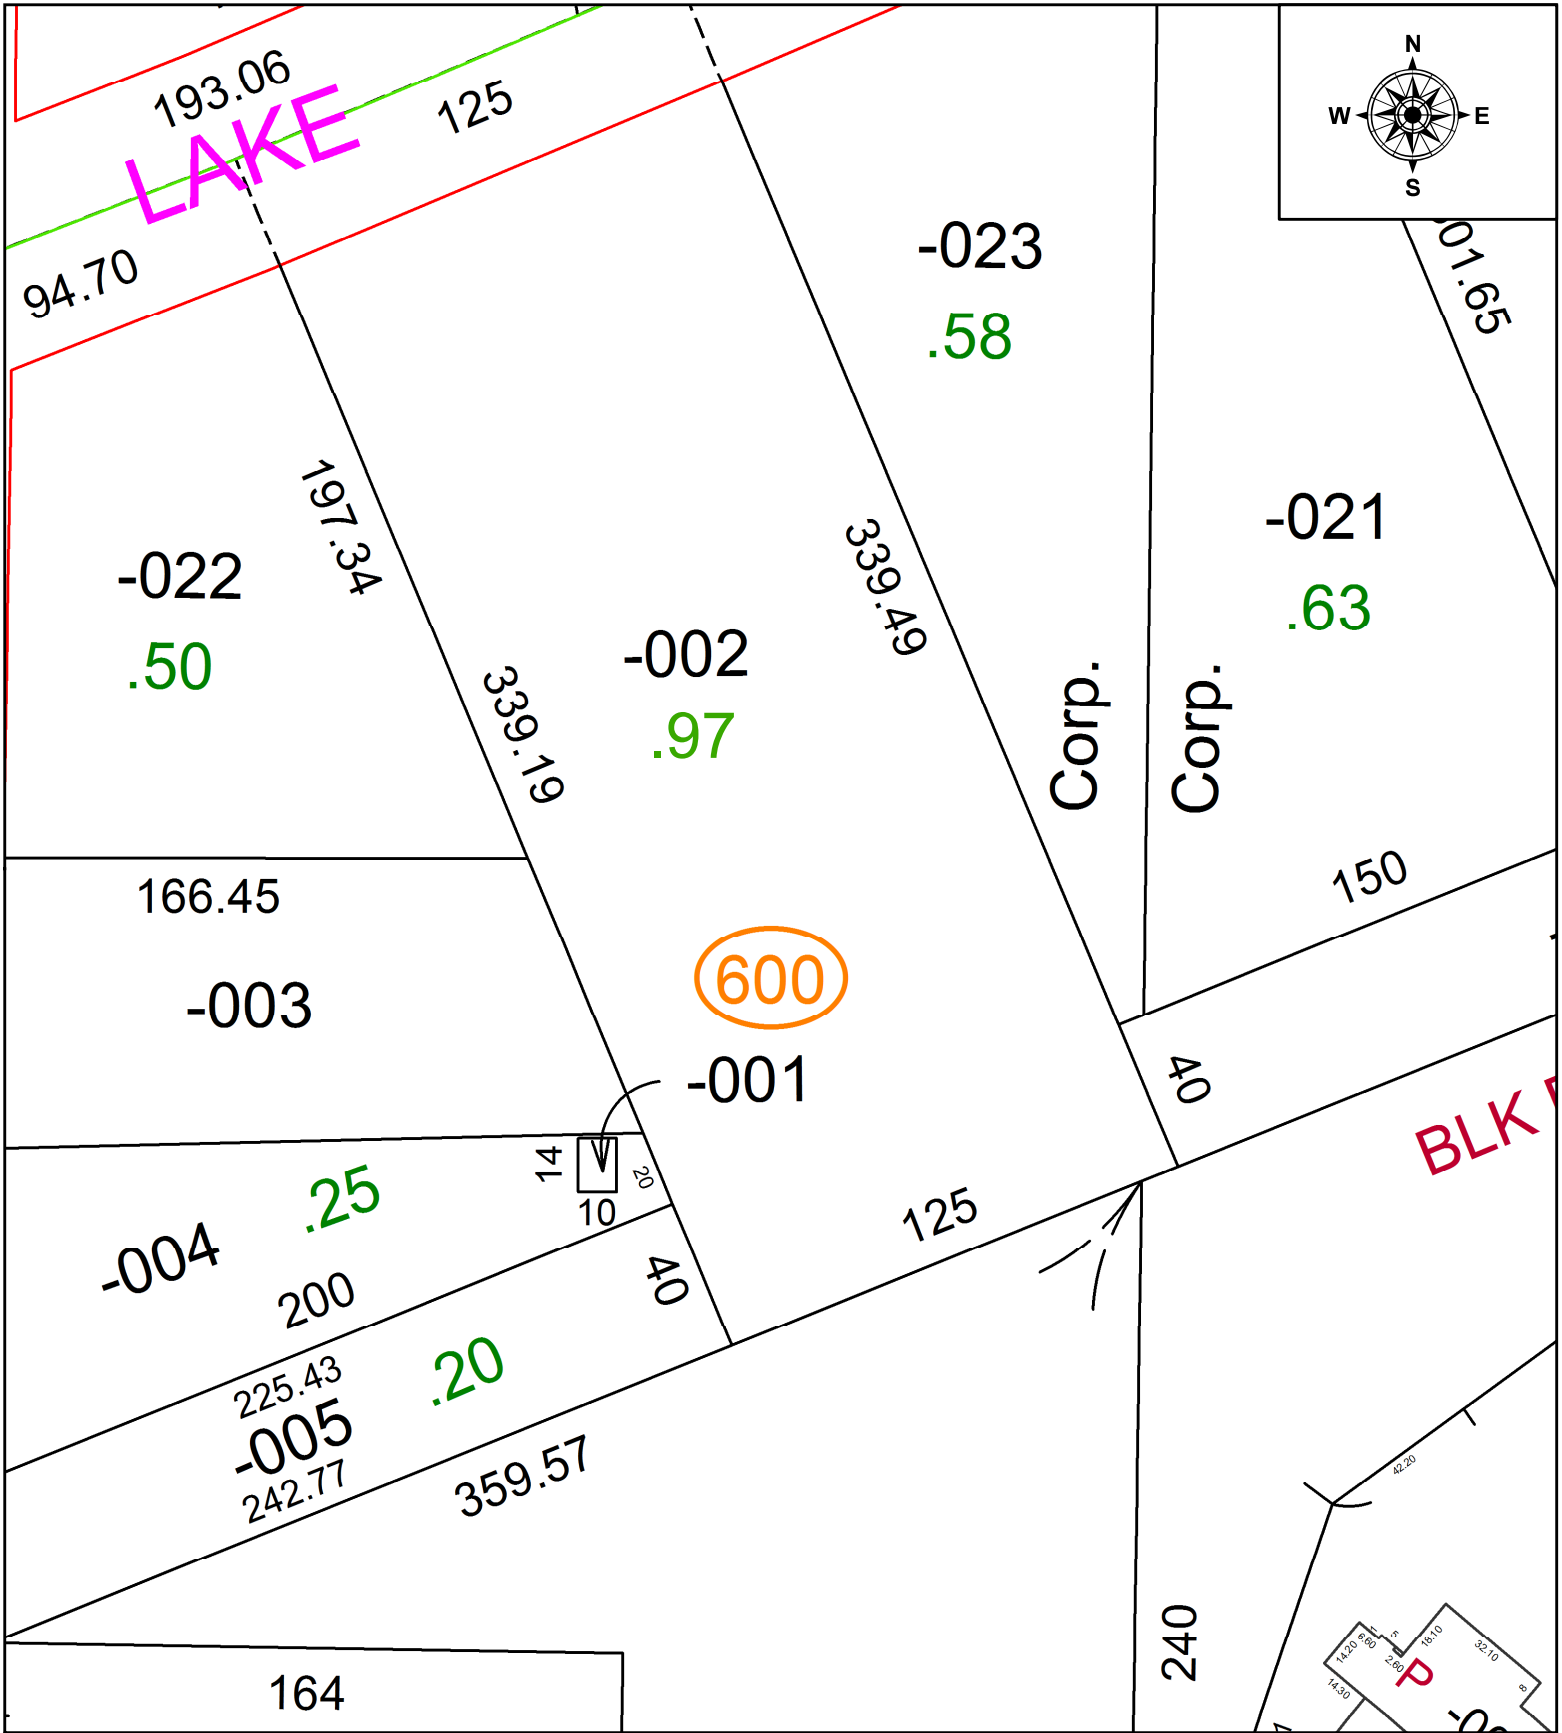

SPLITS/DEEDS PROCESSED
 LORAIN COUNTY TAX MAP DEPARTMENT
 226 MIDDLE AVE. ELYRIA, OH

SURVEYED BY: RAY HOLLIS

CLOSURE: 1: 14,576

MAP PAGE(S): 03-00-045

APPROVED BY: WRZ DATE: 8/25/2021

SCALE: 1" = 50 PRIOR INSTRUMENT: 2017-0640969