
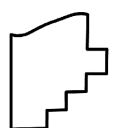


PARENT PARCEL: 06-23-003-102-035 & 06-24-045-101-032 STR. TRNS.

CHILD PARCEL: 06-23-003-102-067 & -068

STARTING POINT: CL OF MURRAY EDGE RD. & DELLEFIELD RD.

23-04639

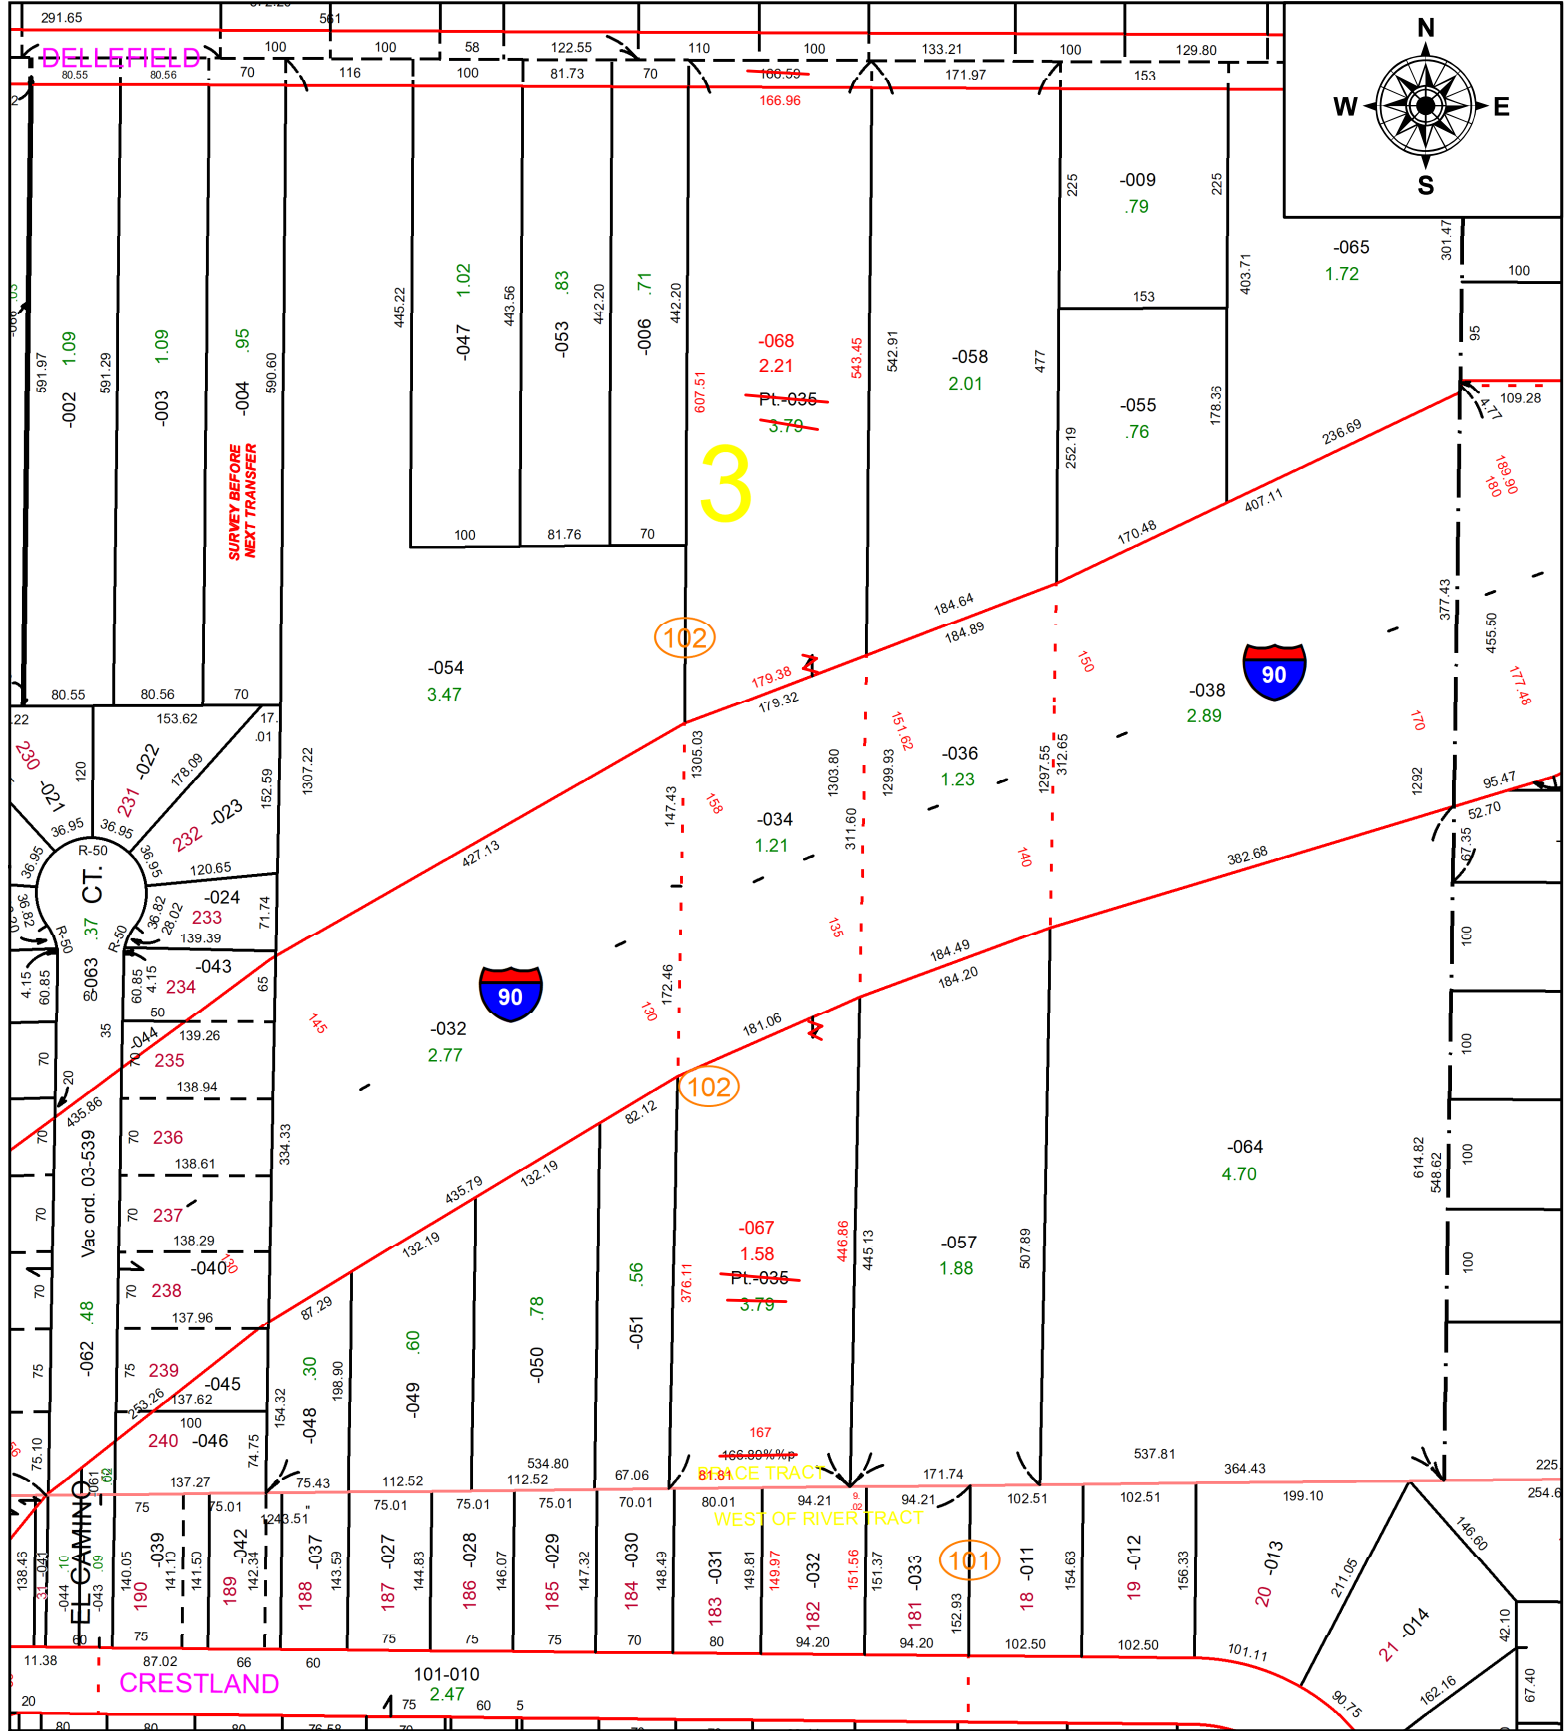

SPLITS/DEEDS PROCESSED
 LORAIN COUNTY TAX MAP DEPARTMENT
 226 MIDDLE AVE. ELYRIA, OH

SURVEYED BY: SCOTT CASEY **SURVEY #:** 50819
CLOSURE: 1:414571
MAP PAGE(S): 06-23-003 & 06-24-045
APPROVED BY: DMA **DATE:** 2/23/2023
SCALE: 1" = 175' **PRIOR INSTRUMENT:** 2017-0619924