

PARENT PARCEL: 11-00-085-000-009 & -015



CHILD PARCEL: 11-00-085-000-080

STARTING POINT: CL OF DURKEE RD & ROYALTON RD.

23-04642



ELYRIA-TWINSBURG

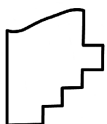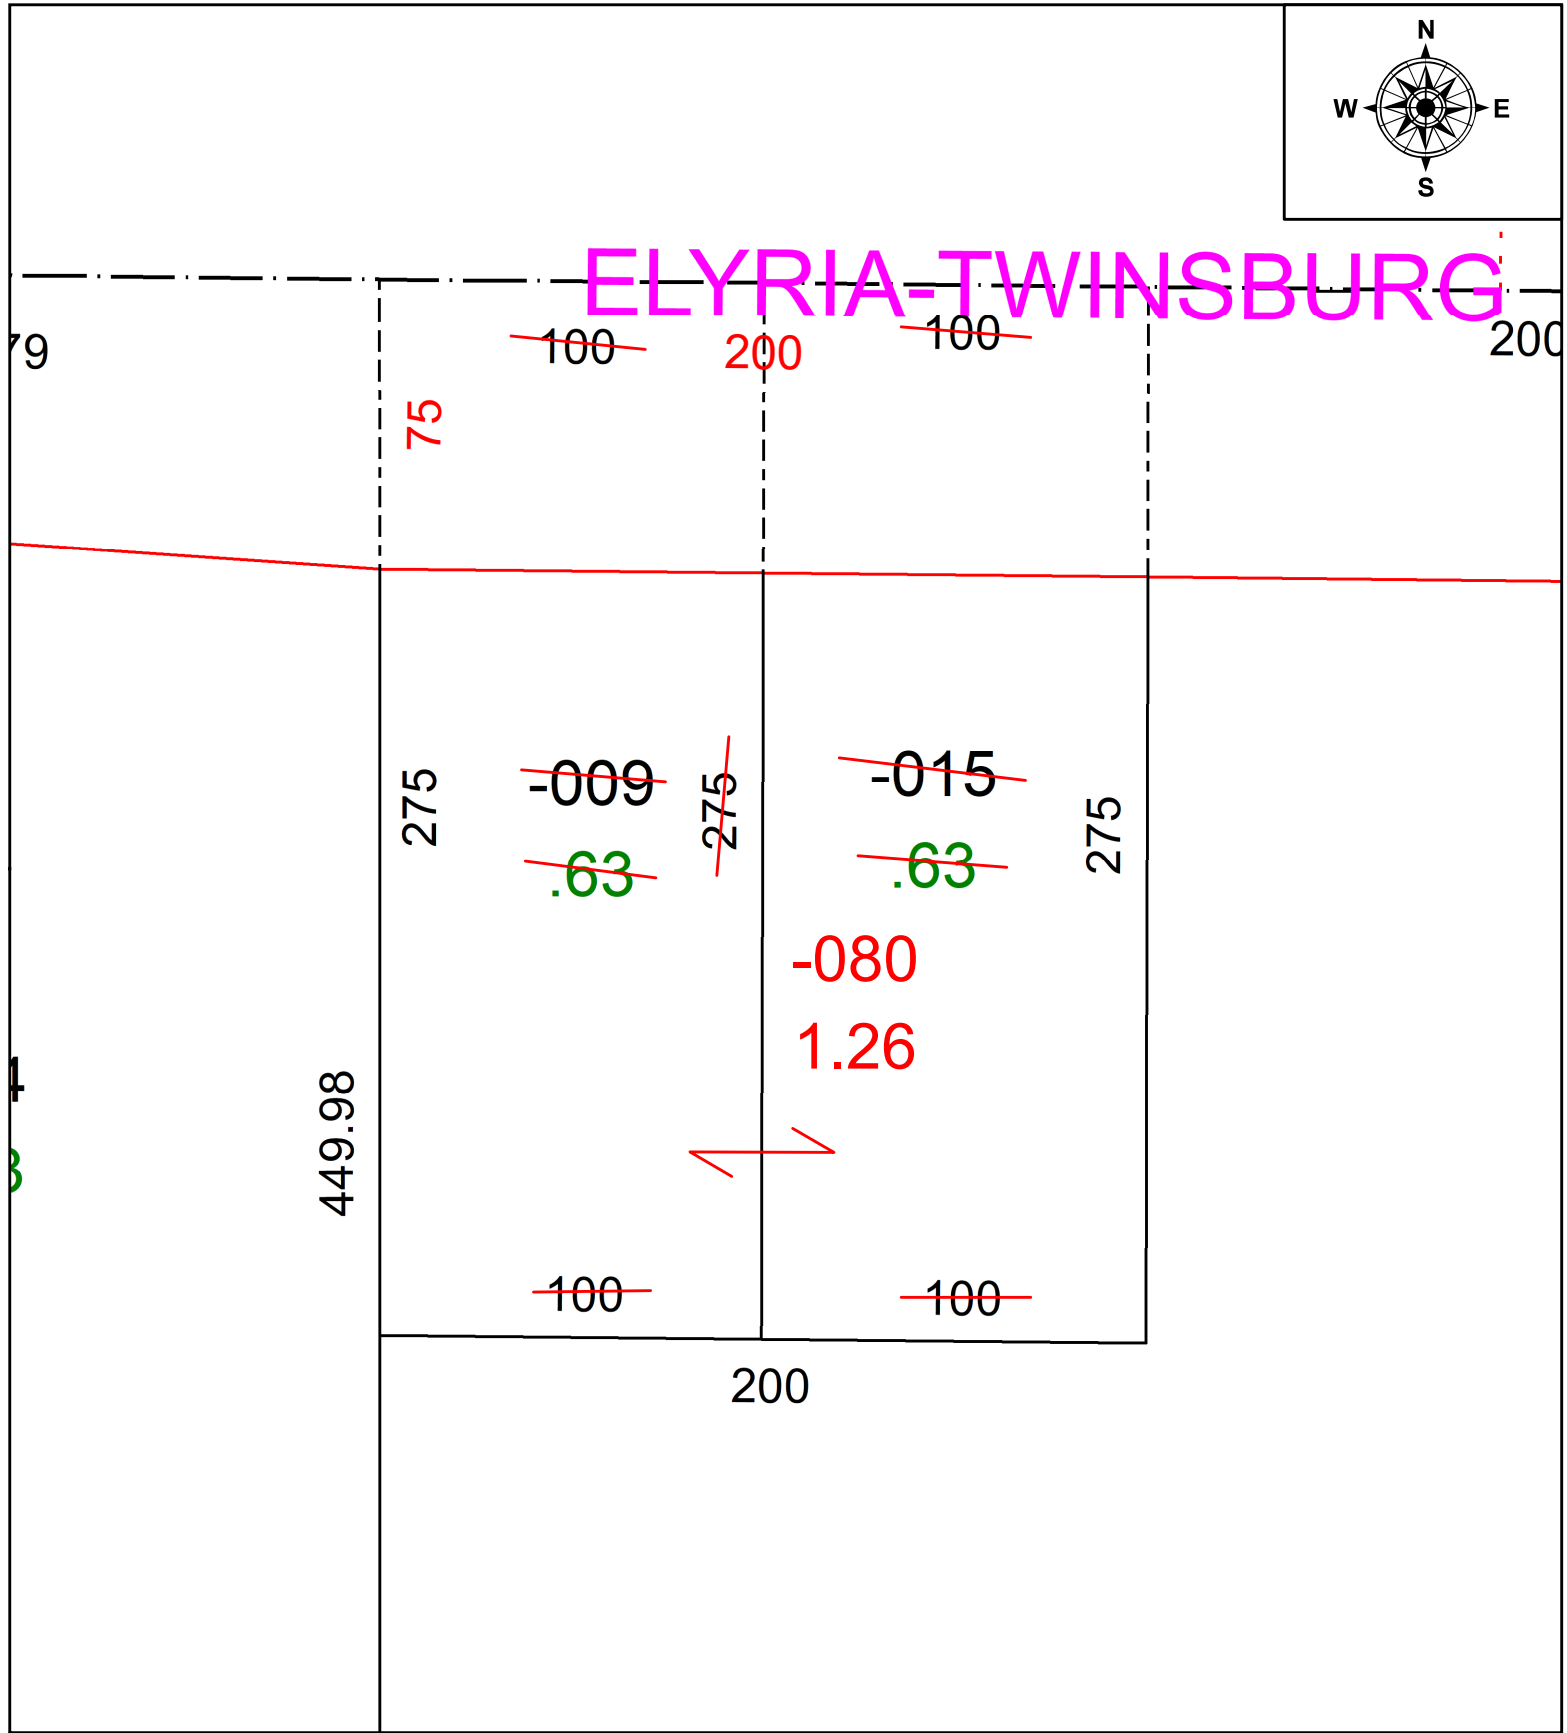

SPLITS/DEEDS PROCESSED
LORAIN COUNTY TAX MAP DEPARTMENT
226 MIDDLE AVE. ELYRIA, OH

SURVEYED BY: NATHAN SAUTTER SURVEY #: 50820
CLOSURE: 1:-2147483648
MAP PAGE(S): 11-00-085
APPROVED BY: DMA DATE: 2/27/2023
SCALE: 1" = 50' PRIOR INSTRUMENT: 2013-048774