


PARENT PARCEL: 12-00-093-000-017, -019, -028 & -036

CHILD PARCEL: 12-00-093-000-038 THRU -041

STARTING POINT: CL OF CAPEL RD. & N.E. CORNER O.L. 93

23-04643

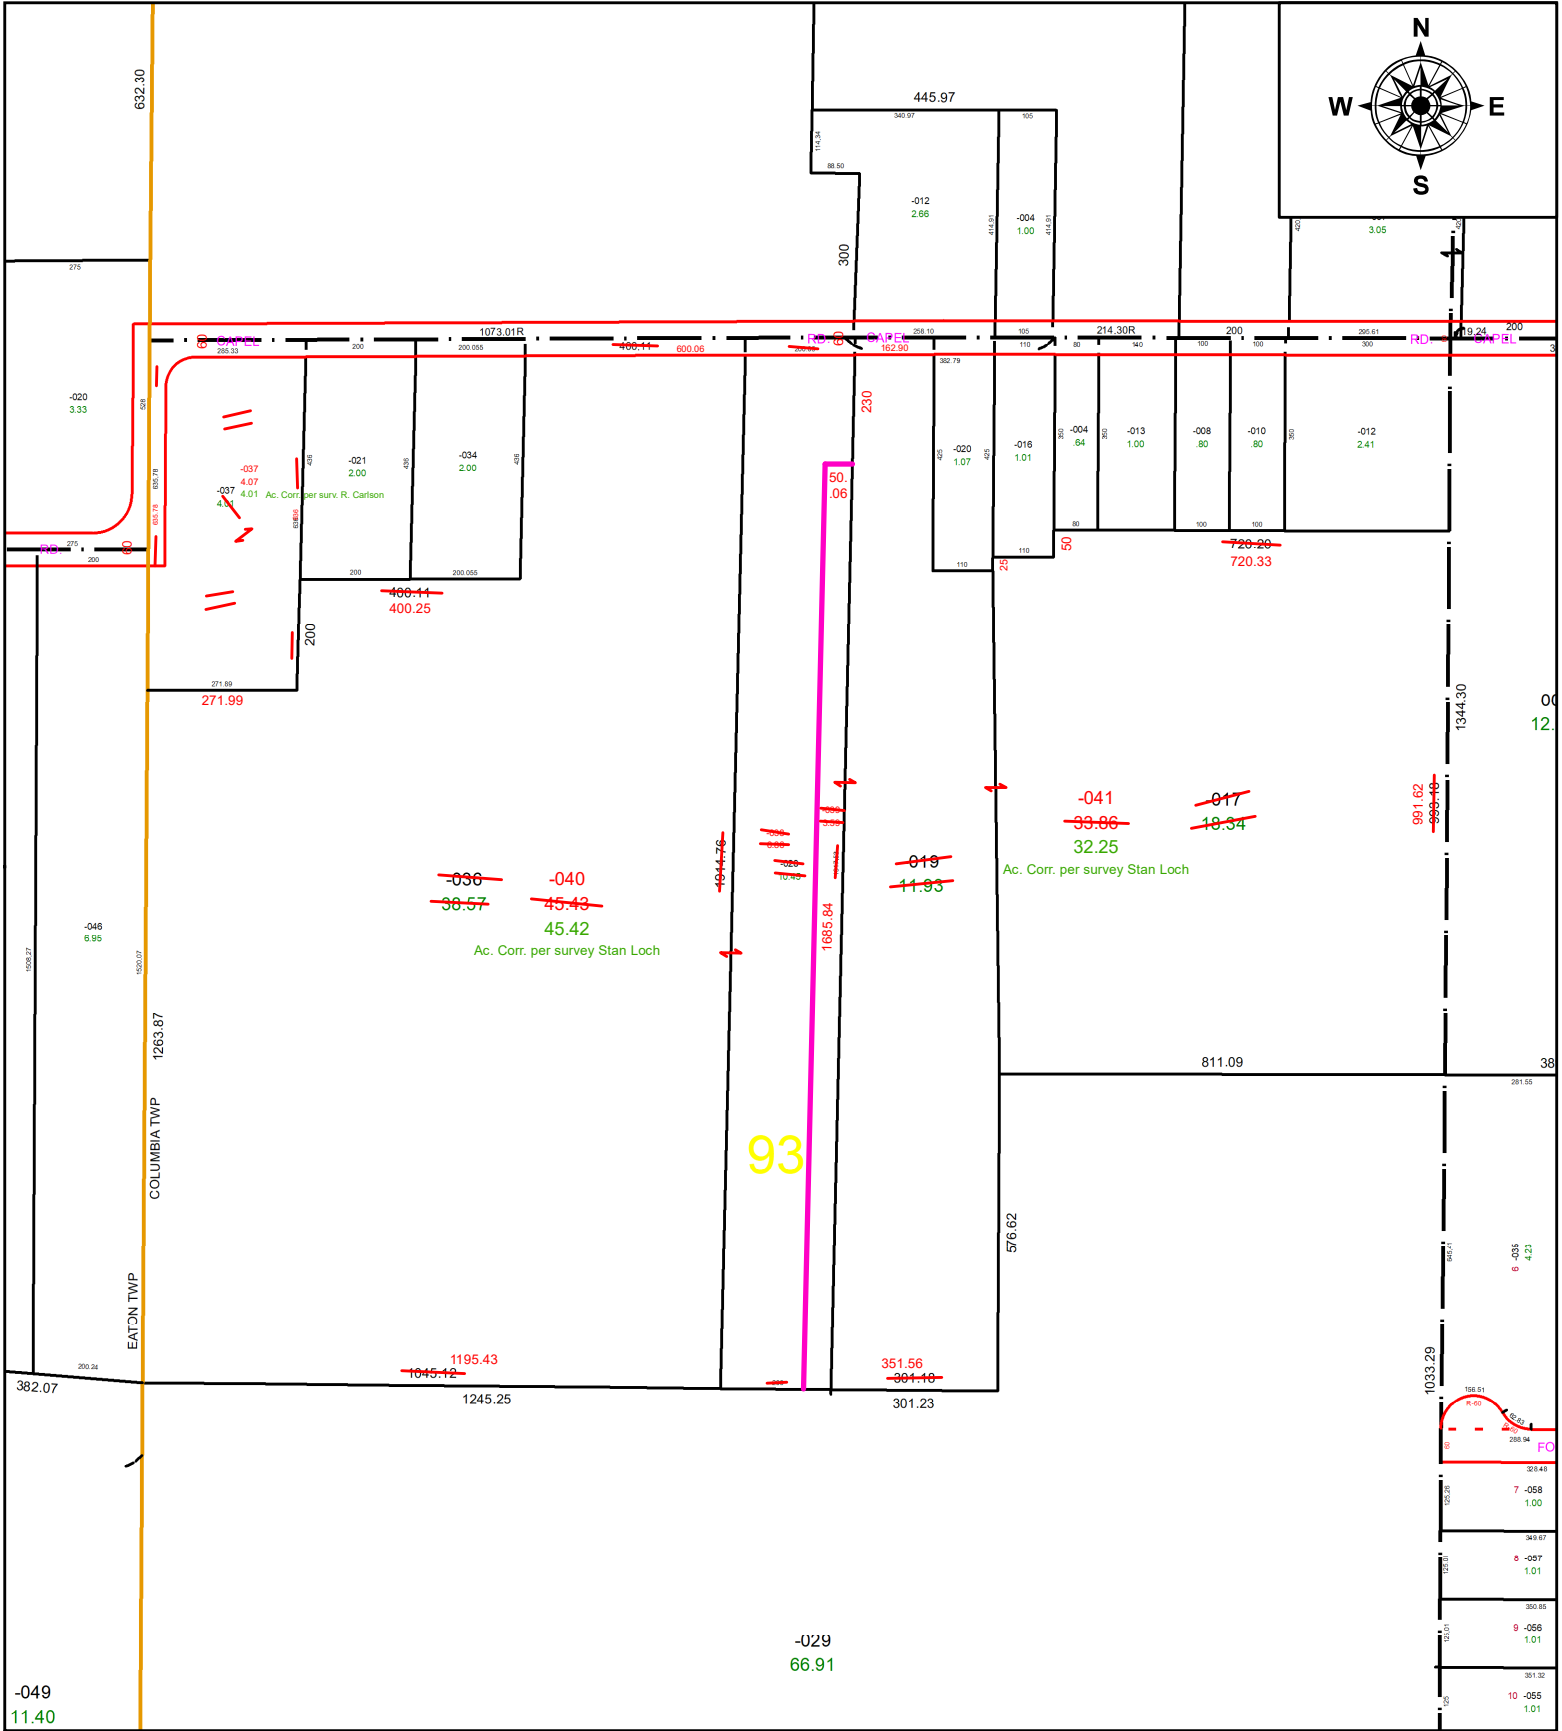

SPLITS/DEEDS PROCESSED
 LORAIN COUNTY TAX MAP DEPARTMENT
 226 MIDDLE AVE. ELYRIA, OH

SURVEYED BY: STAN LOCH **SURVEY #:** 50821
CLOSURE: 1:1292526
MAP PAGE(S): 12-00-093
APPROVED BY: DMA **DATE:** 2/27/2023
SCALE: 1" = 350' **PRIOR INSTRUMENT:** 2006-0173845