
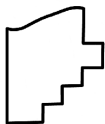


PARENT PARCEL: 07-00-006-101-099

CHILD PARCEL: AC CORR PER SURV BY MICHAEL A. STRAUB

STARTING POINT: C/L OF CENTER RIDGE AND MILLS CREEK LANE

21-04644-D

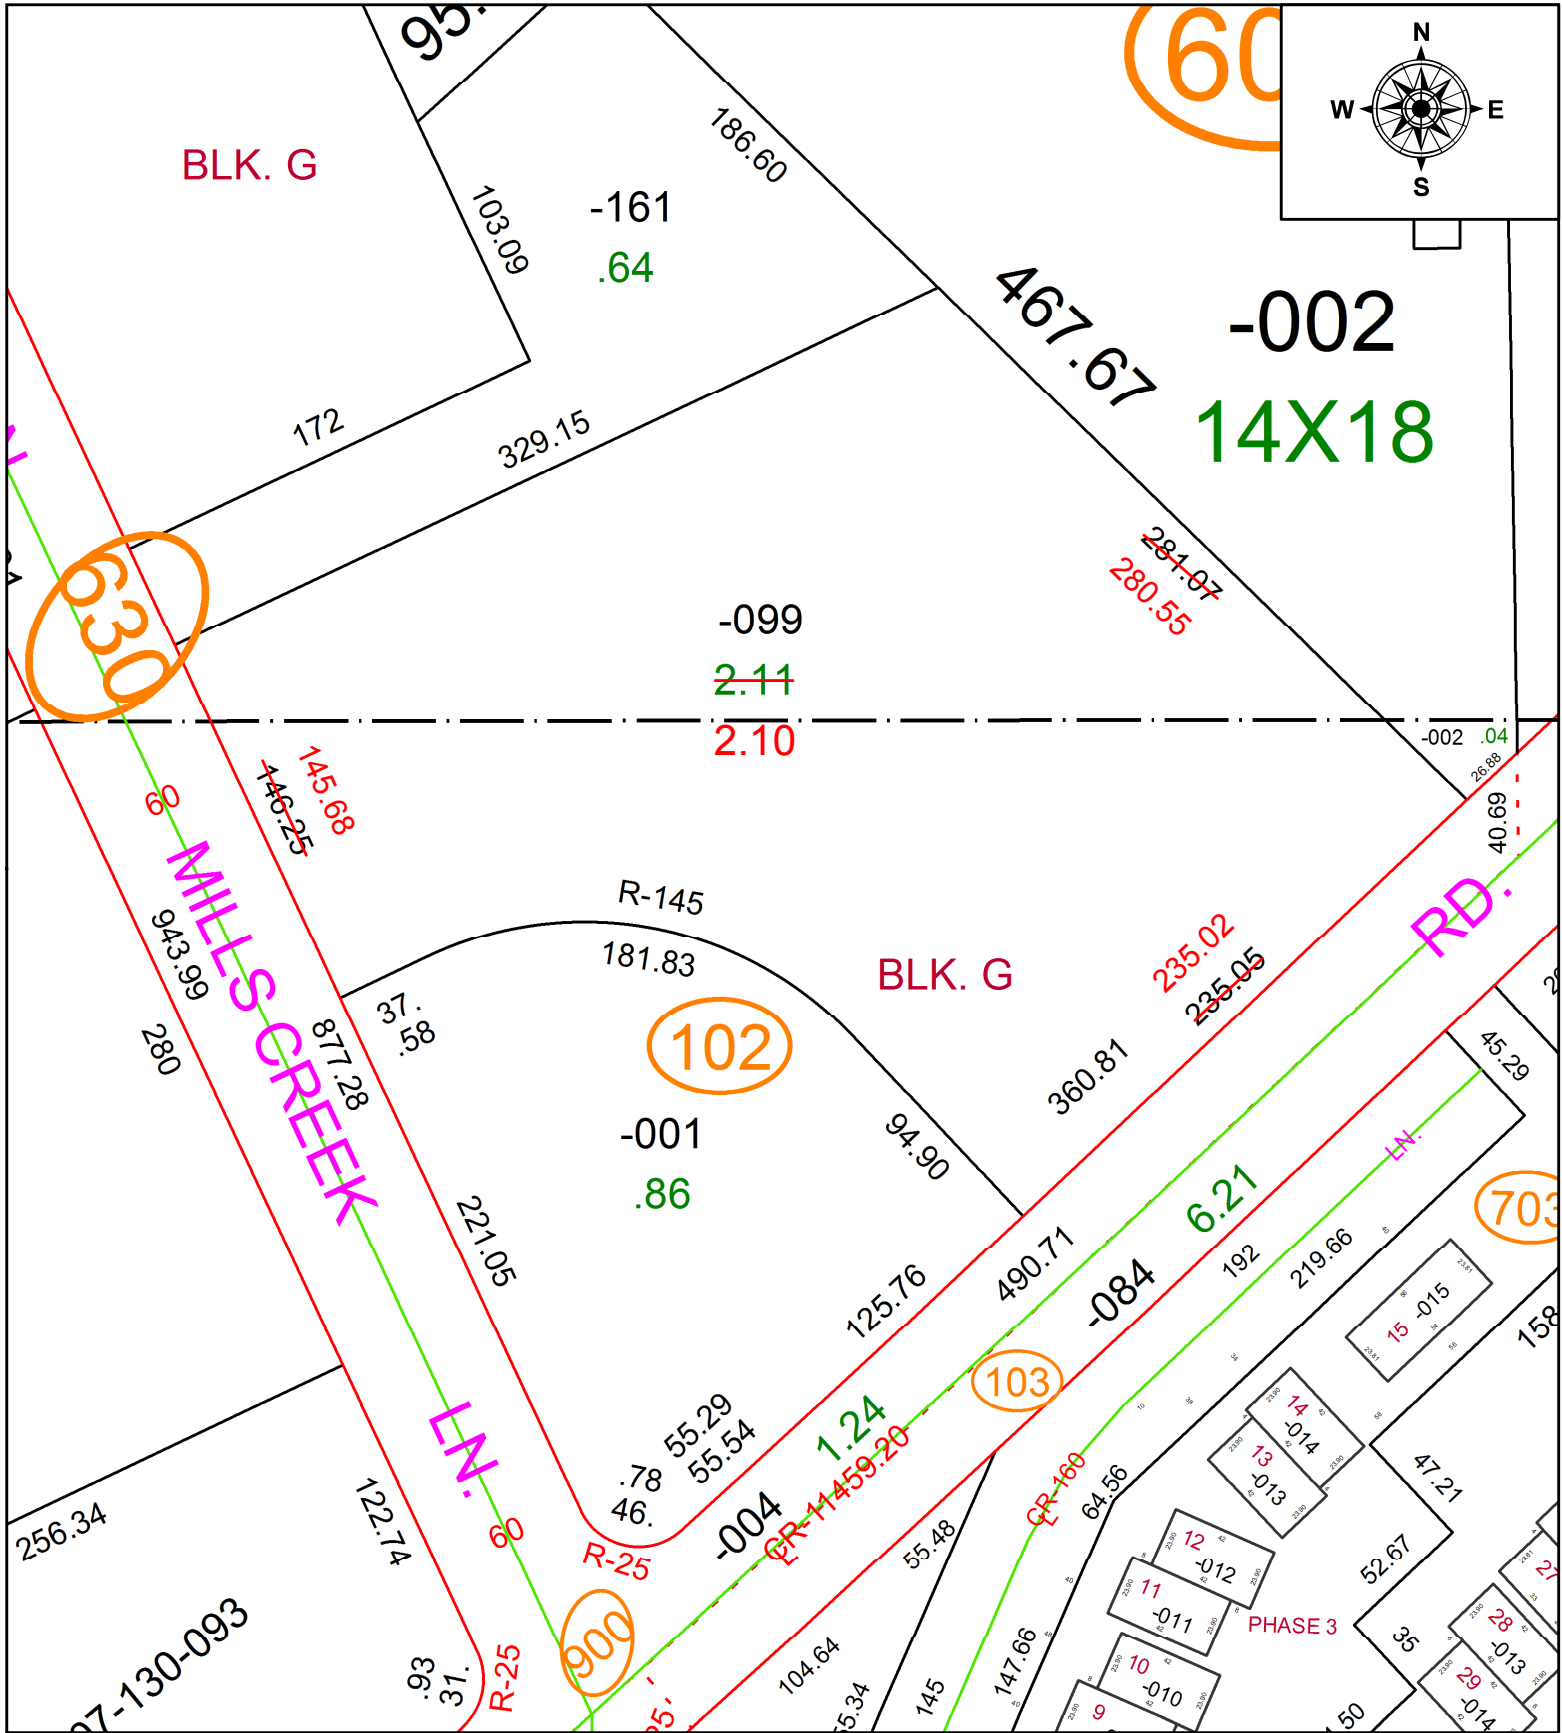

**SPLITS/DEEDS PROCESSED**  
 LORAIN COUNTY TAX MAP DEPARTMENT  
 226 MIDDLE AVE. ELYRIA, OH

**SURVEYED BY:** MICHAEL A. STRAUB  
**CLOSURE:** 1: 997919  
**MAP PAGE(S):** 07-00-006  
**APPROVED BY:** AC **DATE:** 9/3/2021  
**SCALE:** 1" = 75 **PRIOR INSTRUMENT:** 2011- 0363482